



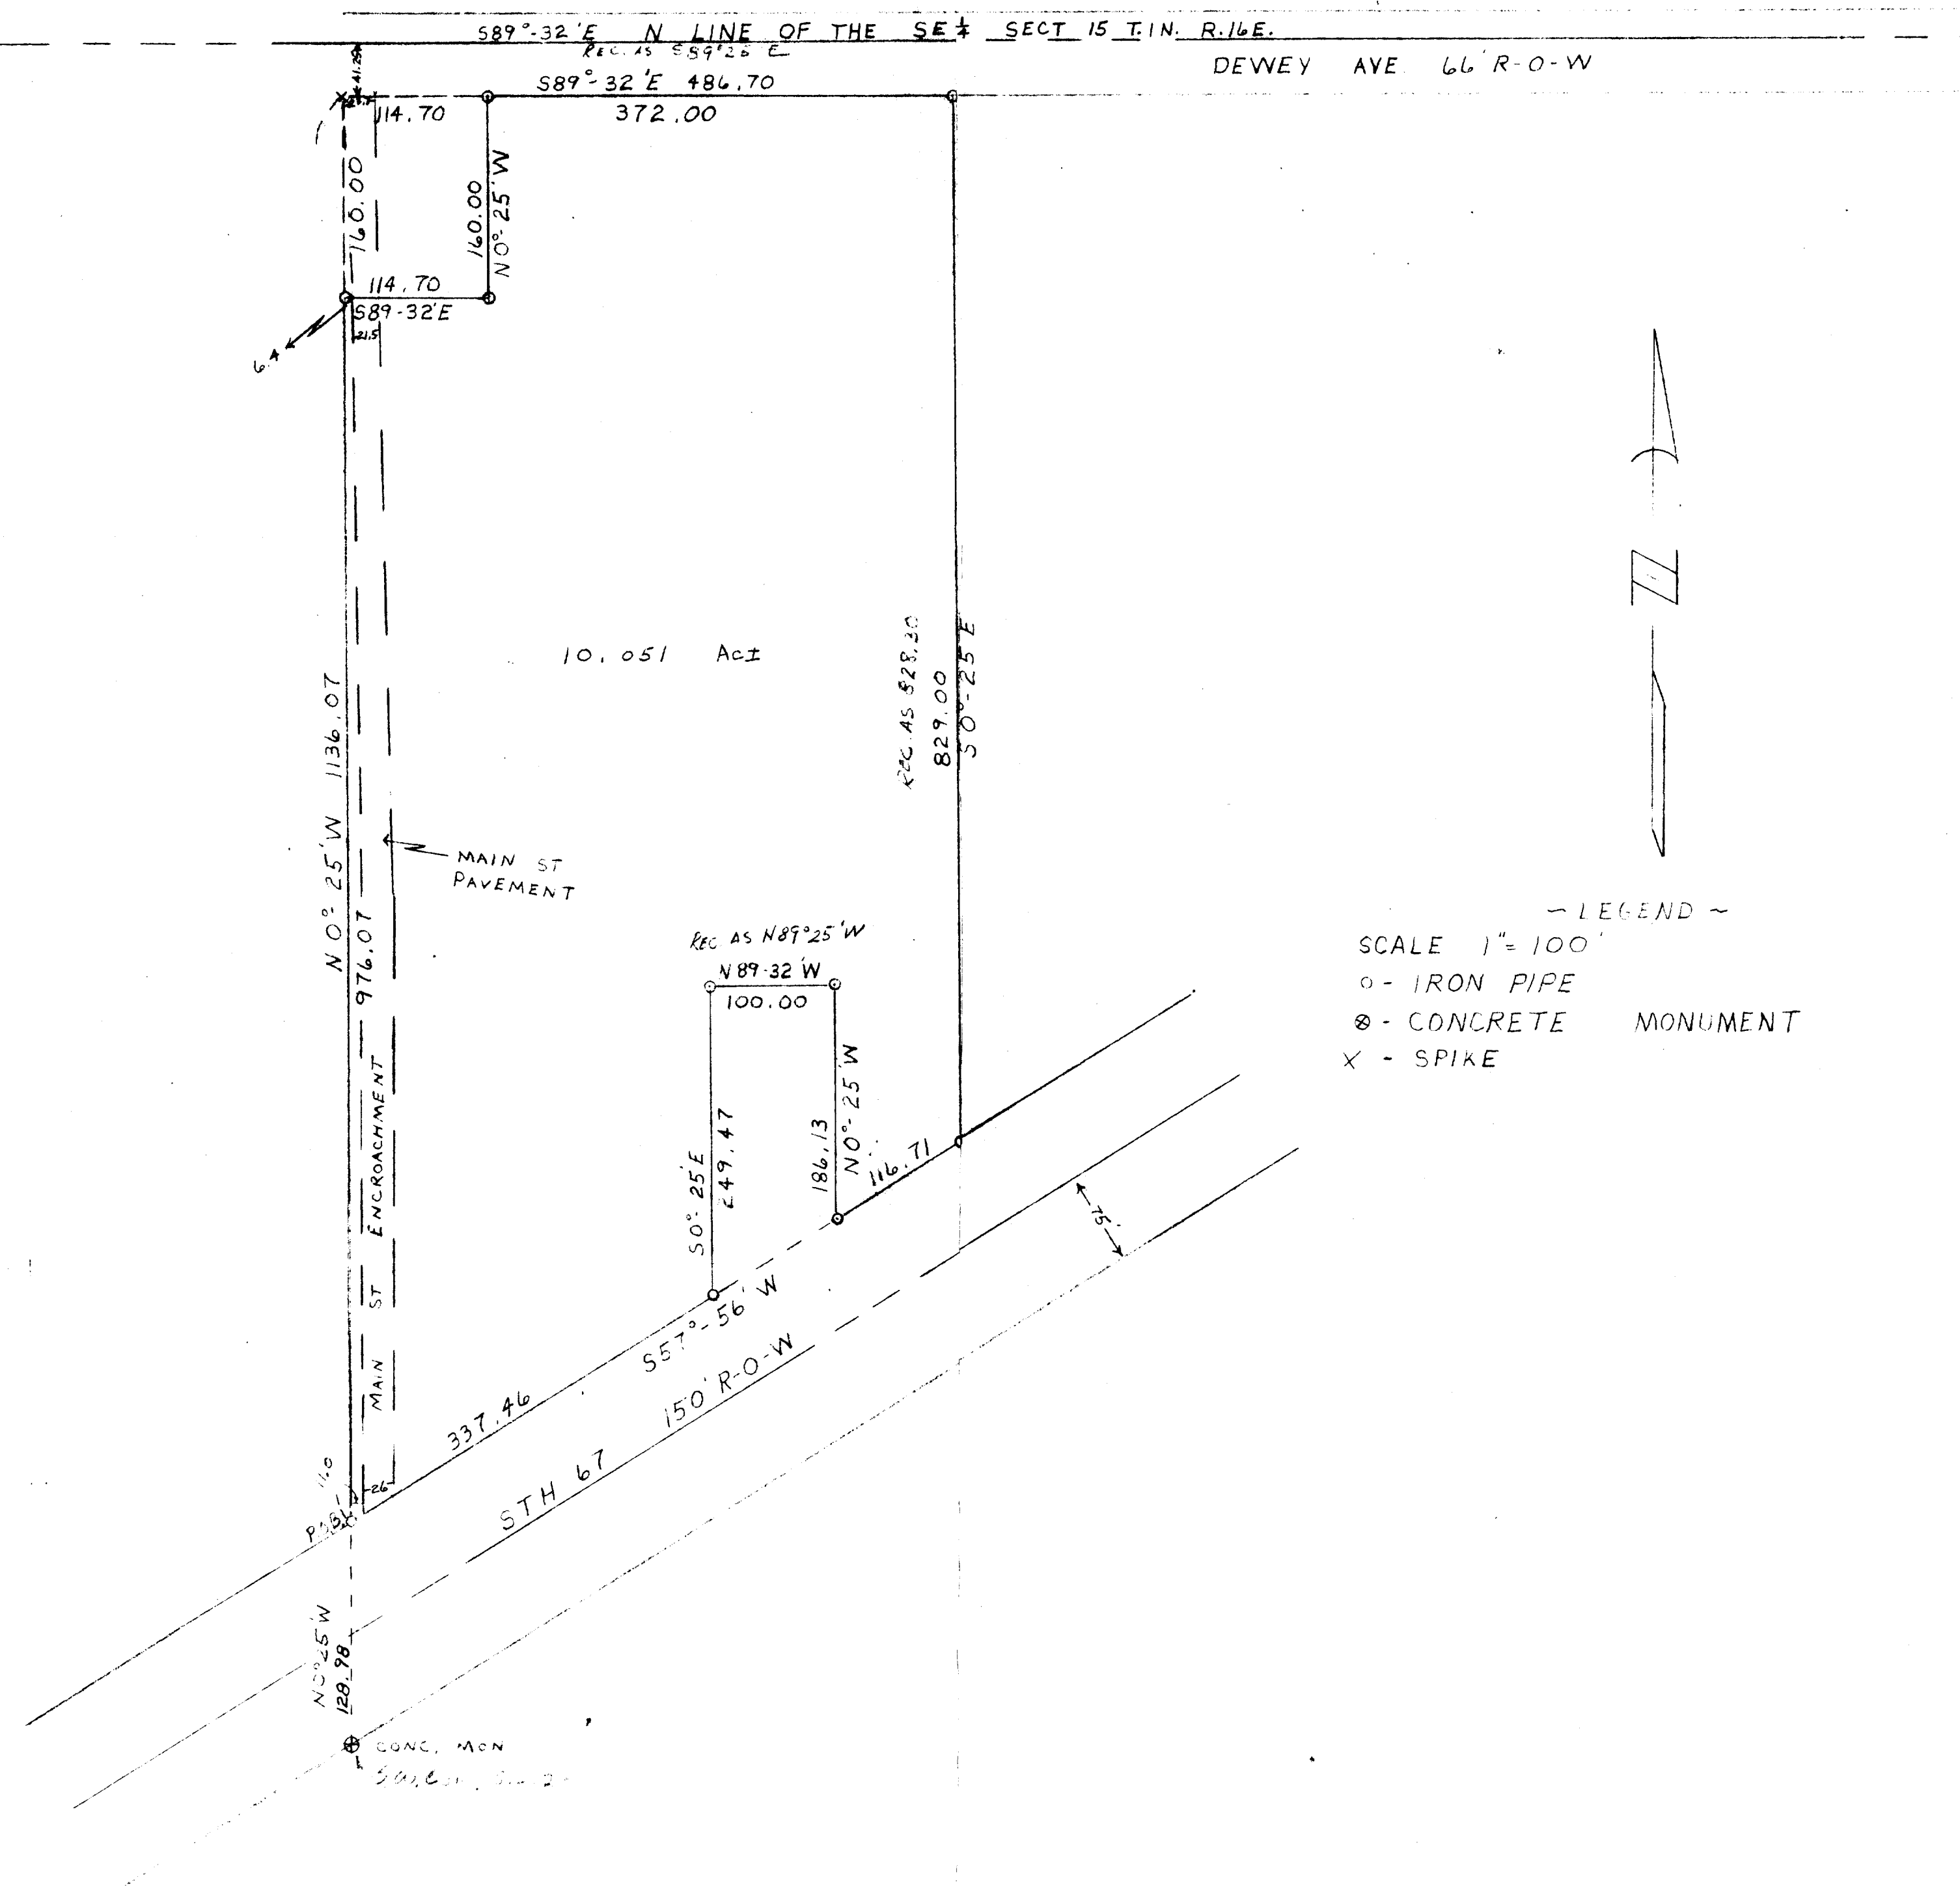

~ LEGEND ~
 SCALE 1" = 100'
 O - IRON PIPE
 X - CONCRETE MONUMENT
 X - SPIKE

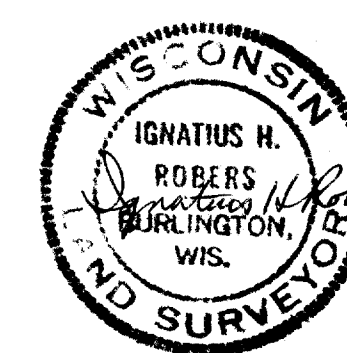

PLAT OF SURVEY OF PART OF OUTLOT 20 TO THE VILLAGE OF FONTANA-ON-GENEVA LAKE, WALWORTH COUNTY, WISCONSIN			
DATE Nov 11 1971	ROBERTS & FISCHER, INC. CONSULTING ENGINEERS 116 E. CHESTNUT ST. BURLINGTON, WIS. (414) 763-2652	JOB NO. T1152	CHECKED
SCALE 1" = 100'			SHEET
DRAWN JES			1 OF
REVISED			

ROBERS & FISCHER, INC.
CONSULTING ENGINEERS AND LAND SURVEYORS

116 E. CHESTNUT STREET
BURLINGTON, WISCONSIN 53105
PHONE 414-763-2652

116 N. MAIN STREET
WALWORTH, WISCONSIN 53190
PHONE 414-275-3744

IGNATIUS H. ROBERS, P.E.

CHARLES R. FISCHER, P.E.

DESCRIPTION OF SURVEY NO. 71152

A part of Outlot 20 to the Village of Pontana on Geneva Lake, Walworth County, Wisconsin, described as follows to wit:
Commencing at the concrete monument at the SW corner of said Outlot 20, thence North 0°25' West along said West line of said Outlot 128.98 feet to the Northerly line of State Trunk Highway 67 (formerly State Trunk Highway 36) and the place of beginning; thence continue North 0°25' West along West line of said Outlot a distance of 976.07 feet, thence South 89°32' East parallel with the North line of the SE 1/4 of Section 15, 114.70 feet, thence North 0°25' West 160.00 feet, thence South 89°32' East 372.00 feet, thence South 0°25' East 629.00 feet to the Northerly line of State Trunk Highway 67, thence South 57°56' West along said Northerly line 116.71 feet, thence North 0°25' West 186.13 feet, thence North 89°32' West 100.00 feet, thence South 0°25' East 249.47 feet to the Northerly line of State Trunk Highway 67, thence South 57°56' West along said highway 337.46 feet to the point of beginning.

Containing 10.051 acres of land more or less.

Subject to Main Street right-of-way.

Ignatius H. Rober, PLS
ROBERS & FISCHER, INC.
November 11, 1971

5-207