


# Plat of Survey

of


**Unit No. 211 of Abbey Springs Condominium No. 5,**  
located in the Southwest 1/4 of Section 18, Town 1 North, Range 17  
East, Village of Fontana-on-Geneva Lake, Walworth County, Wisconsin.

Surveyed for:

**Godfrey, Leibsle, Conover, Blackburn & Howarth, S.C.**  
11 North Wisconsin Street    \*\* Post Office Box 260  
Elkhorn, Wisconsin. 53121

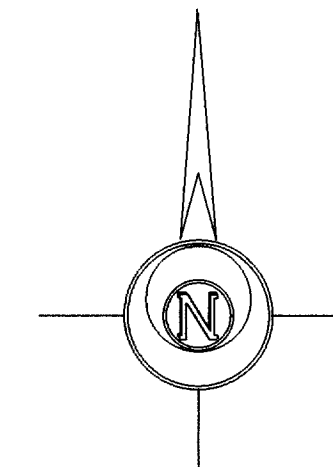

Bearings reference to the plat of  
Abbey Springs Condominium No. 5.

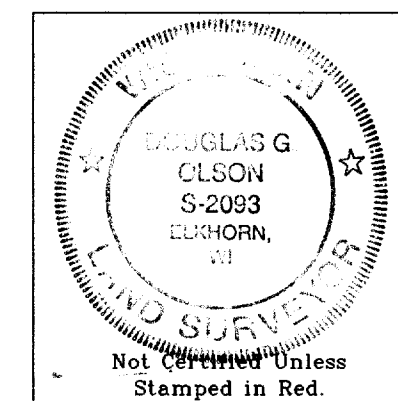

Notes: 1) This survey plat is not  
certified unless signed  
and sealed in red ink.

2) This survey is subject to Wisconsin lien laws.  
This Plat of Survey is the notice of intent  
to file lien. Lien waiver required.


Copyright © 2002 by Jensen & Olson Land Surveying, LLC.

All rights reserved. No part of this survey plat may be reproduced  
or transmitted in any form by any means - graphic, electronic, or  
mechanical, including photocopying, tracing, or information storage  
and retrieval systems - without permission in writing from Douglas  
G. Olson, Jensen & Olson Land Surveying, LLC.

I hereby certify that I have surveyed the above described  
property and the map hereon is correct to the best of my professional  
knowledge and belief and shows the size and location of the property,  
its exterior boundaries, the location and dimensions of all visible  
structures thereon, boundary fences, apparent easements and roadways  
and visible encroachments, if any.  
This survey is made for the exclusive use of the present owners  
of property, and also those who purchase, mortgage or guarantee title  
thereto, within one year from the date hereof.

Douglas G. Olson  
Wisconsin Registered Land Surveyor - 2093

Survey Date: August 30, 2002.  
Revisions:

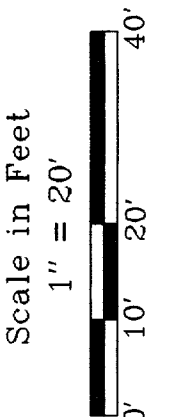

**Jensen & Olson Land Surveying, LLC**

45 South Wisconsin Street    P.O. Box 322  
Elkhorn, Wisconsin. 53121  
Telephone (262) 723-3434  
Facsimile (262) 723-8044

Legend

- Found in Pipe
- Found in Road
- Found in P.K. Nail
- Recorded Information
- Utility Pedestal
- Hydrant
- Manhole
- Water Valve
- Concrete Surface
- Asphalt

Sheet 1 of 1 Sheets

Job Reference Number

2002.155

2002.155