


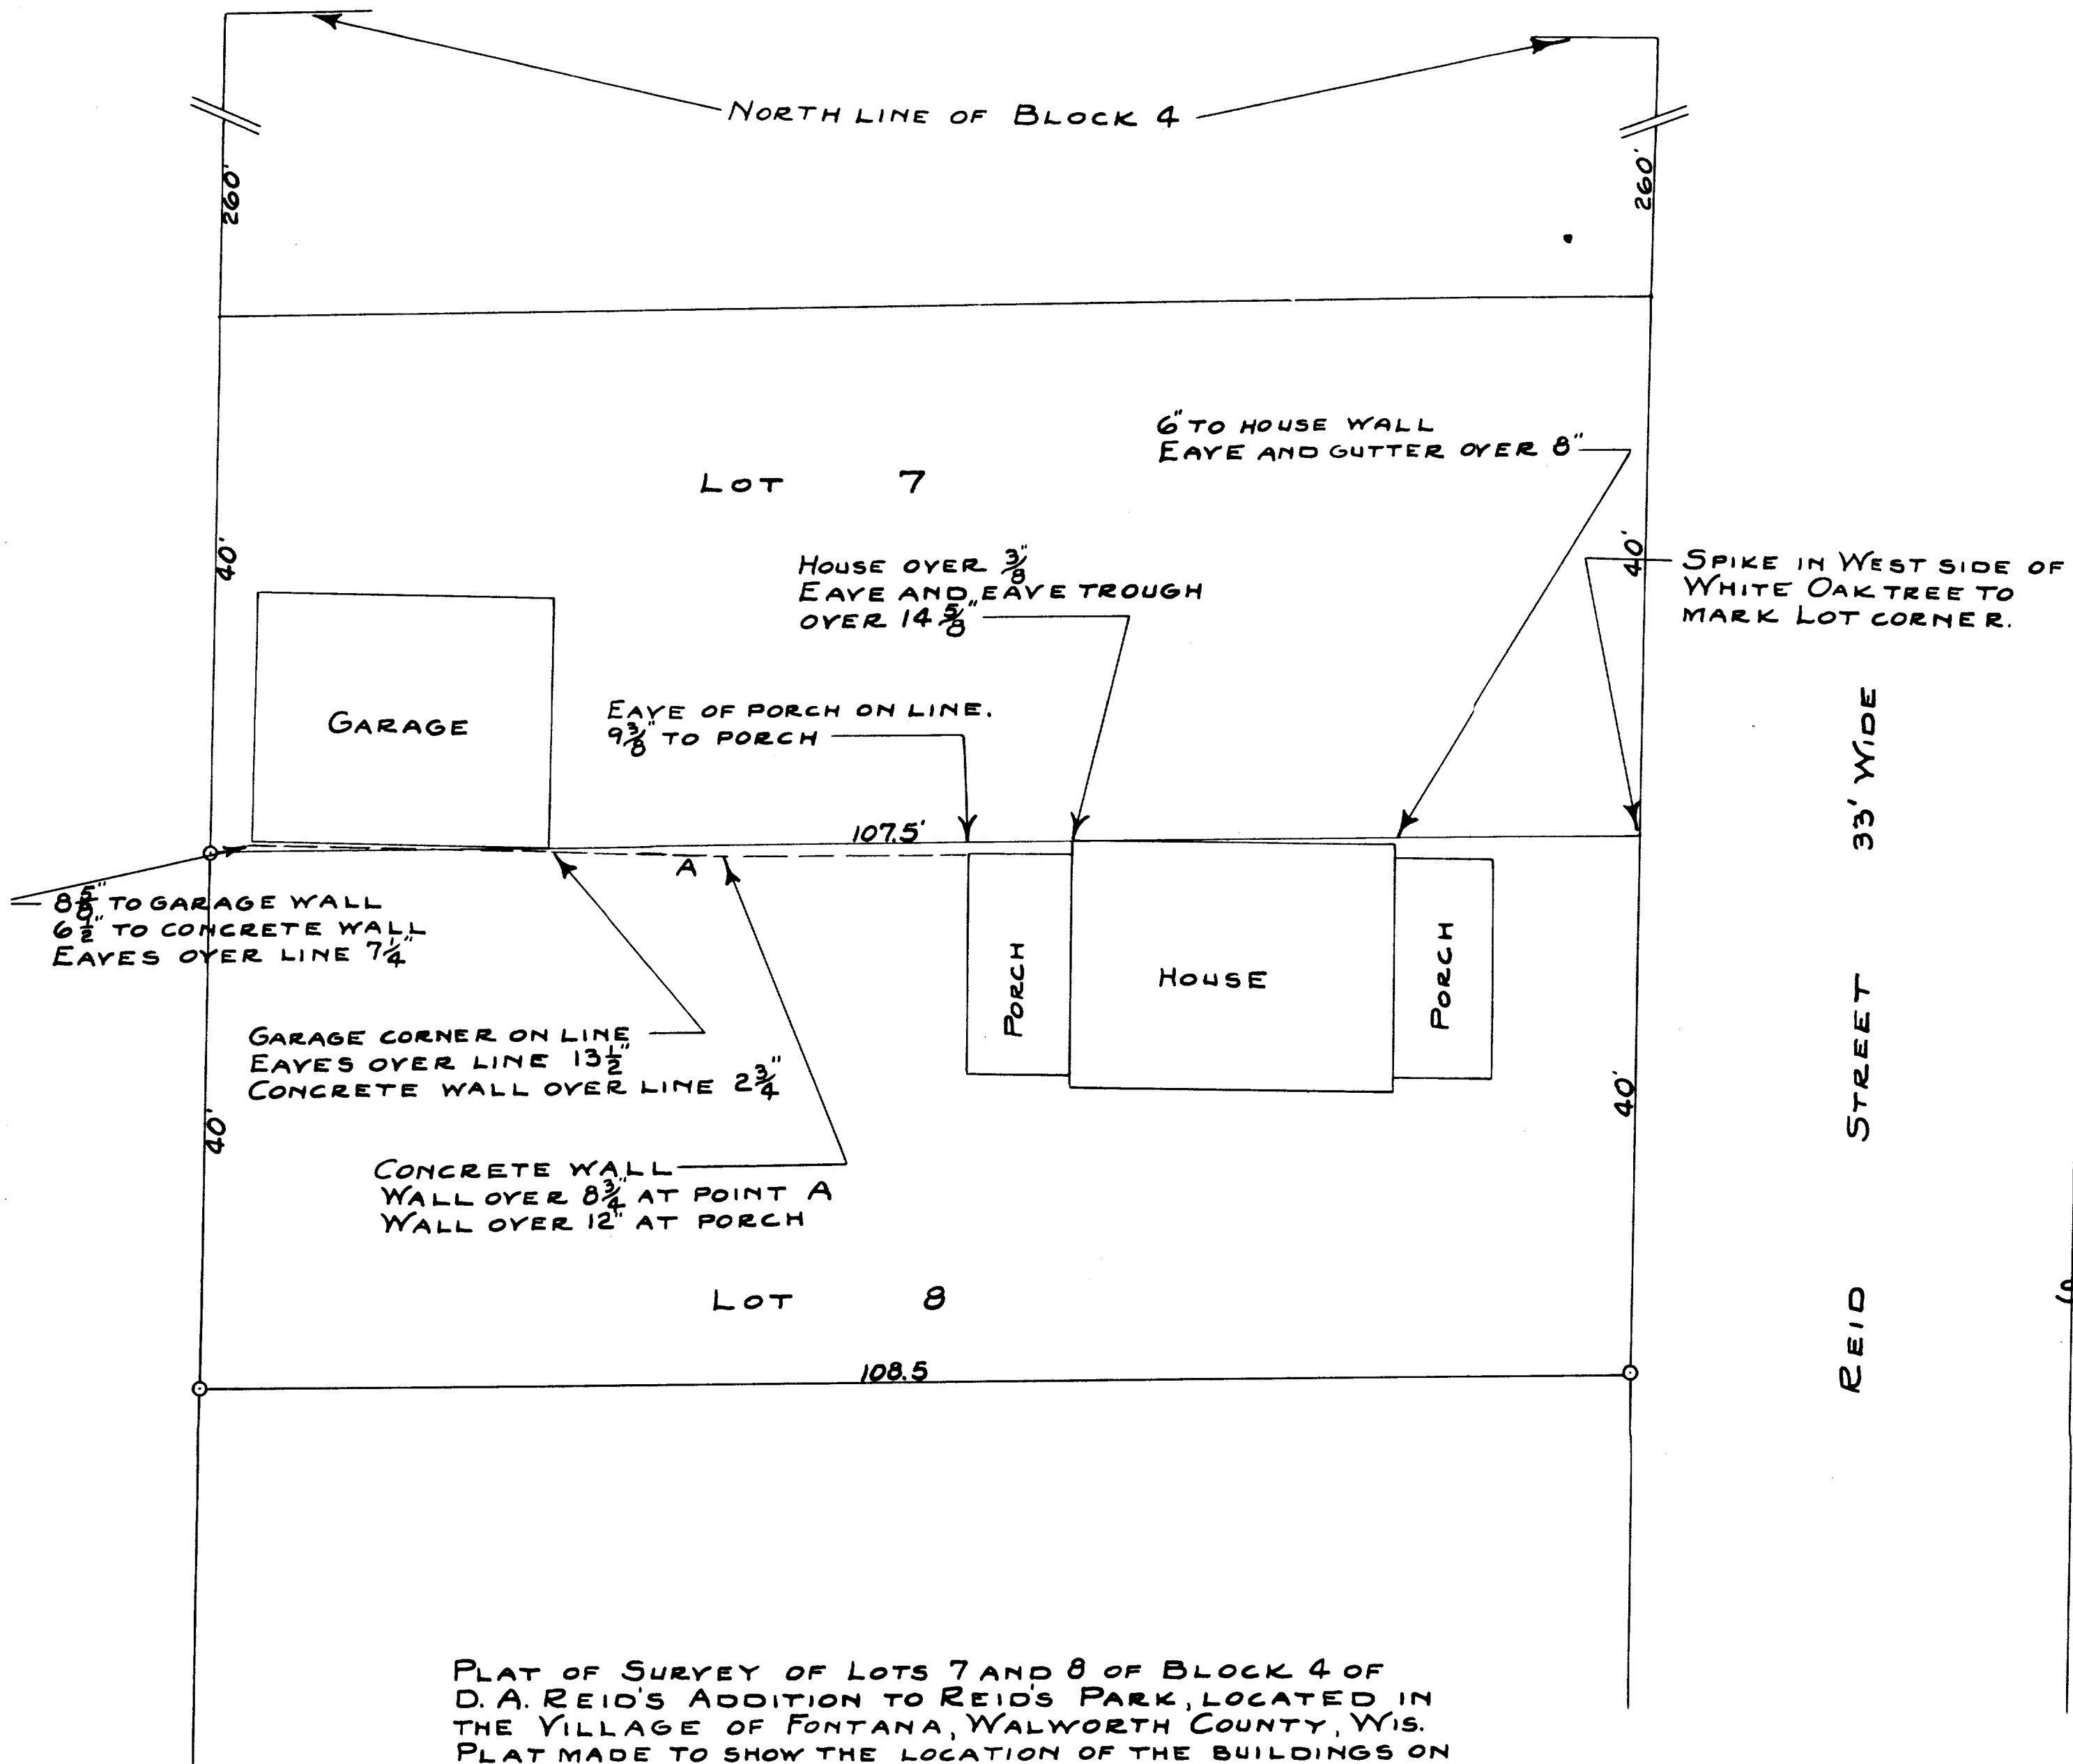

SCALE 1"=10'  
O-IRON PIPE

PLAT OF SURVEY OF LOTS 7 AND 8 OF BLOCK 4 OF  
D. A. REID'S ADDITION TO REID'S PARK, LOCATED IN  
THE VILLAGE OF FONTANA, WALWORTH COUNTY, WIS.  
PLAT MADE TO SHOW THE LOCATION OF THE BUILDINGS ON  
AND NEAR THE LINE BETWEEN LOTS 7 AND 8.