
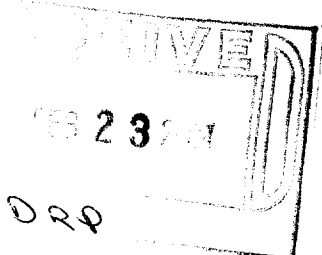


PLAT OF SURVEY

LOT 6, COUNTRY CLUB ESTATES ADDITION NO. 1, LOCATED
IN SECTION 14, TOWN 1 NORTH, RANGE 16 EAST, VILLAGE
OF FONTANA-ON-GENEVA LAKE, WALWORTH COUNTY,
WISCONSIN.

ORDERED BY: HOME DESIGN MFG. CORP.
N2002 HIGHWAY "67"
FONTANA, WI 53125

CLIENT REFERENCE: DOLORES SECOR

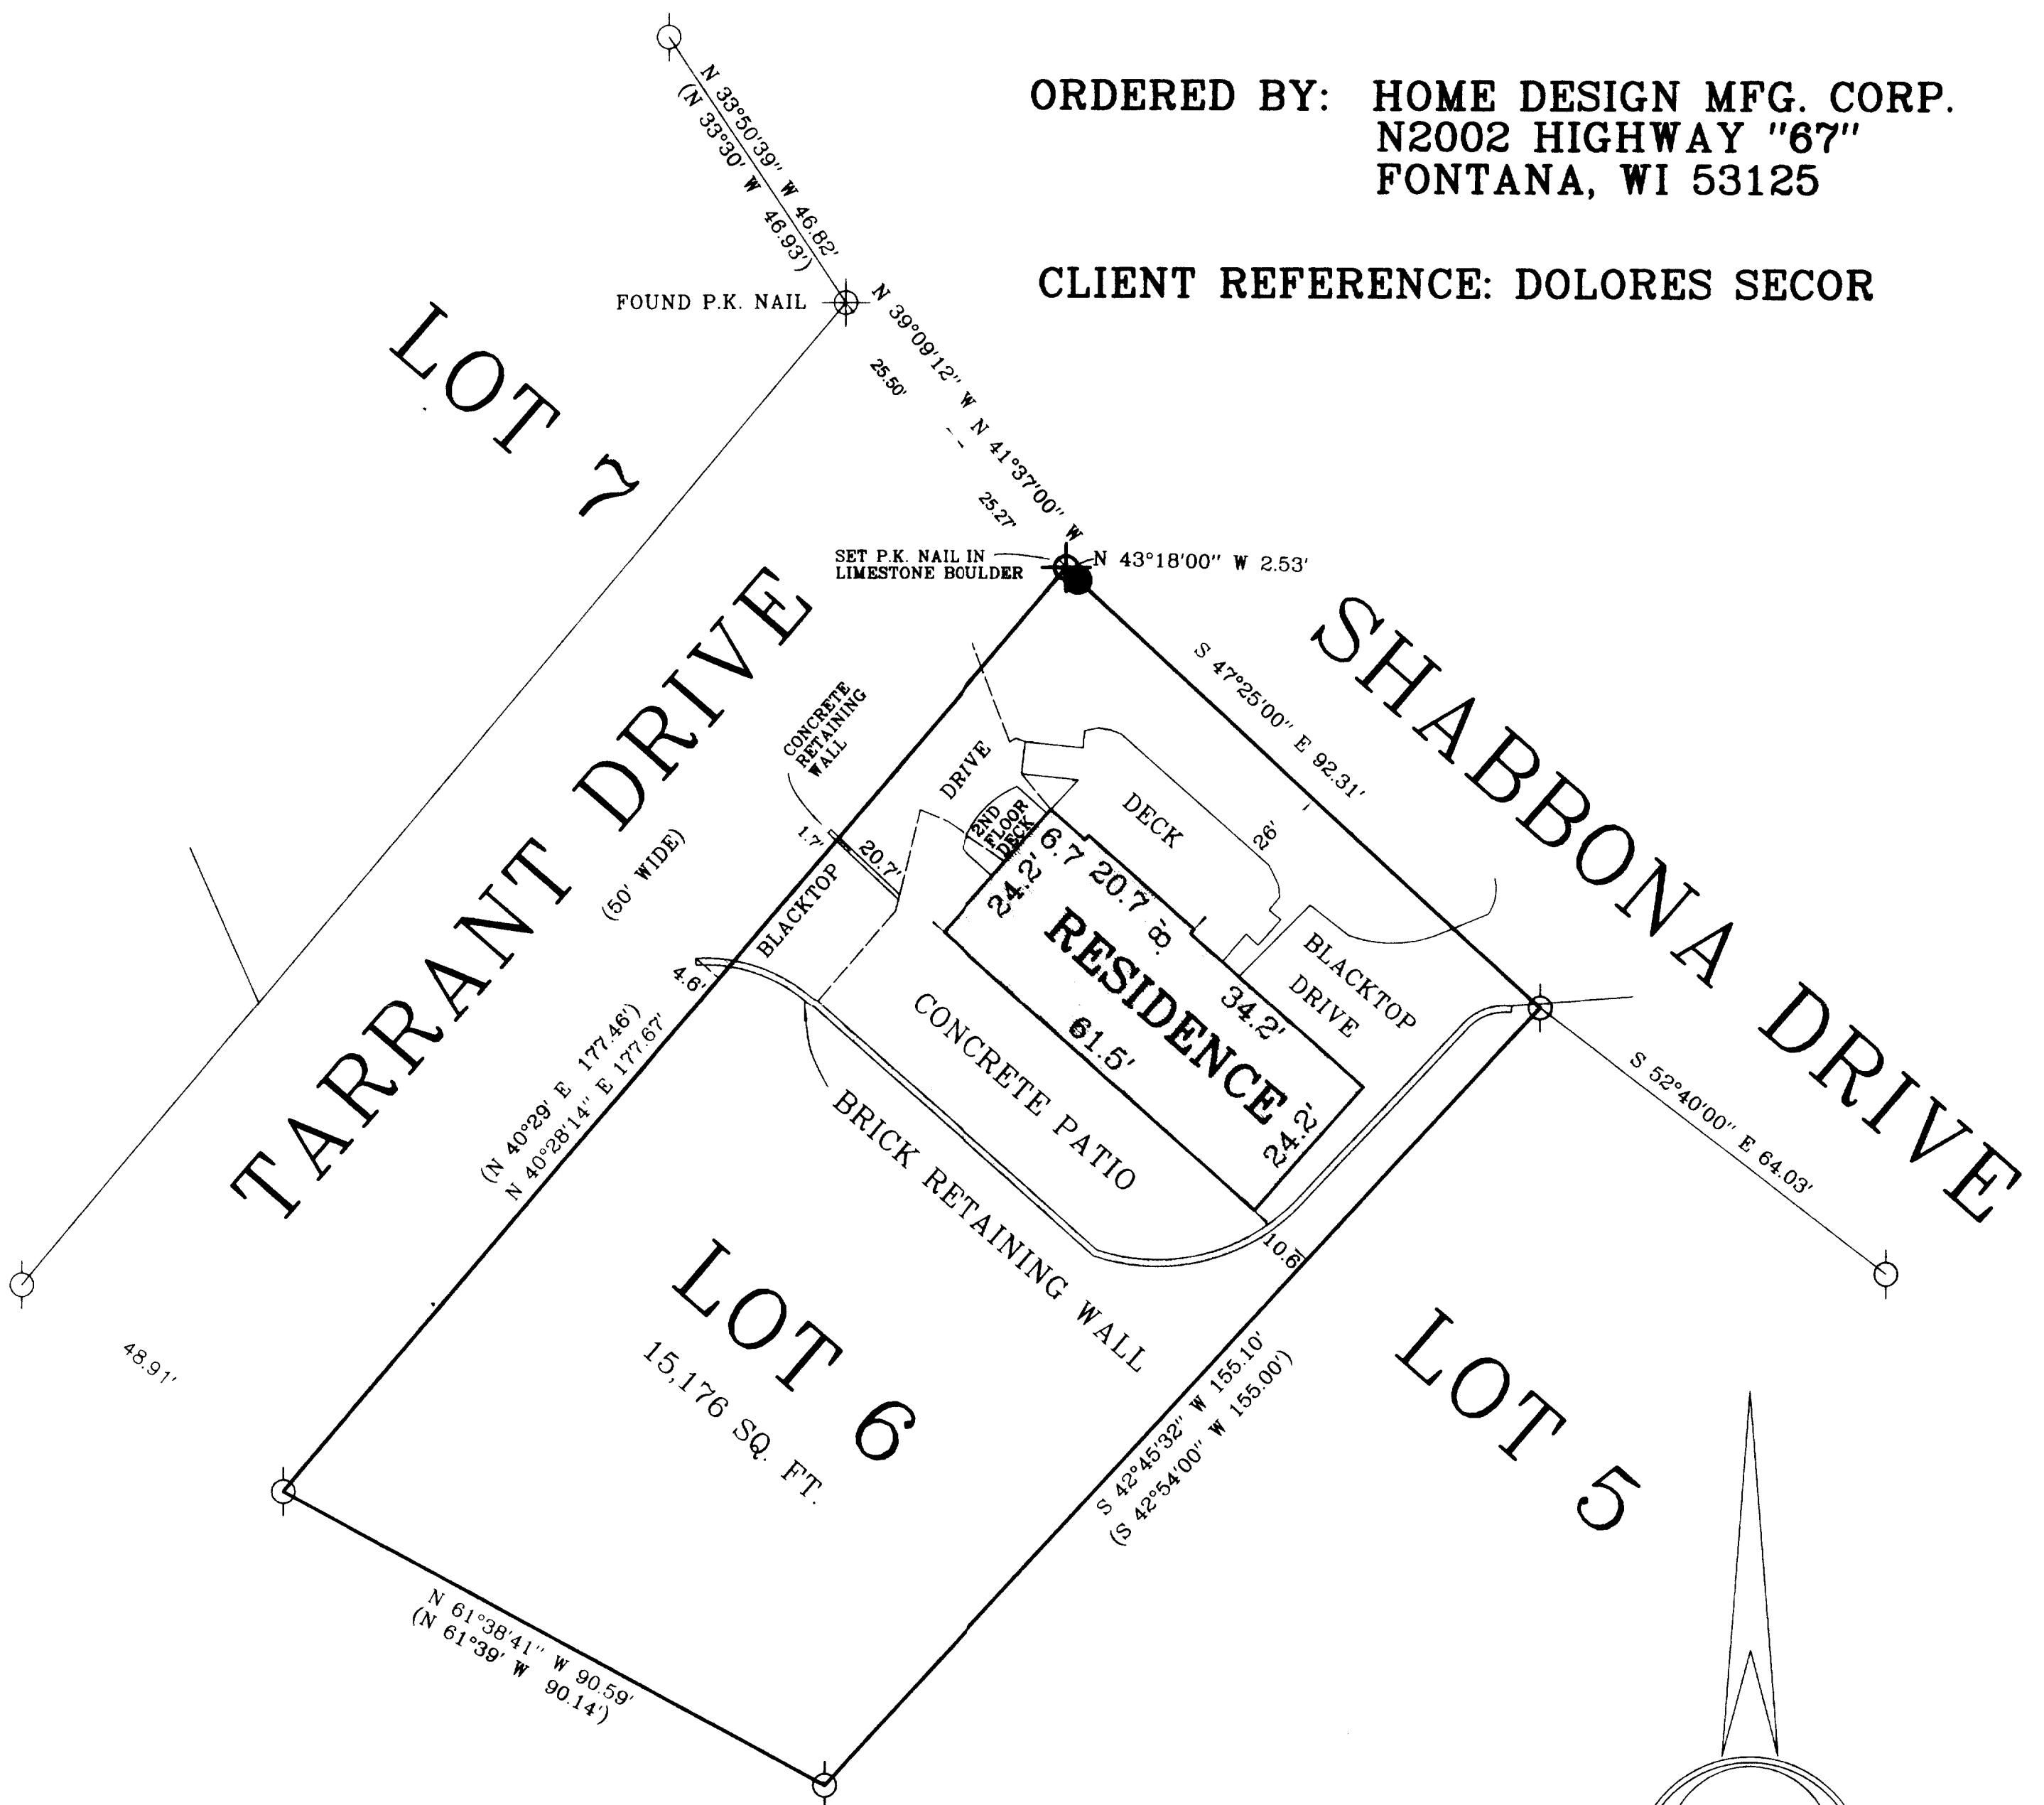

- LEGEND**
- FOUND IRON PIPE
 - FOUND IRON ROD
 - ⊗ FOUND BRASS CAPPED MONUMENT
 - ⊙ FOUND CONCRETE MONUMENT
 - ⊕ CHISEL CUT IN CONCRETE
 - SET IRON ROD, 24" LONG, WEIGHING 1.5 LBS./LINEAL FT., 3/4" DIA.
 - SET IRON ROD, 30" LONG, WEIGHING 4.3 LBS./LINEAL FT., 1-11/16" DIA.
 - (x x x) RECORDED AS DIMENSION
 - EXISTING FENCE
- SCALE: 1" = 20' FEET



SCALE: 1" = 20 FEET

"I hereby certify that the above described property has been surveyed by me or under my direction and that the above map is a true representation thereof and shows the size and location of the property, its exterior boundaries, the location of all visible structures and dimensions of all principal buildings thereon, boundary fences, apparent easements, roadways and visible encroachments, if any."

"This survey is made for the use of the present owners of the property, and also those who purchase, mortgage or guarantee the title thereto within one year from date hereof."

Kenneth B. Abernathy, Jr.

KENNETH B. ABERNATHY, JR.
WISCONSIN REGISTERED
LAND SURVEYOR S-1594

Date: AUGUST 18, 2003 Job No. 03.809