


AS-BUILT MAPPING

LOT 8 OF BLOCK H COUNTRY CLUB ESTATES

LOCATED IN SECTIONS 14 AND 23, TOWN 1 NORTH, RANGE 16 EAST,
WALWORTH COUNTY, WISCONSIN

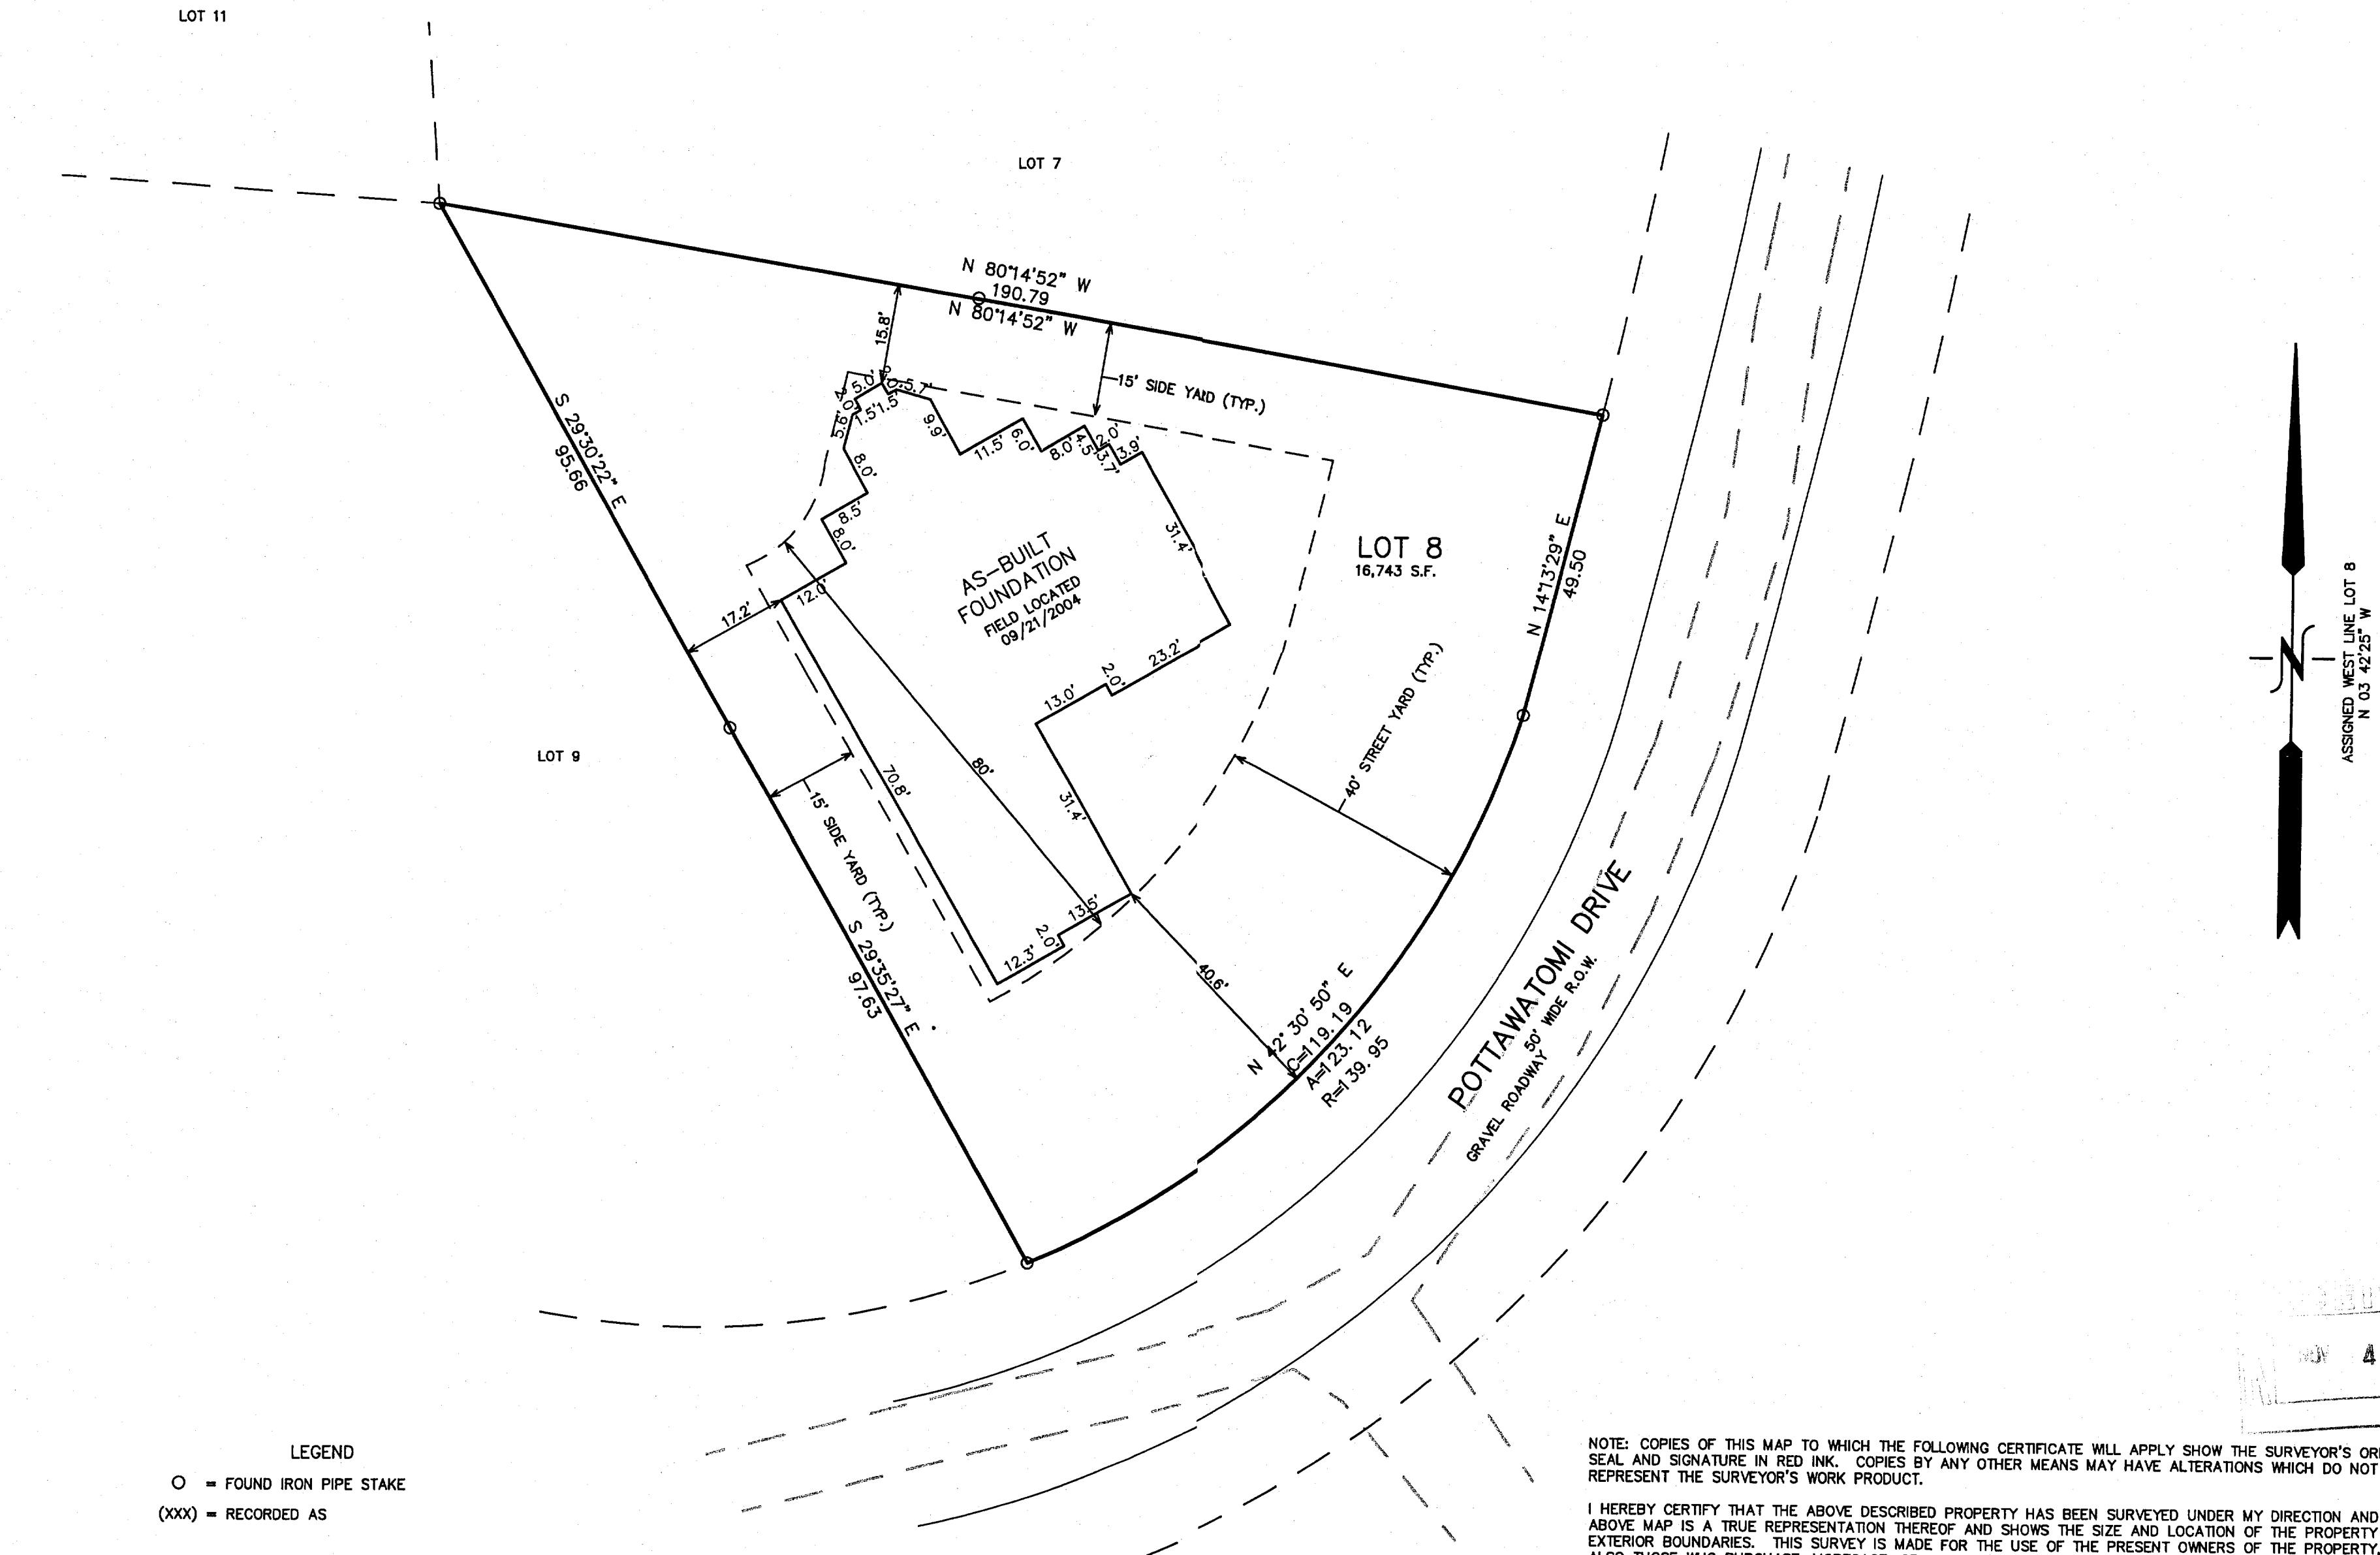

— WORK ORDERED BY —
DENNIS CONDON
CONDON CONSTRUCTION, INC.
4329 NORTH FOREST HILLS BLVD.
JANESVILLE, WI 53545

FARRIS, HANSEN & ASSOCIATES, INC.
ENGINEERING — ARCHITECTURE — SURVEYING
7 RIDGWAY COURT P.O. BOX 437
ELKHORN, WISCONSIN 53121
OFFICE: (262) 723-2098 FAX: (262) 723-5886

REVISIONS

PROJECT NO.
4031.08
DATE:
09/22/2004
SHEET NO.
1 OF 1

SEP 22 2004

9/22/2004 X:\Projects\4031\Doc\ASBLT_8

SC03 00123

005-2235