PREPARED FOR: BOB SOLFI


BOB SOLFISBURG 365 SYLVAN LANE VILLAGE OF FONTANA WI. 53125

PLAT OF SURVEY

J.K. SURVEYING INC. N3705 WILLOWBEND LANE LAKE GENEVA, WI, 53147 262-248-3697

- OF -

LOT 19 IN BUENA VISTA PARK BEING A SUBDIVISION LOCATED IN SECTIONS 11 AND 14 IN TOWN 1 NORTH, RANGE 16 EAST, VILLAGE OF FONTANA-ON-GENEVA-LAKE WALWORTH COUNTY, WISCONSIN.

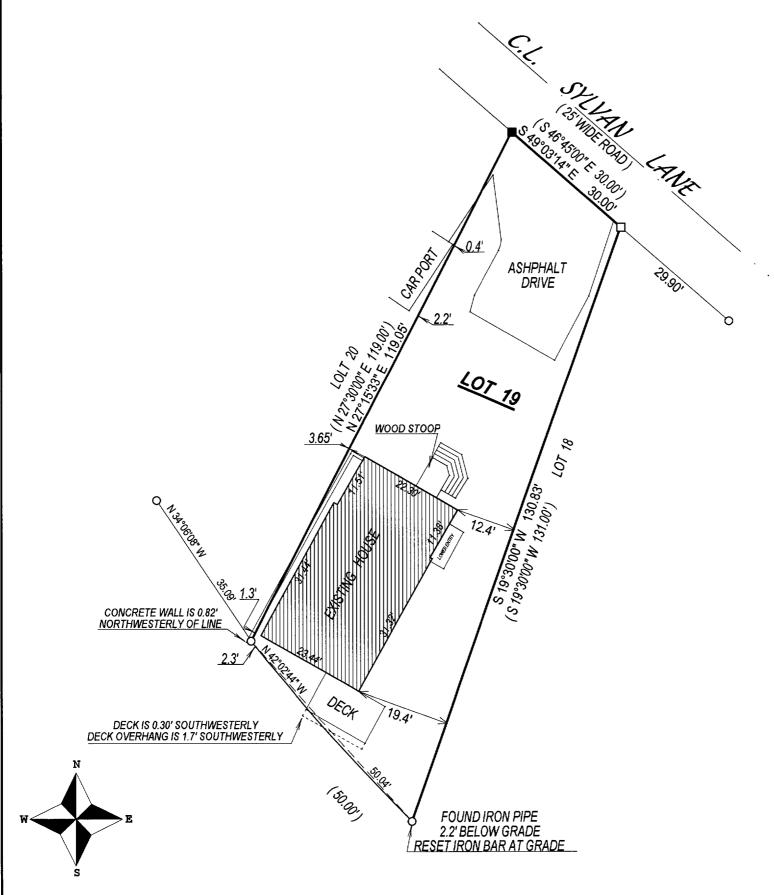

()= recorded as

□ = found iron bar

= found iron pipe

= set iron pipe

= set iron bar

SCALE 1" = 20'

COMPARE LEGAL DESCRIPTION ABOVE AND DRAWING WITH DEED. FOR BUILDING RESTRICTIONS AND EASEMENTS NOT SHOWN, REFER TO DEED, ABSTRACT SOURCES AND LOCAL MUNICIPAL CODES. NOTIFY THE SURVEYOR IMMEDIATELY OF ANY DISCREPANCY.

JOB # 04-434

TAX ID # SBV00012

"I hereby certify that I have surveyed the above described property and that the above map, to the best of my knowledge and belief, is a true representation thereof and shows the size and location of all visible structures, apparent easements and encroachments any."

This survey is made for the present owners of the property, and those who purchase, mortgage, or guarentee the title thereto, within one year from the date hereof.

JOHN P.

KROTT

* S-2258

* LAKE GENEVA

VVIS.

VVIS.

JOHN KROTT S - 2258
Wisconsin Registered Land Surveyor
(original if signed in red)

DATED THIS THE 20th DAY OF AUGUST 2004.