
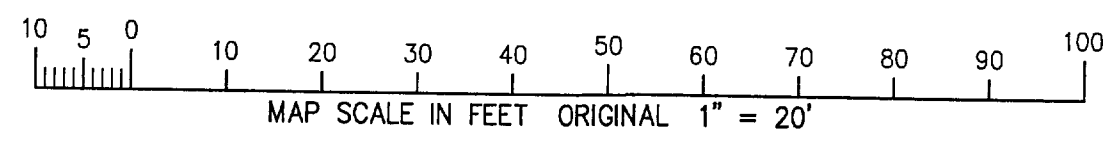


PLAT OF SURVEY
LOT 13 OF
COUNTRY CLUB ESTATES ADDITION "K"

LOCATED IN FONTANA-ON-GENEVA LAKE
WALWORTH COUNTY, WISCONSIN

ASSIGNED SE LINE LOT 13
S 30°14'57" W

LEGEND
● = FOUND IRON REBAR STAKE
○ = FOUND IRON PIPE STAKE
(xxx) = RECORDED AS
NOTE: MONTUAGE DRIVE SHOWN AS TARRANT DRIVE
ON ORIGINAL SUBDIVISION PLAT

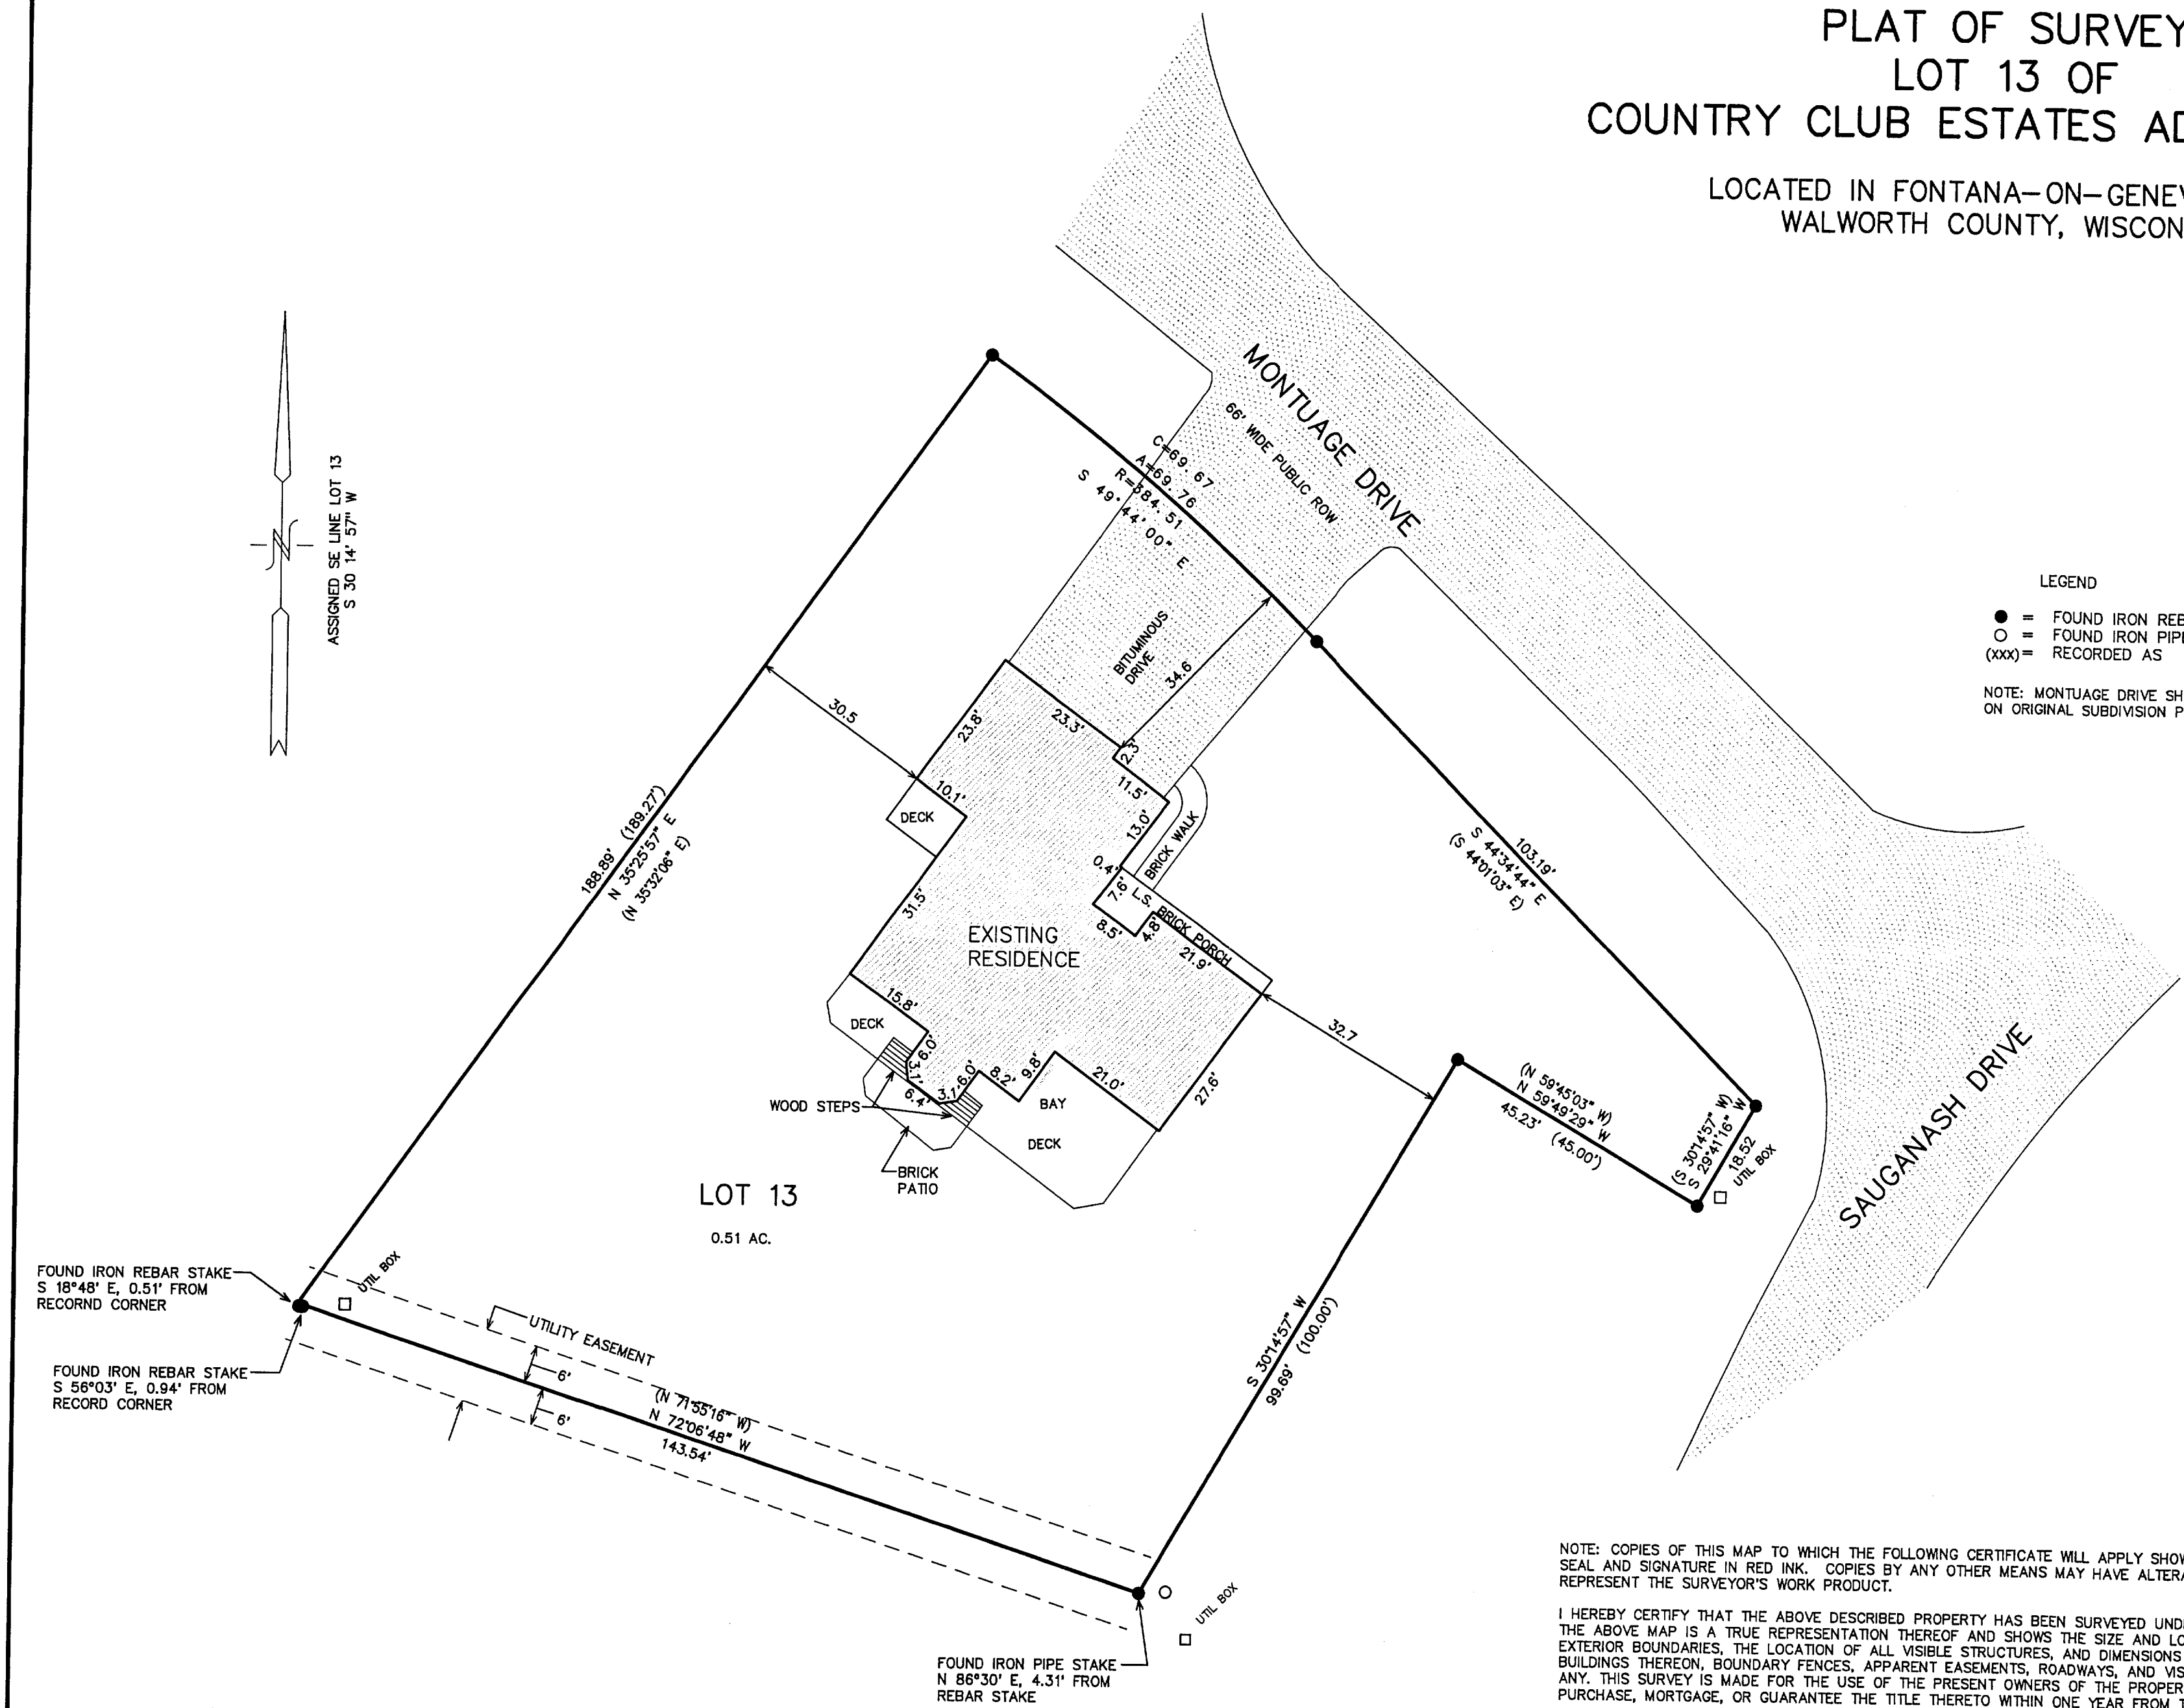


NOTE: COPIES OF THIS MAP TO WHICH THE FOLLOWING CERTIFICATE WILL APPLY SHOW SURVEYOR'S ORIGINAL SEAL AND SIGNATURE IN RED INK. COPIES BY ANY OTHER MEANS MAY HAVE ALTERATIONS WHICH DO NOT REPRESENT THE SURVEYOR'S WORK PRODUCT.

I HEREBY CERTIFY THAT THE ABOVE DESCRIBED PROPERTY HAS BEEN SURVEYED UNDER MY DIRECTION AND THAT THE ABOVE MAP IS A TRUE REPRESENTATION THEREOF AND SHOWS THE SIZE AND LOCATION OF THE PROPERTY, ITS EXTERIOR BOUNDARIES, THE LOCATION OF ALL VISIBLE STRUCTURES, AND DIMENSIONS OF ALL PRINCIPLE BUILDINGS THEREON, BOUNDARY FENCES, APPARENT EASEMENTS, ROADWAYS, AND VISIBLE ENCROACHMENTS, IF ANY. THIS SURVEY IS MADE FOR THE USE OF THE PRESENT OWNERS OF THE PROPERTY, AND ALSO THOSE WHO PURCHASE, MORTGAGE, OR GUARANTEE THE TITLE THERETO WITHIN ONE YEAR FROM THE DATE HEREOF.

DATED: 6-21-1999 RESURVEYED 11-22-2005

PETER S. GORDON R.L.S. 2101

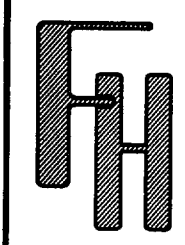

WORK ORDERED BY:
RAULAND AGENCY
PO BOX 159
WALWORTH, WISCONSIN

FARRIS, HANSEN & ASSOCIATES, INC.
Engineering, Architecture, Surveying
7 Ridgway Court P.O. Box 437
ELKHORN, WISCONSIN 53121
Office: (414) 723-2098
Fax: (414) 723-6886

REVISIONS

PROJECT NO.
5310
DATE:
06-21-99
SHEET NO.
1 OF 1

50TK-13

2005
smf
005-2352