

PREPARED FOR :  
BILL ROLANDER  
250 CHEROKEE RD.  
LAKE FOREST, IL 60045

PLAT OF SURVEY


J.K. SURVEYING INC.  
N3705 WILLOWBEND LANE  
LAKE GENEVA, WI, 53147  
262-248-3697

- OF -

LOTS 15, EXCEPTING THE EASTERLY 5 FEET THEREOF  
16 AND 17 IN BUENA VISTA PARK BEING A SUBDIVISION  
LOCATED IN SECTIONS 11 AND 14 IN TOWN 1 NORTH,  
RANGE 16 EAST, VILLAGE OF FONTANA-ON-GENEVA-LAKE  
WALWORTH COUNTY, WISCONSIN.

JUL 28 2006

8mf

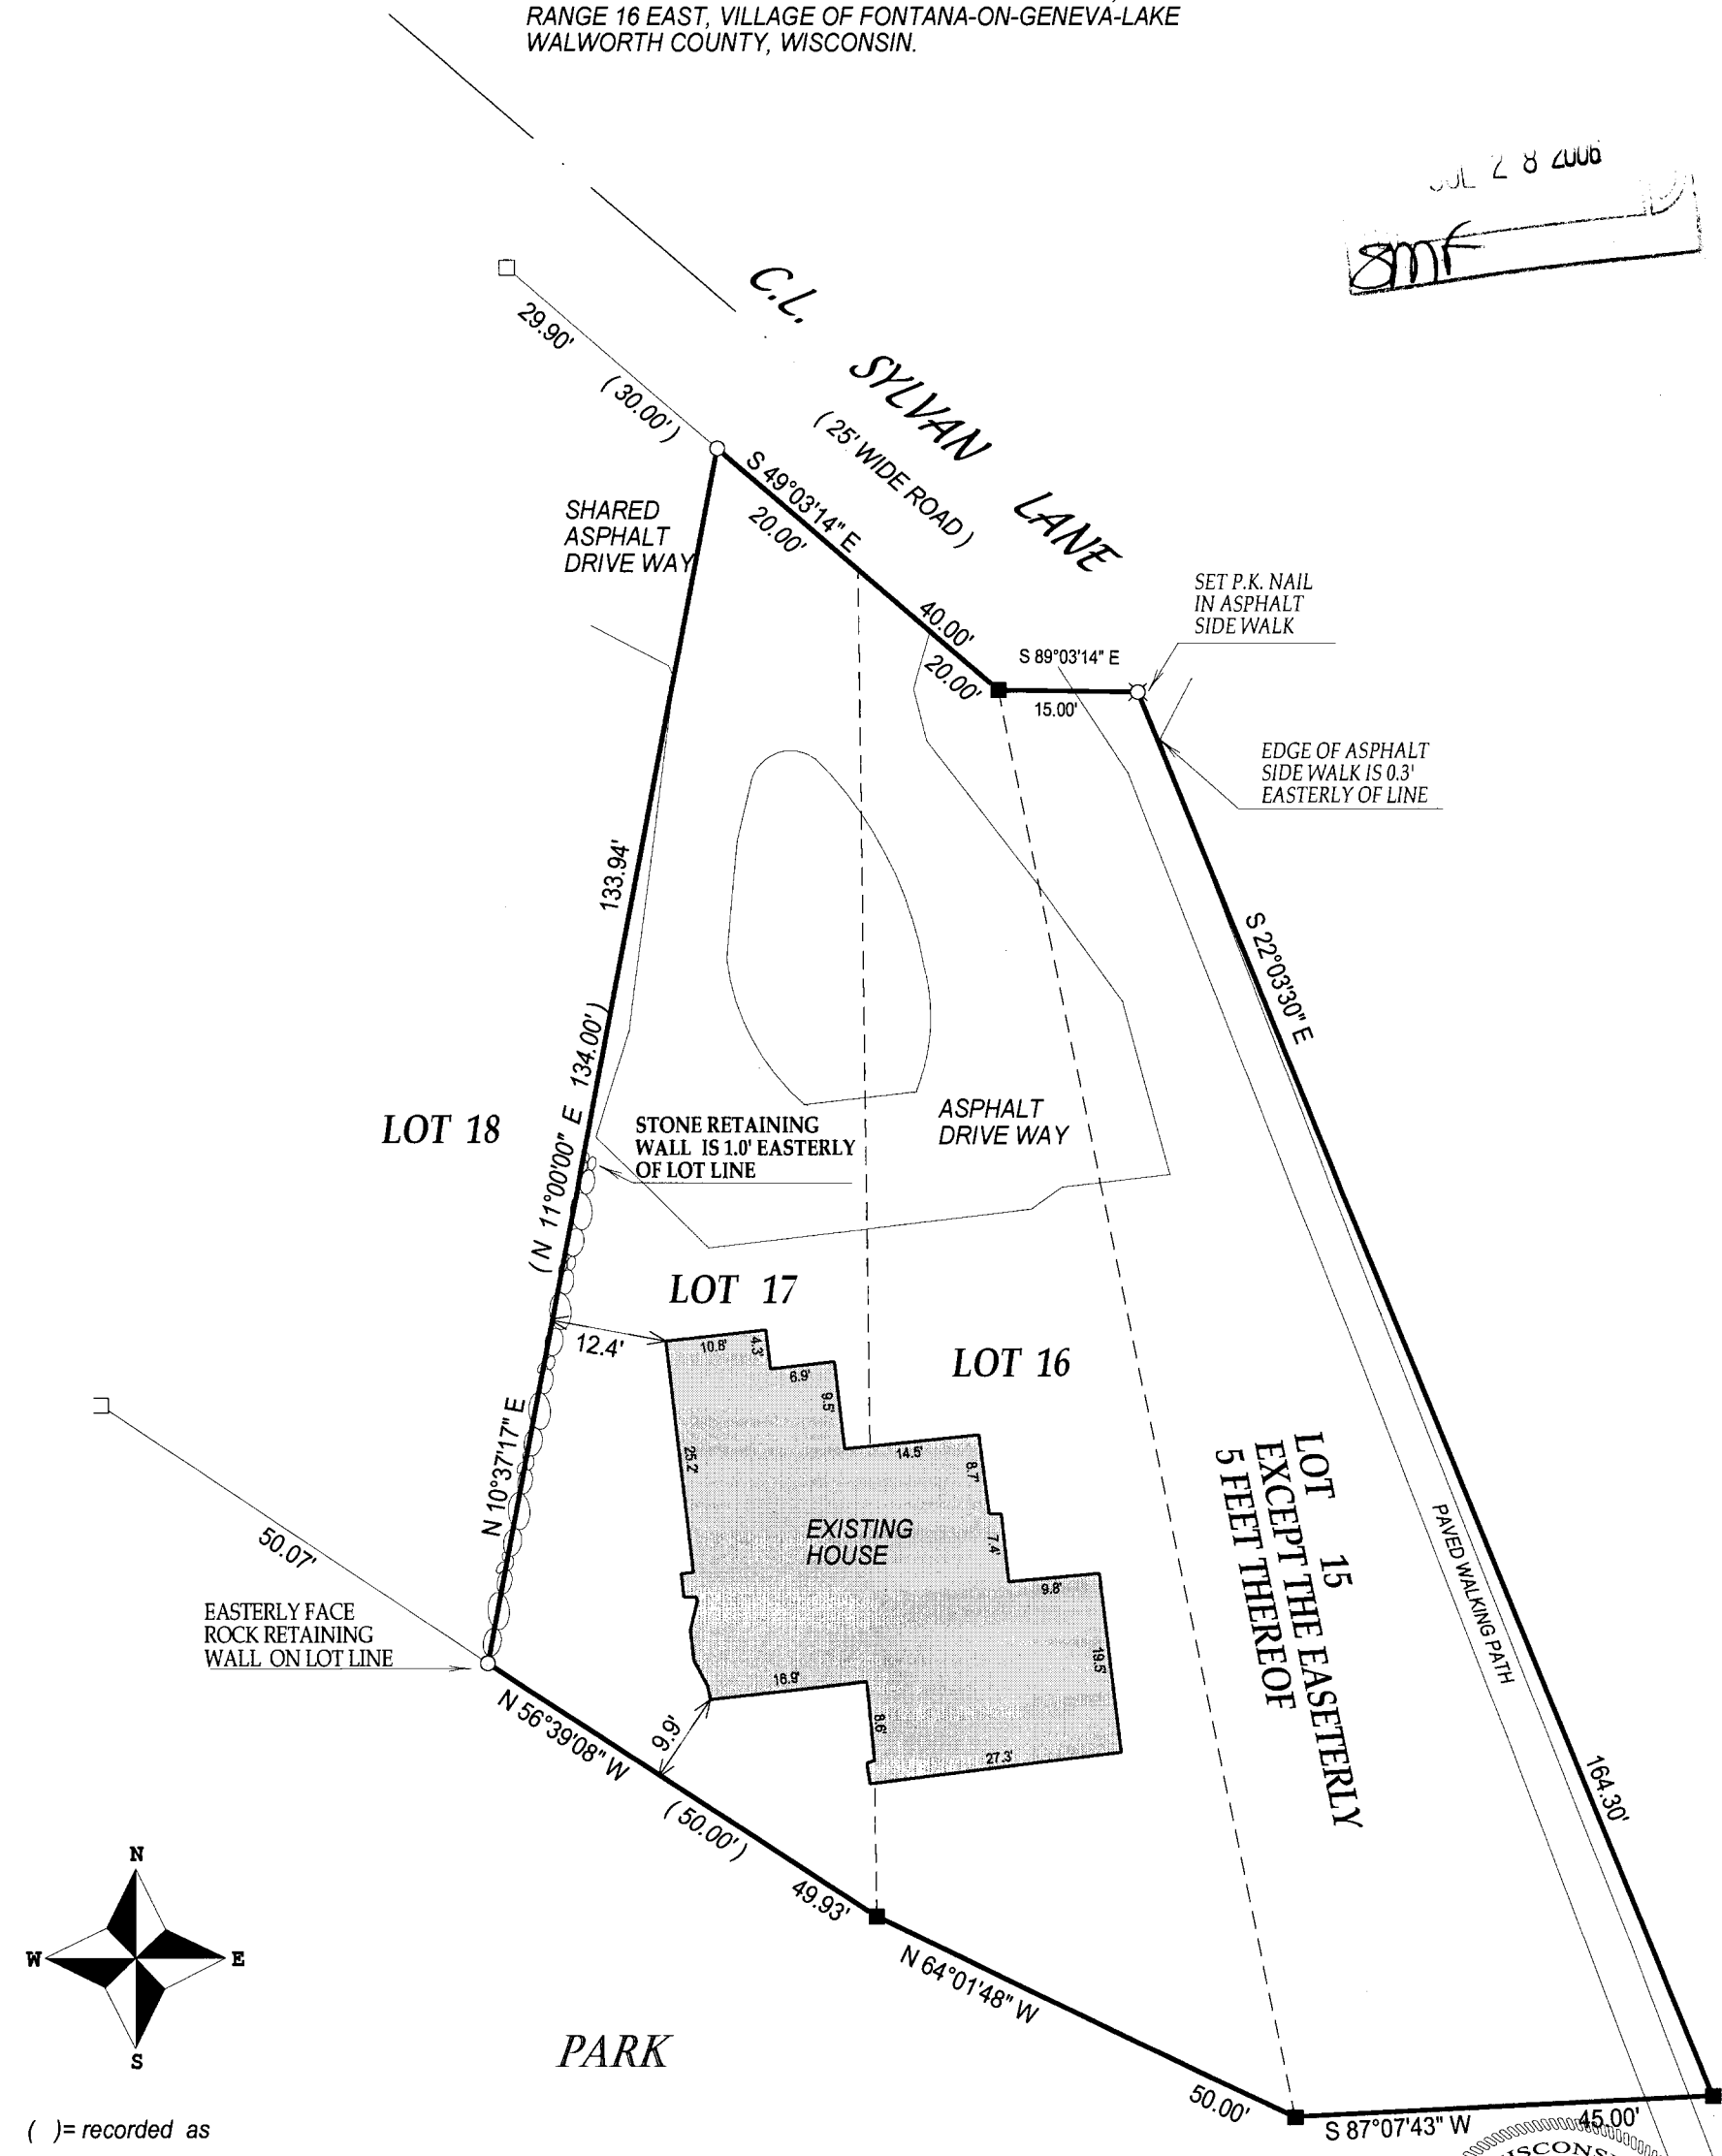

- ( ) = recorded as  
□ = found iron bar  
○ = found iron pipe  
● = set iron pipe  
■ = set iron bar


SCALE 1" = 20'

JOB # 06-288

TAX ID # SBV00010

COMPARE LEGAL DESCRIPTION ABOVE AND DRAWING WITH DEED. FOR BUILDING RESTRICTIONS AND EASEMENTS NOT SHOWN, REFER TO DEED, ABSTRACT SOURCES AND LOCAL MUNICIPAL CODES. NOTIFY THE SURVEYOR IMMEDIATELY OF ANY DISCREPANCY.

"I hereby certify that I have surveyed the above described property and that the above map, to the best of my knowledge and belief, is a true representation thereof and shows the size and location of all visible structures, apparent easements and encroachments if any."  
This survey is made for the present owners of the property, and those who purchase, mortgage, or guarantee the title thereto, within one year from the date hereof.

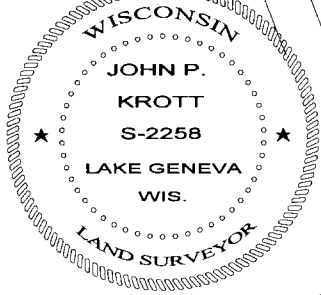

John P. Krott  
John Krott S - 2258  
Wisconsin Registered Land Surveyor  
(original if signed in red)

DATED THIS THE 19th DAY OF JUNE, 2006

005-2398