

LAND-MARK SURVEYING
Mark L. Miritz

Wisconsin Registered Land Surveyor S-2582

N9330 Knuteson Drive
Whitewater, WI 53190
Phone: (262) 495-3284
FAX : (262) 495-8421
LAND-MARKSURVEYING.COM



OWNER: KIMBERLY G. HELTON TRUST
8945 MENARD
MORTON GROVE, IL. 60053

TOPOGRAPHICAL SURVEY

AS RECORDED IN DOCUMENT NO. 627881 OF WALWORTH COUNTY RECORDS

**LOTS 6 AND 7 OF ADDITION "B" TO COUNTRY CLUB ESTATES,
LOCATED IN THE NORTHWEST 1/4 OF SECTION 23, TOWN 1
NORTH, RANGE 16 EAST, VILLAGE OF FONTANA ON GENEVA
LAKE, WALWORTH COUNTY, WISCONSIN**

SUBJECT TO RESTRICTIONS OF RECORD, TO UTILITY EASEMENTS AND
TO AN EASEMENT RESERVED FOR THE OWNER OF THE N. 155 FEET OF
LOT 5 OVER A PARCEL 20 FEET SQUARE IN THE NE CORNER OF LOT 6.

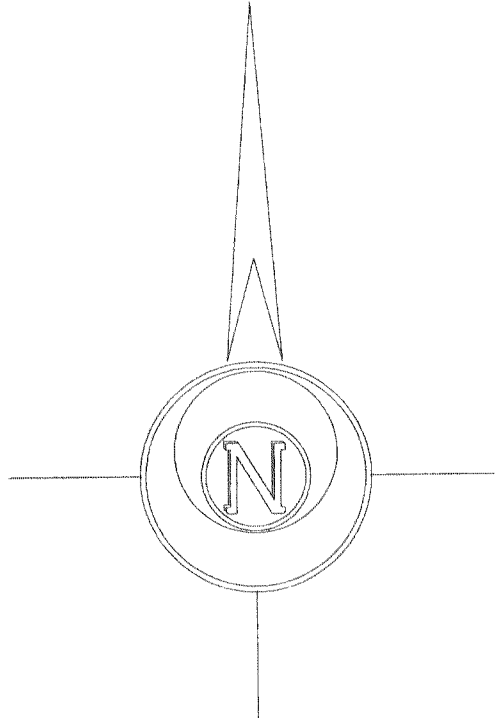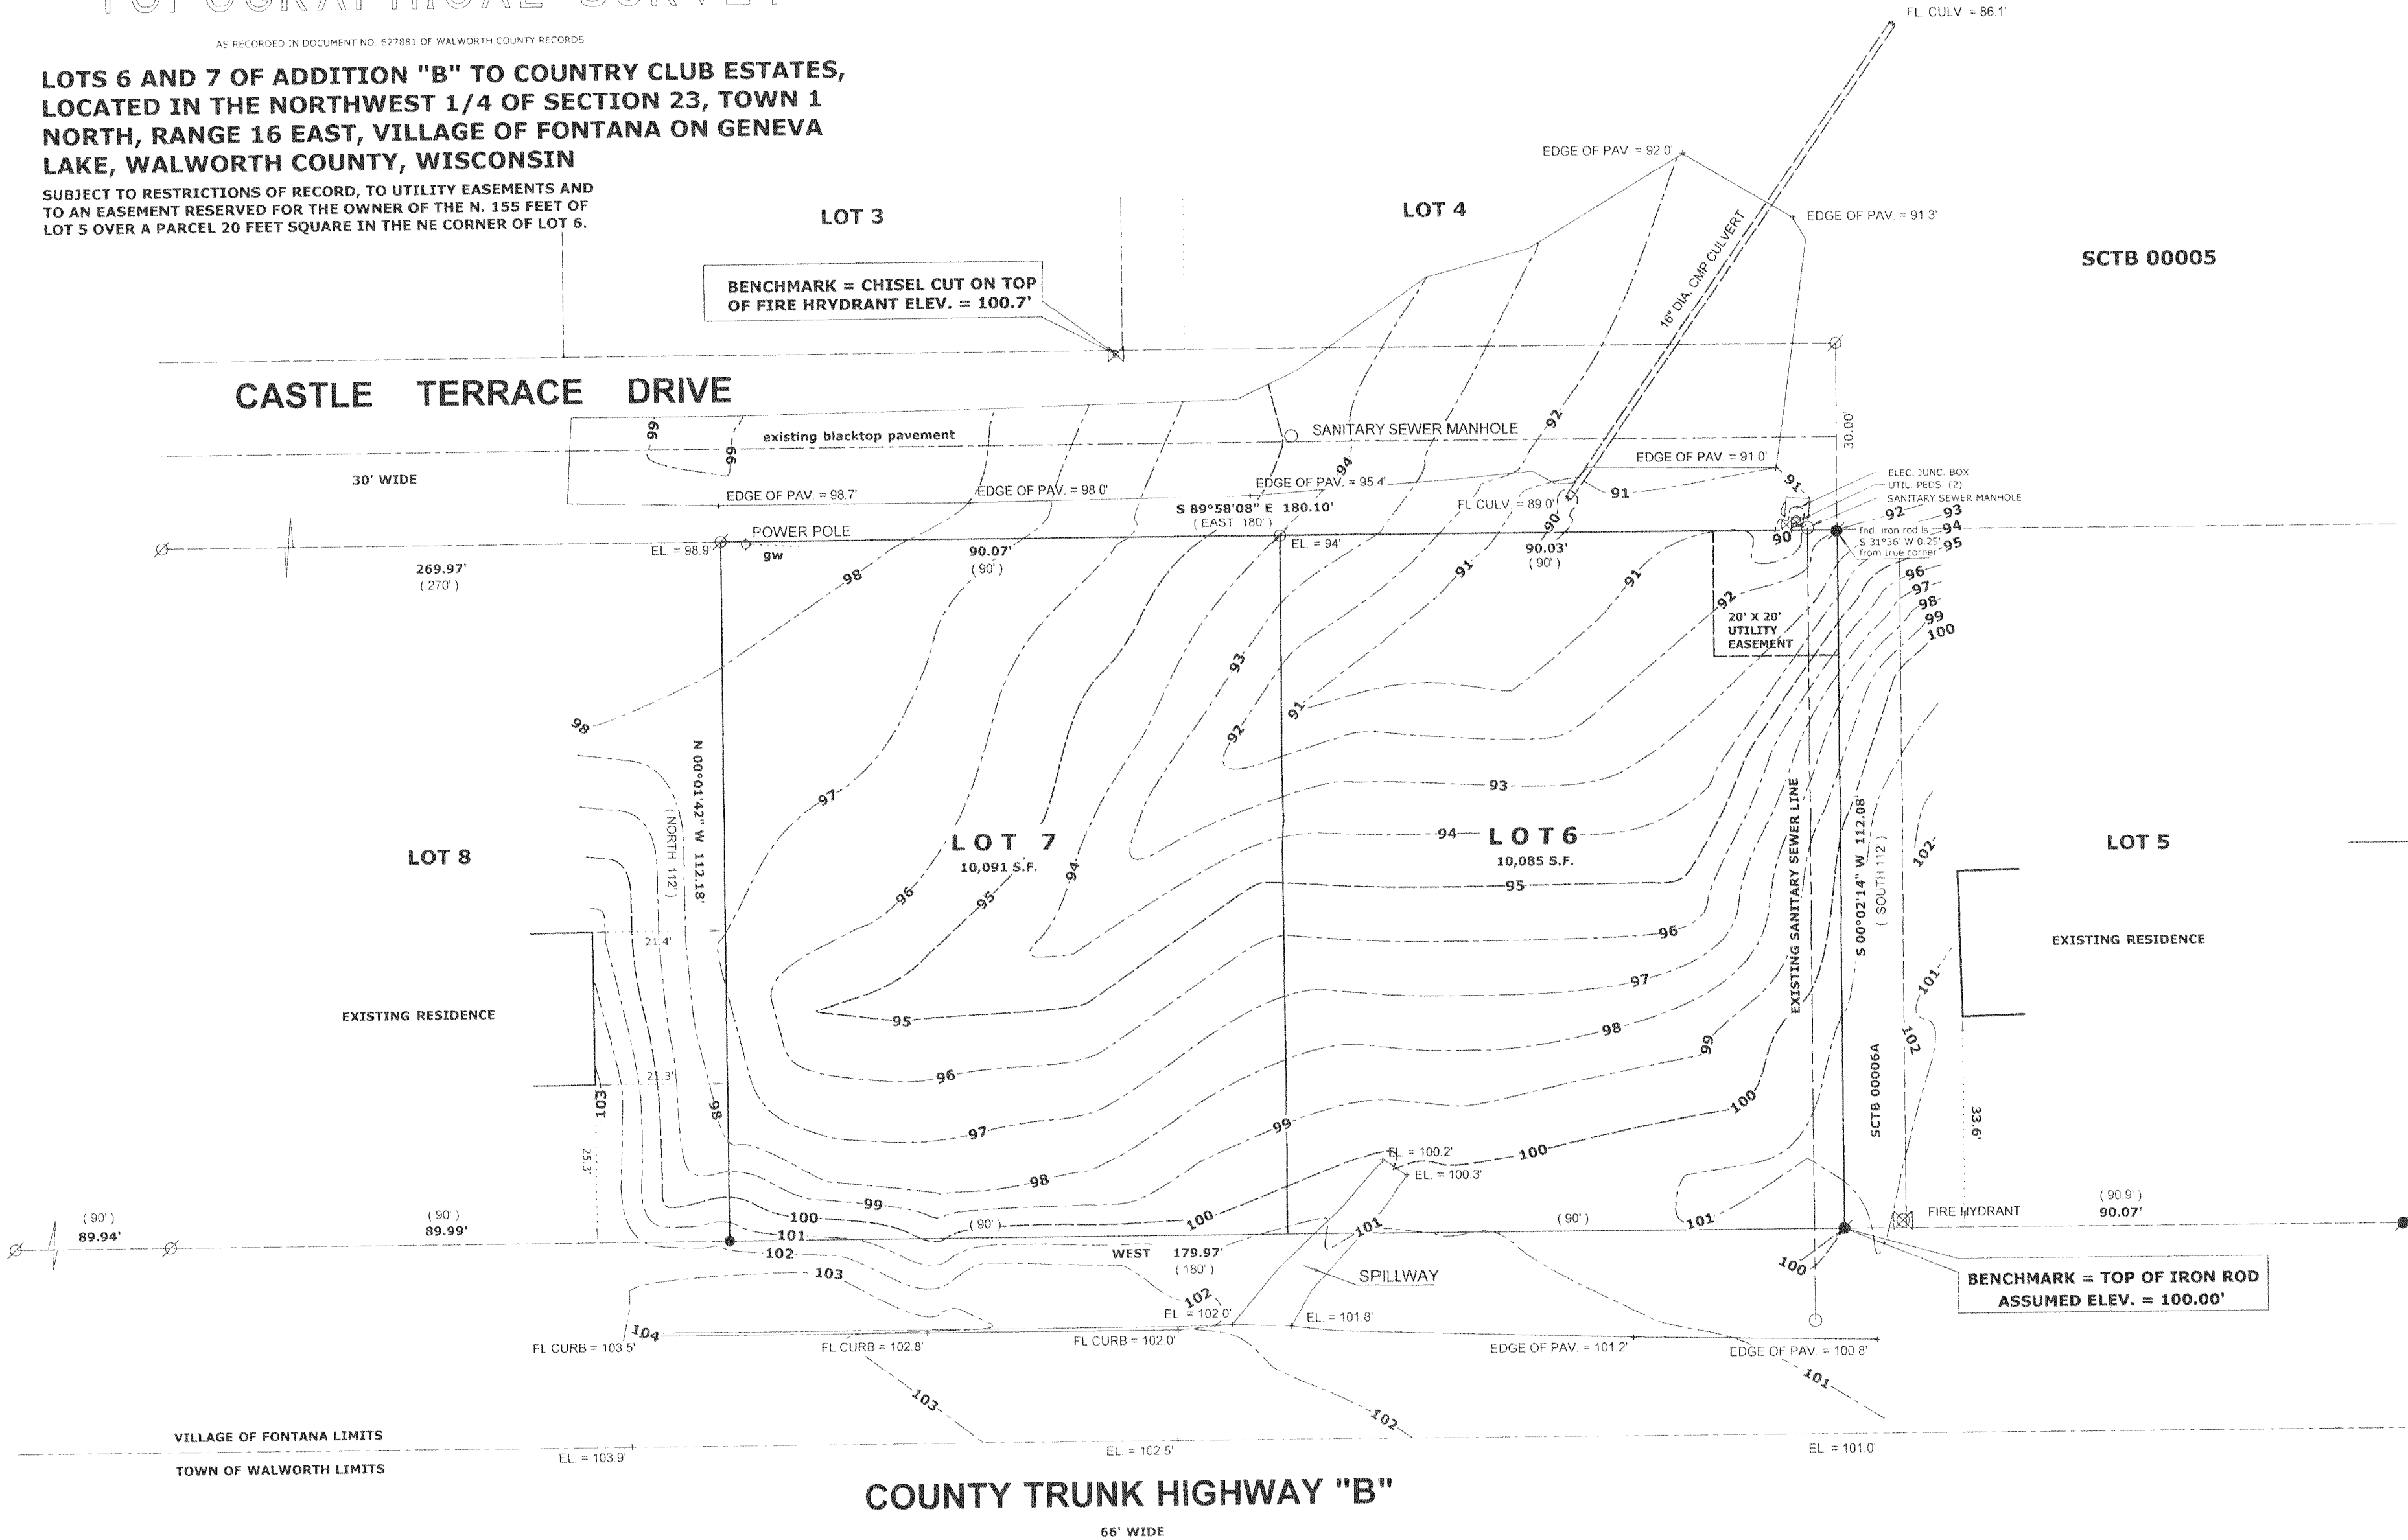

- LEGEND**
- FOUND IRON PIPE
 - FOUND IRON ROD
 - FOUND COUNTY MONUMENT
 - FOUND CONCRETE MONUMENT
 - + CHISEL CUT IN CONCRETE
 - SET IRON ROD, 24" LONG, WEIGHING 1.5 LBS./LINEAL FT., 3/4" DIA.
 - (x x) RECORDED AS DIMENSION
 - x-x- EXISTING FENCE

SCALE: 1" = 20 FEET

"I hereby certify that the above described property has been surveyed by me or under my direction and that the above map is a true representation thereof and shows the size and location of the property, its exterior boundaries, the location of all visible structures and dimensions of all principal buildings thereon, boundary fences, apparent easements, roadways and visible encroachments, if any."

"This survey is made for the use of the present owners of the property, and also those who purchase, mortgage, or guarantee the title thereto within one year from date hereof."

Mark L. Miritz
MARK L. MIRITZ
WISCONSIN REGISTERED
LAND SURVEYOR S-2582
DATE: NOV. 9, 2006 JOB NO. 06.1103

SCTB-7

SCTB-8

005-2427