
## GEORGE T. DUNHAM SURVEYING & SUBDIVIDING DELAVAN, WISCONSIN

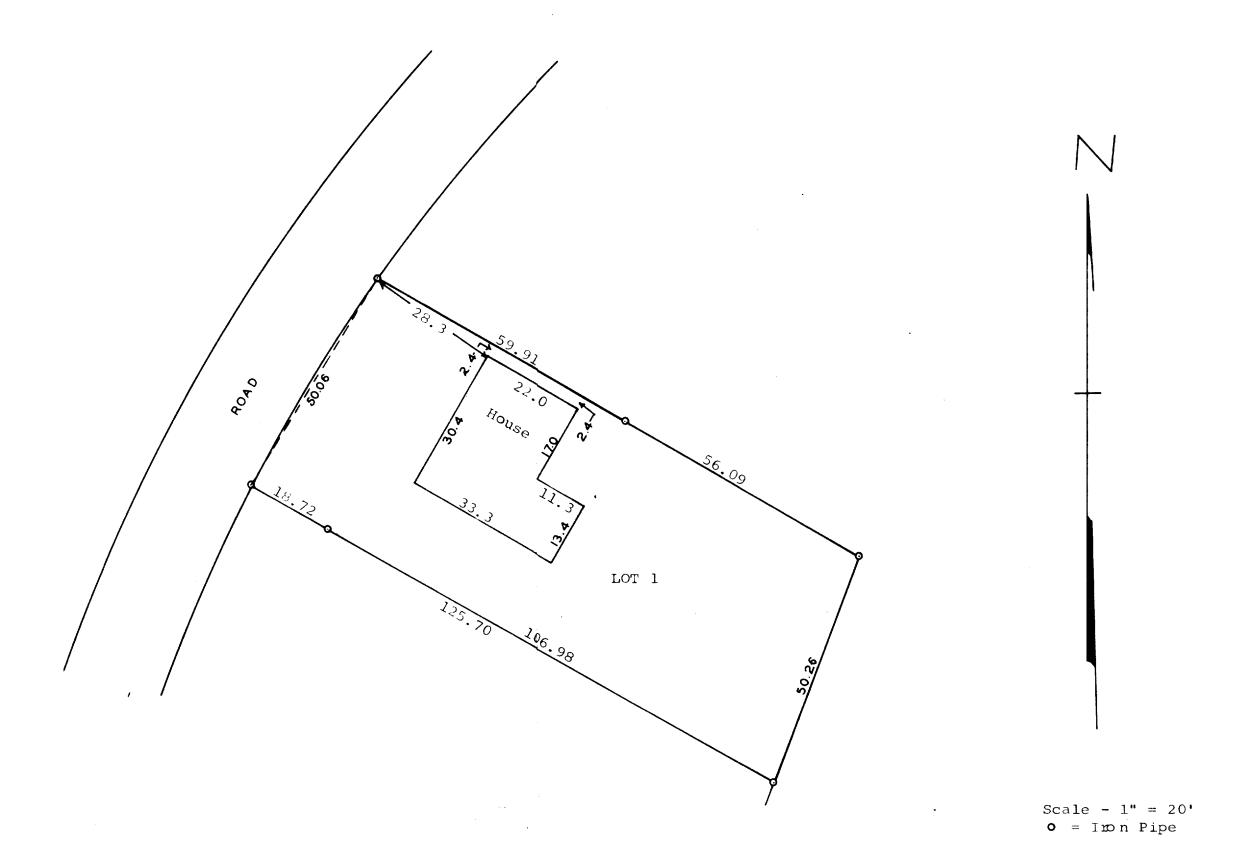

STATE OF WISCONDIN) SS COUNTY OF WALWORTH)

I, George T. Dunham, Surveyor, certify that I have surveyed the property described as follows,

Lot 1, Block 4 of Indian Hills 1st Addition located in the Village of Fontana, Walworth County, Wisconsin, and that the above plat is an accurate survey and a true representation thereof and correctly shows t he exterior lines and location of buildings on said property and the correct measurements thereof.

September 28, 1971

