
PLAT OF SURVEY

THE EAST 20.83' FEET OF LOT 9 AND ALL OF LOTS 10, 11 AND 12 OF BLOCK 5 OF D.A. REIDS ADDITION TO REIDS PARK

LOCATED IN PART OF THE VILLAGE OF FONTANA-ON-GENEVA LAKE, WALWORTH COUNTY, WISCONSIN

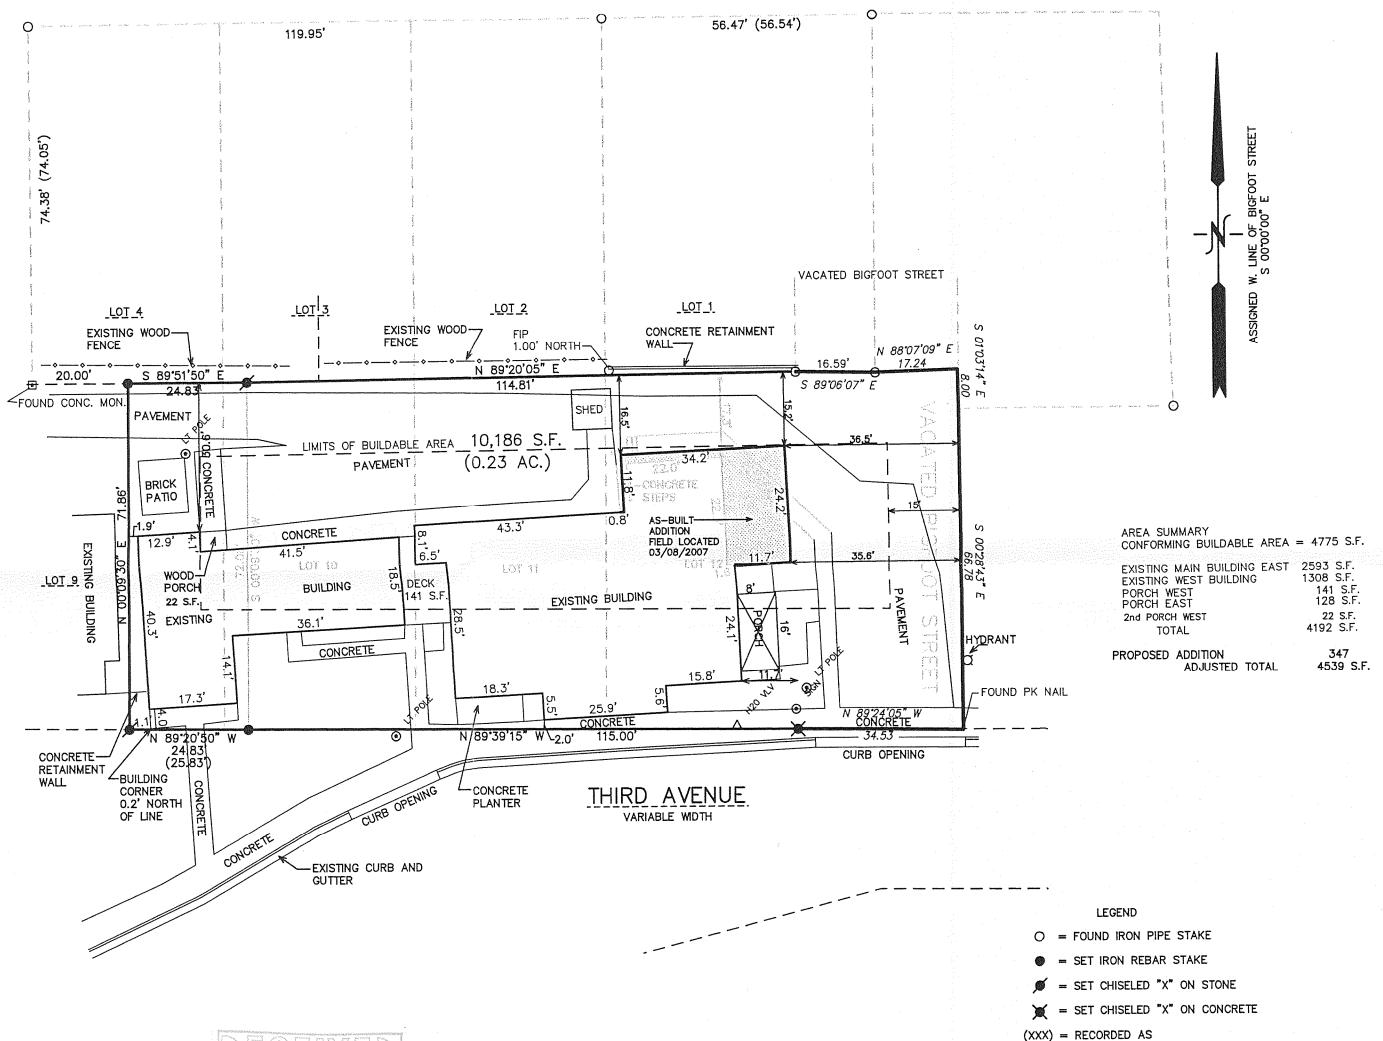

LEGAL DESCRIPTION
BIG FOOT STREET VACATE

THAT PART OF BIG FOOT STREET TO BE VACATED IN THE VILLAGE OF FONTANA-ON-GENEVA LAKE, LOCATED IN THE NORTHWEST 1/4 OF SECTION 14, TOWN 1 NORTH, RANGE 16 EAST, WALWORTH COUNTY, WISCONSIN, DESCRIBED AS FOLLOWS: BEGINNING AT THE SOUTHEAST CORNER OF LOT 12 OF BLOCK 5 OF DA REIDS ADDITION TO REIDS PARK; THENCE ALONG THE FAST LINE OF SAID LOT 12, N OODEG OOMIN OOSEC E, 74.11 FEET TO THE NORTHEAST CORNER OF SAID LOT 12; THENCE S 89DEG 06MIN 07SEC E, 16.59 FEET ALONG THE SOUTH LINE OF A PART OF BIG FOOT STREET PREVIOUSLY VACATED TO AN IRON PIPE STAKE; THENCE S 88DEG 07MIN 09SEC E, ALONG THE SOUTH LINE OF THE VACATED BIG FOOT STREET, 17.24 FEET TO THE EAST LINE OF SAID BIG FOOT STREET; THENCE S OIDEG O3MIN 14SEC E, 8.00 FEET TO AN IRON REBAR STAKE; THENCE CONTINUE S OODEG 28MIN 43SEC E, 66.78 FEET TO A PK NAIL FOUND ON THE NORTH LINE OF THIRD AVENUE; THENCE ALONG SAID NORTH LINE N 89DEG 24MIN 05SEC W, 34.53 FEET TO THE POINT OF BEGINNING. CONTAINING 2,540 SQUARE FEET OF LAND (0.06 ACRES) MORE OR LESS.

NOTE: COPIES OF THIS MAP TO WHICH THE FOLLOWING CERTIFICATE WILL APPLY SHOW THE SURVEYOR'S ORIGINAL SEAL AND SIGNATURE IN RED INK. COPIES BY ANY OTHER MEANS MAY HAVE ALTERATIONS WHICH DO NOT REPRESENT THE SURVEYOR'S WORK PRODUCT.

I HEREBY CERTIFY THAT THE ABOVE DESCRIBED PROPERTY HAS BEEN SURVEYED UNDER MY DIRECTION AND THAT THE ABOVE MAP IS A TRUE REPRESENTATION THEREOF AND SHOWS THE SIZE AND LOCATION OF THE PROPERTY AND ITS EXTERIOR BOUNDARIES. THIS SURVEY IS MADE FOR THE USE OF THE PRESENT OWNERS OF THE PROPERTY, AND ALSO THOSE WHO PURCHASE, MORTGAGE, OR GUARANTEE THE TITLE THERETO WITHIN ONE YEAR FROM THE DATE HEREOF.

DATED: DECEMBER 13, 2005

PETER S. GORDON R.L.S. 2101

REVISED 04-13-2006
ADD VACATE PARCEL
AND LEGAL DESCRIPTION
REVISED 09-28-2006
CORRECT SCRIVENNOR'S E

REVISED 09-28-2006 CORRECT SCRIVENNOR'S ERROR IN VACATE LEGAL DESC.

005-2448

SRA - 35

(XX) = RECORDED AS

REVISIONS

08-09-06

PSG

09-06-2006

SHOW VACATED ROW
& PRO. ADD.

ARRIS, I ENGINEERI

& PRO. ADD.

03/09/2007-KD
TO SHOW SIZE &
LOCATION OF
AS-BUILT
ADDITION

LOCATION OF AS-BUILT ADDITION

PROJECT NO. 6935

DATE:

12/13/05 SHEET NO. 1 OF 1