

ELEVATIONS OF EXISTING RESIDENCE ON LOT 7,
BLOCK 12, GLENWOOD SPRINGS SUBDIVISION,
VILLAGE OF FONTANA-ON-GENEVA, WALWORTH
COUNTY, WISCONSIN



THIS IS A RESURVEY OF A SURVEY BY ROBERT M. BAERENWALD DATED 5/2/1996

ROOF PEAK ELEV = 140.6'
LOWEST GROUND = 104.1'

BUILDING HEIGHT = 36.5'

NOTE: THIS IS A CURRENT
BUILDING HEIGHT, WHICH IS
THE SAME AS BEFORE THE
HOUSE WAS RAISED FOR A
FOUNDATION.

OWNER: INGRID A. GEVAVI TRUST
333 N. CANAL ST #1906
CHICAGO, IL 60606

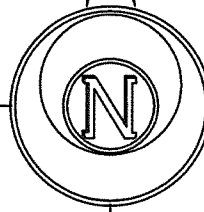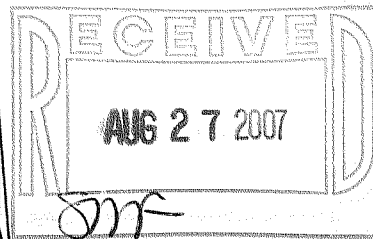

SEE PETER S. GORDON
SURVEY DATED 4/4/02

BENCHMARK

TOP NAIL HEAD OF 60-PENNY
NAIL SE SIDE OF 42" TREE
ASSUMED ELEV = 100.00

LOT 7
2,160 SQ. FT.

LOT 6

SEE GEORGE T. DUNHAM
SURVEY DATED 7/20/1984

LEGEND

- FOUND IRON PIPE
- FOUND IRON ROD
- FOUND RR SPIKE OR PK NAIL
- CUT CROSS IN CONCRETE/ STONE WALL
- SET IRON ROD, 24" LONG, WEIGHING
1.5 LBS./LINEAL FT., 3/4" DIA.
- (x x) RECORDED AS DIMENSION

SCALE: 1" = 20 FEET

"I hereby certify that the above described property has
been surveyed by me or under my direction and that the
above map is a true representation thereof and shows the
size and location of the property, its exterior boundaries,
the location of all visible structures and dimensions of all
principal buildings thereon, boundary fences, apparent
easements, roadways and visible encroachments, if any."
"This survey is made for the use of the present owners of
the property, and also those who purchase, mortgage, or
guarantee the title thereto within one year from date
hereof."

R.R. SPIKE

P.K. NAIL

WALNUT PLACE

BENCHMARK
TOP OF FIRE HYDRANT
ELEV = 122.23'

N9330 KNUTESON DRIVE
WHITEWATER, WI 53190

LAND-MARK SURVEYING

www.Land-MarkSurveying.com

PHONE: (262) 495-3284
CELL: (262) 949-1239
FAX: (262) 495-8421

DATE: JUNE 21, 2007 JOB NO. 06.1110

MARK L. MIRITZ
WISCONSIN REGISTERED
LAND SURVEYOR S-2582

SGS-65

005-24/85