


**SURVEYING & SUBDIVIDING
DELAVER, WISCONSIN**

Scale - 1" = 20'

○ = Iron Pipe

● = Concrete Monument

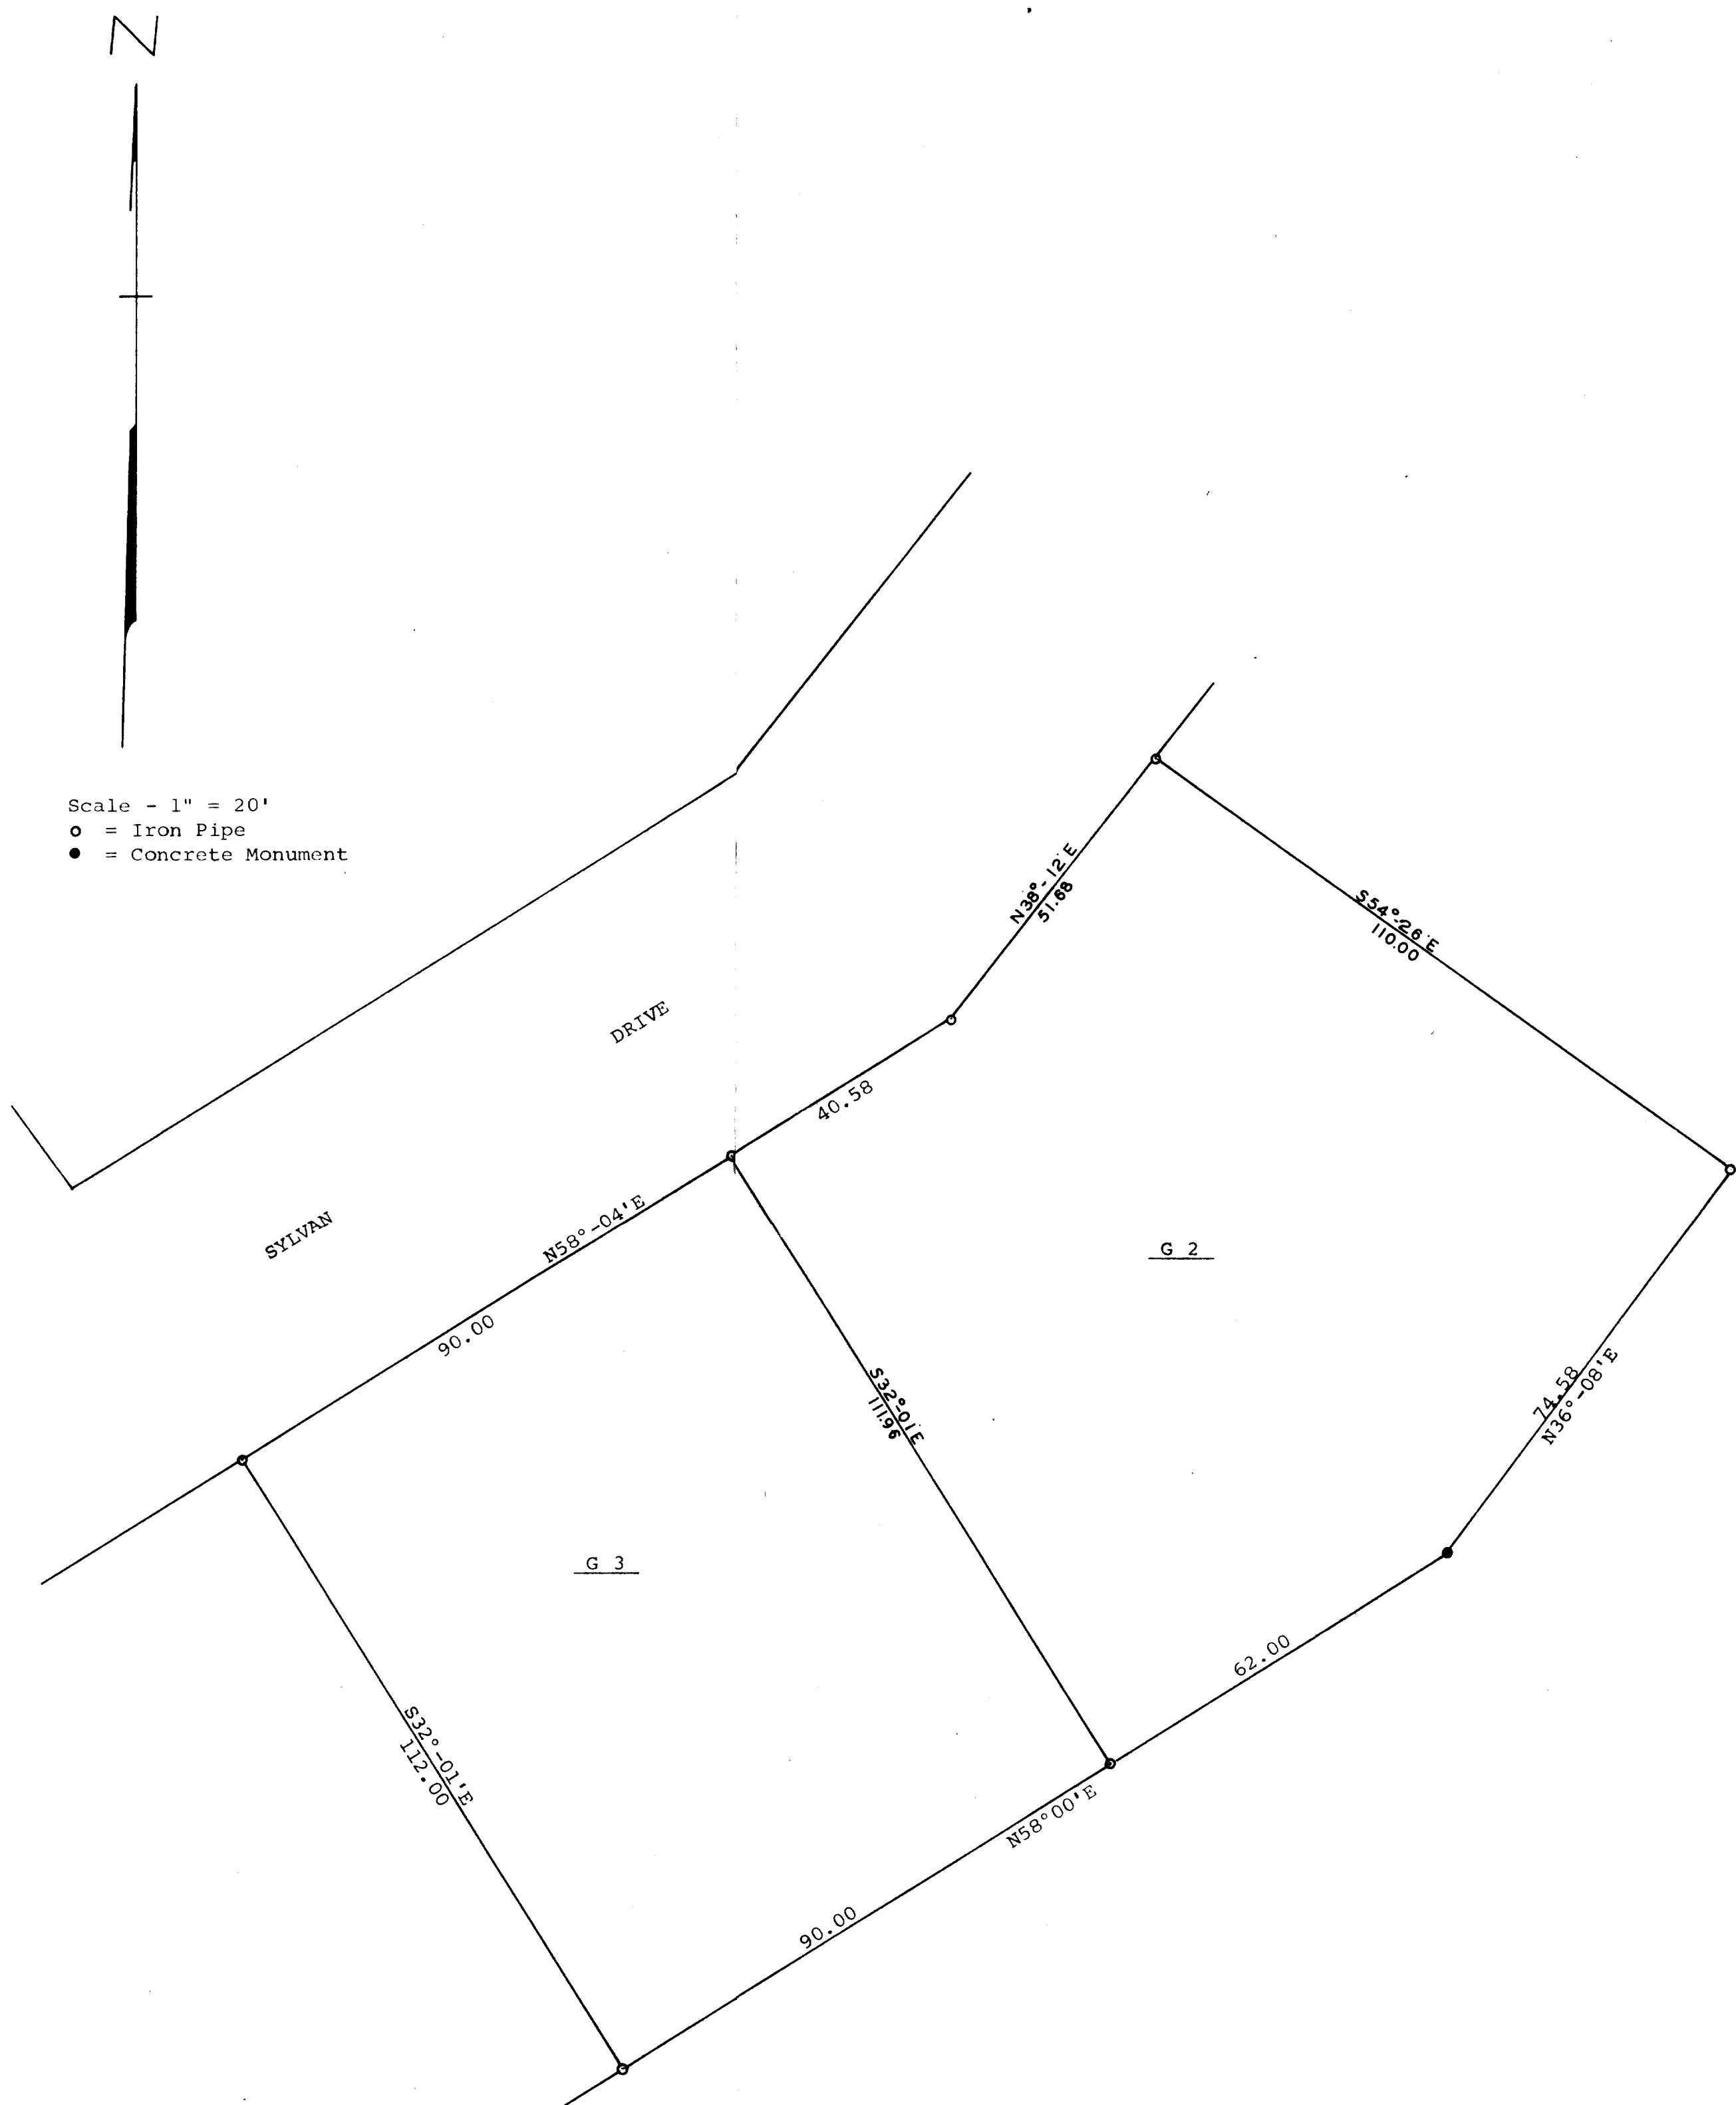

Plat of survey of Lots G 2 and G 3 in Addition G
to Country Club Estates, Village of Fontana, Walworth
County, Wisconsin.
August 12, 1971

George T. Dunham
George T. Dunham, Surveyor

