




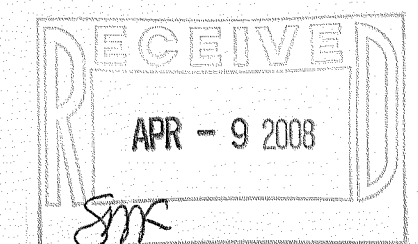


PROPOSED BEACH HOUSE & PARKING LAYOUT

DAVID COATES
COATES DESIGN/DEVELOPMENT GROUP, LLC
509 FOREST GLEN DRIVE
FONTANA, WI 53125

**UTILIZING THE EXISTING BLACKTOP
THERE ARE 45 CONVENTIONAL PARKING
STALLS (9' X 18') , 2 HANDICAP STALLS
(13' X 18') AND 1 COMPACT CAR STALL
(8' X 16') = 48 STALLS TOTAL**



THIS SURVEY RETRACES A SURVEY BY IGNATIUS N. ROBERS DATED MARCH 1, 1971 OF PART OF LOT 1, A SURVEY BY HAROLD H. KOLB DATED MAY 21, 1980 OF PART OF LOT 2, AND A SURVEY BY LLOYD L. JENSEN DATED NOV. 9, 1970

	FOUND IRON PIPE
	FOUND IRON ROD
	FOUND COUNTY MONUMENT
	SET P.K. NAIL
	SET IRON ROD, 24" LONG, WEIGHT 1.5 LBS./LINEAL FT., 3/4" DIA.
(x x)	RECORDED AS DIMENSION
	EXISTING FENCE

"I hereby certify that the above described property has been surveyed by me or under my direction and that the above map is a true representation thereof and shows the size and location of the property, its exterior boundaries, the location of all visible structures and dimensions of all principal buildings thereon, boundary fences, apparent easements, roadways and visible encroachments, if any." "This survey is made for the use of the present owners of the property, and also those who purchase, mortgage, or guarantee the title thereto within one year from date hereof."

REVISED SEPT. 11, 2007 TO SHOW PROPOSED BEACH HOUSE & PARKING LAYOUT
REVISED OCT. 17, 2007 TO SHOW GREEN SPACE & VEHICLE FREE ZONE
REVISED OCT. 19, 2007 TO SHOW PERCENT OF GREEN SPACE
REVISED NOV. 1, 2007 TO SHOW SOUTHERLY PORTION OF PAVEMENT BY CURB
REVISED DEC. 27, 2007 TO FOUNDATION "AS BUILT"