
FARRIS, HANSEN & ASSOC. INC.

7 RIDGWAY COURT- P.O. BOX 437 ELKHORN, WISCONSIN 53121 PHONE (262) 723-2098 FAX (262) 723-5886

ORDERED BY: KEEFE REAL ESTATE PO BOX 460 LAKE GENEVA, WI. 53147

PLAT OF SURVEY

LOT 11, BLOCK 7 INDIAN HILLS
1ST ADDITION SUBDIVISION
LOCATED IN THE SE 1/4 SEC. 14
TOWN 1 NORTH, RANGE 16 EAST
VILLAGE OF FONTANA—ON—GENEVA LAKE
WALWORTH COUNTY, WISCONSIN

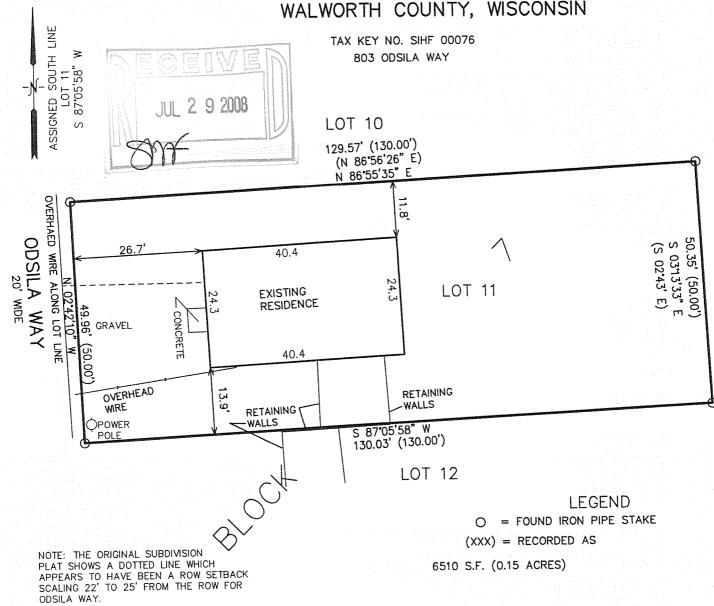

NOTE: COPIES OF THIS MAP TO WHICH THE FOLLOWING CERTIFICATE WILL APPLY SHOW SURVEYOR'S ORIGINAL SEAL AND SIGNATURE IN RED INK. COPIES BY ANY OTHER MEANS MAY HAVE ALTERATIONS WHICH DO NOT REPRESENT THE SURVEYOR'S WORK PRODUCT.

I HEREBY CERTIFY THAT THE ABOVE DESCRIBED PROPERTY HAS BEEN SURVEYED UNDER MY DIRECTION AND THAT THE ABOVE MAP IS A TRUE REPRESENTATION THEREOF AND SHOWS THE SIZE AND LOCATION OF THE PROPERTY, ITS EXTERIOR BOUNDARIES, THE LOCATION OF ALL VISIBLE STRUCTURES, AND DIMENSIONS OF ALL PRINCIPLE BUILDINGS THEREON, BOUNDARY FENCES, APPARENT EASEMENTS, ROADWAYS, AND VISIBLE ENCROACHMENTS, IF ANY. THIS SURVEY IS MADE FOR THE USE OF THE PRESENT OWNERS OF THE PROPERTY, AND ALSO THOSE WHO PURCHASE, MORTGAGE, OR GUARANTEE THE TITLE THERETO WITHIN ONE YEAR FROM THE DATE HEREOF.

PETER S. GORDON R.L.S. 2101

10 5 0 10 20 30 40 50 60 70 80 90 10 MAP SCALE IN FEET ORIGINAL 1" = 20'

PROJECT NO. 7674
DATED: 07-02-2008
SHEET 1 OF 1 SHEETS

JUL 1 5 2008 51116-7/a

005-2589

GORDON S-2101 ELKHORN

W