


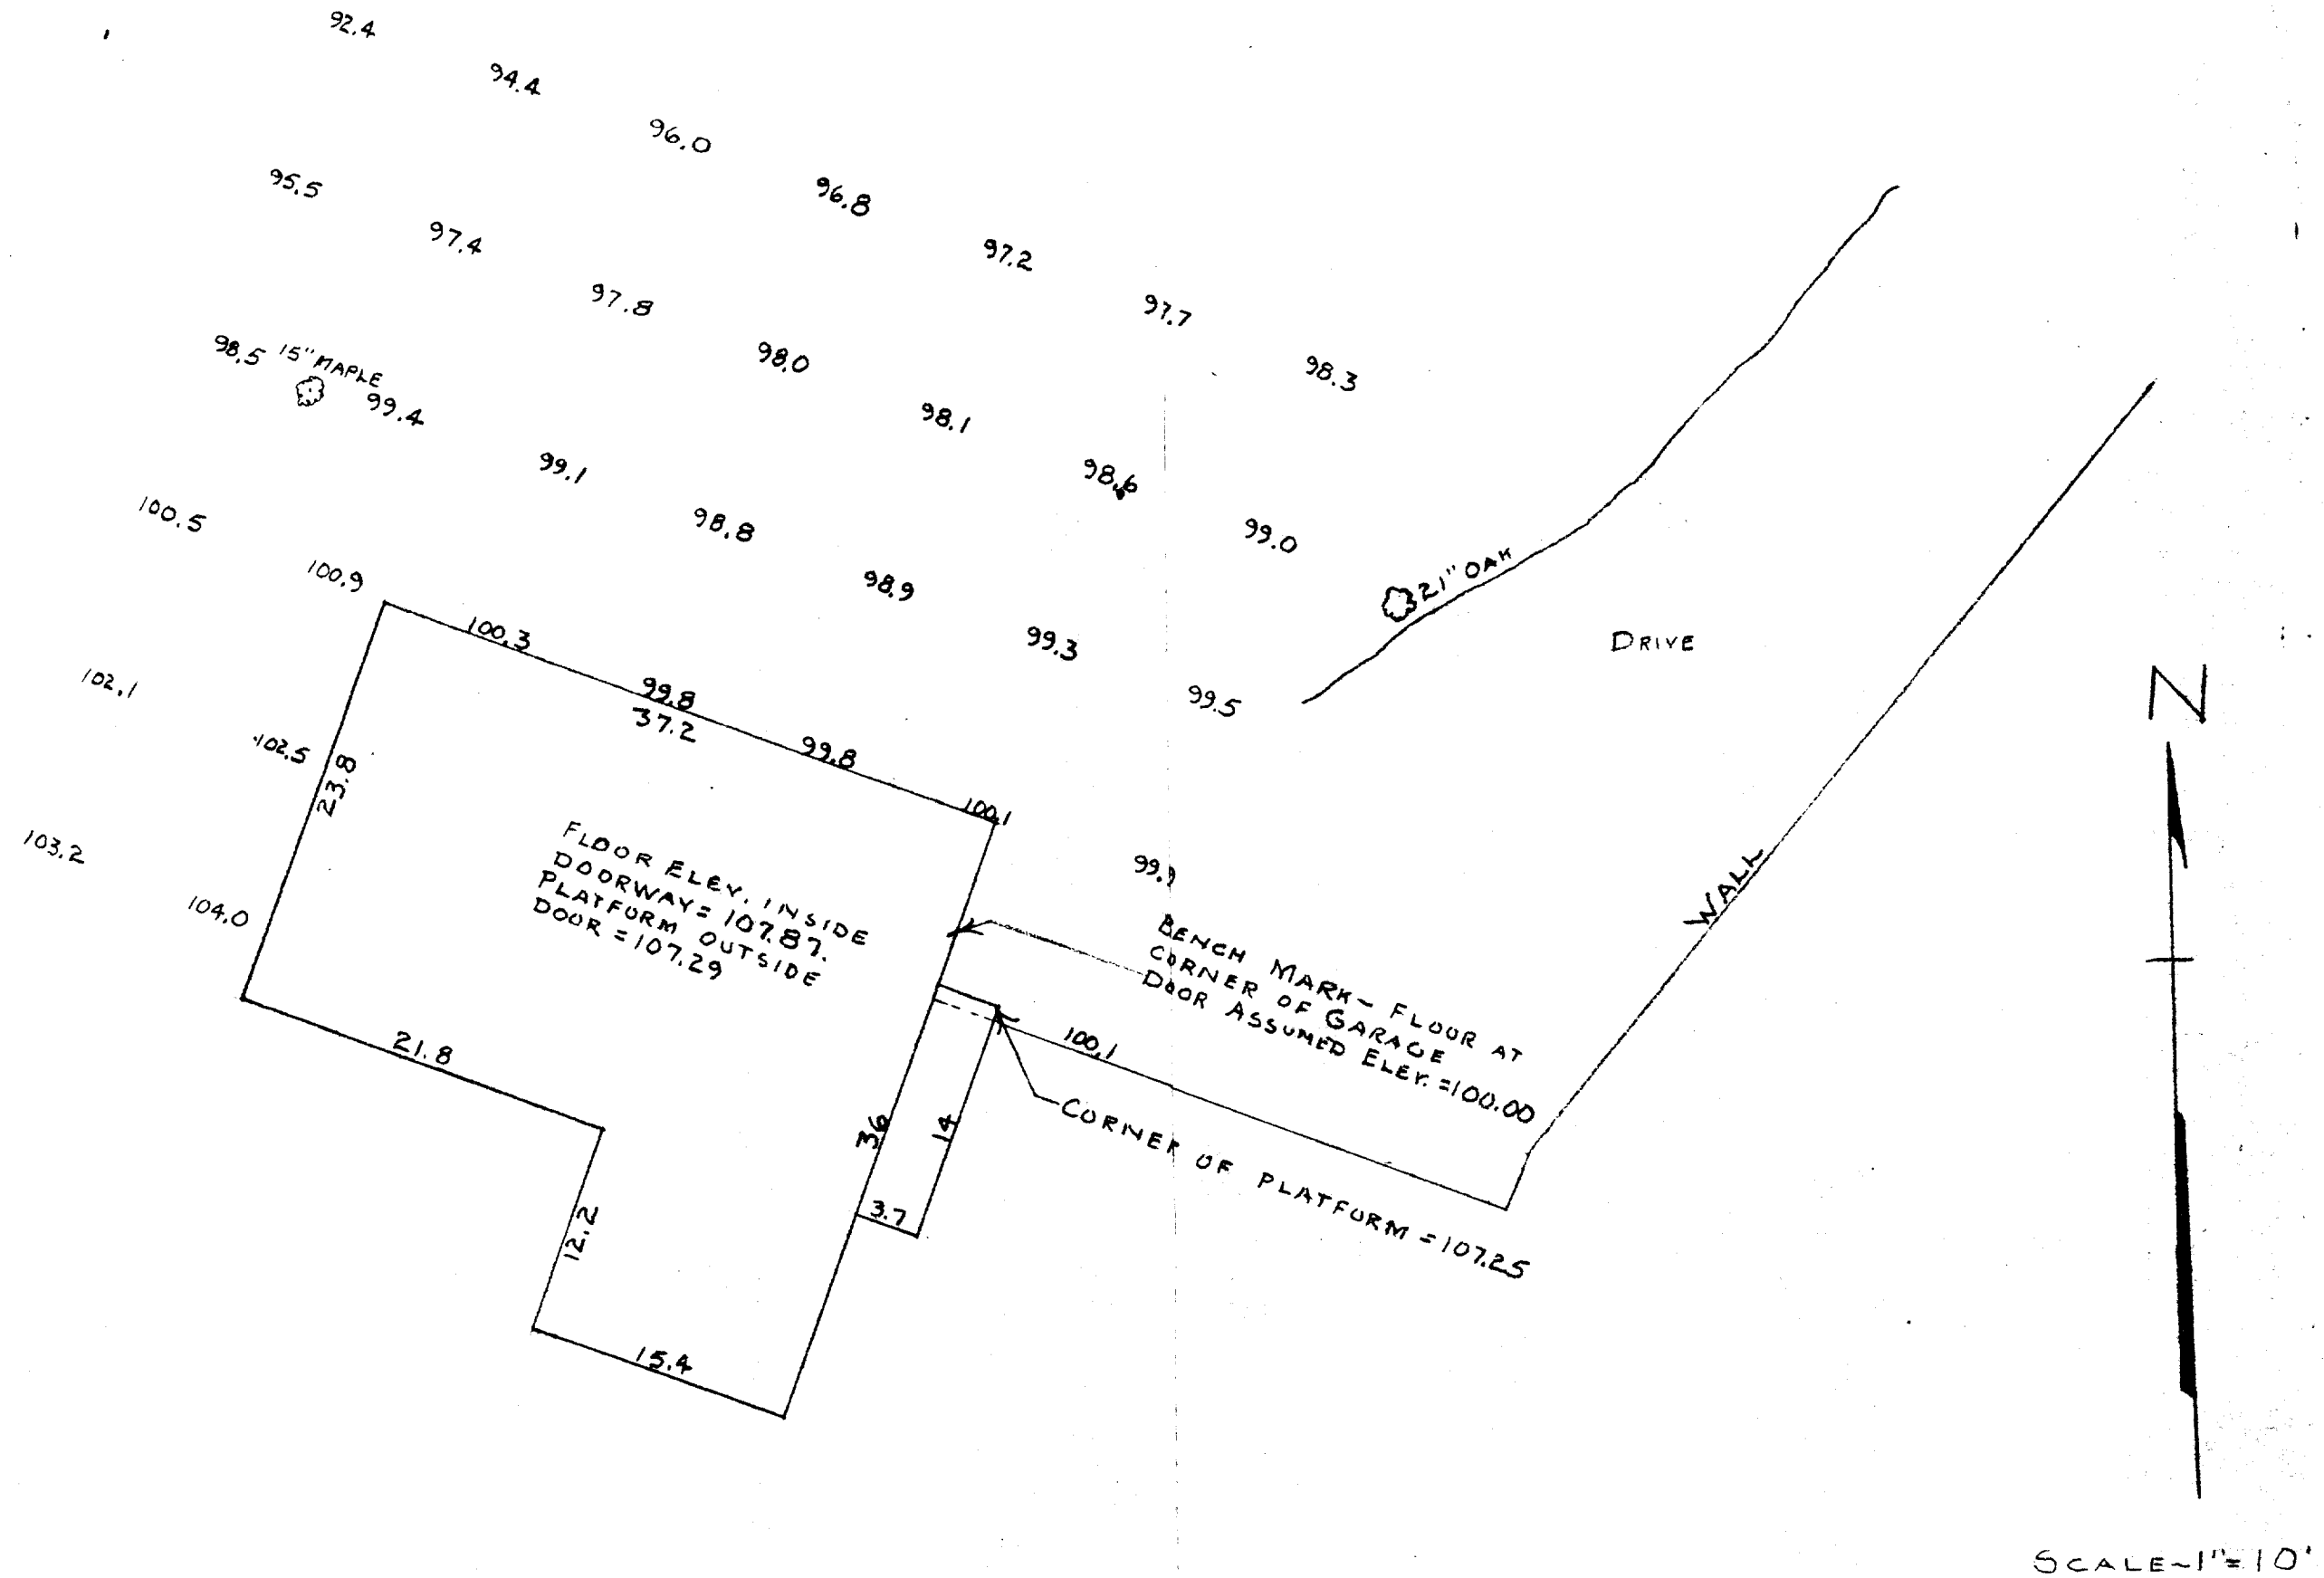

PLAT SHOWING ELEVATIONS ON THE ROBERT L. SULLIVAN PROPERTY LOCATED
ON LOT 7, ADD. NO 1 TO COUNTRY CLUB ESTATES, VILLAGE OF FONTANA, WALWORTH
COUNTY, WISCONSIN
SEPT. 1958

SLT-7

George T. Dunham
GEORGE T. DUNHAM, SURVEYOR
DELAWARE, WISCONSIN

5-26