

PREPARED FOR:
WYNTREE CONSTRUCTION
7170 MADUS STREET
LAKE GENEVA, WI 53147


PLAT OF SURVEY

-OF-

LOT 4, OF CERTIFIED SURVEY MAP NO. 1157, ALSO KNOWN AS UNIT
4 OF ABBEY SPRINGS CONDOMINIUM NO. 12, LOCATED IN OUTLOT 64
OF ASSESSOR'S PLAT 1 AMENDED, OF THE VILLAGE OF FONTANA-
ON GENEVA LAKE, WALWORTH COUNTY, WISCONSIN.

KROTT SURVEYING INC.

N3705 WILLOW BEND LANE
LAKE GENEVA WI. 53147
PHONE # (262)248-3697
FAX # (262)249-0639

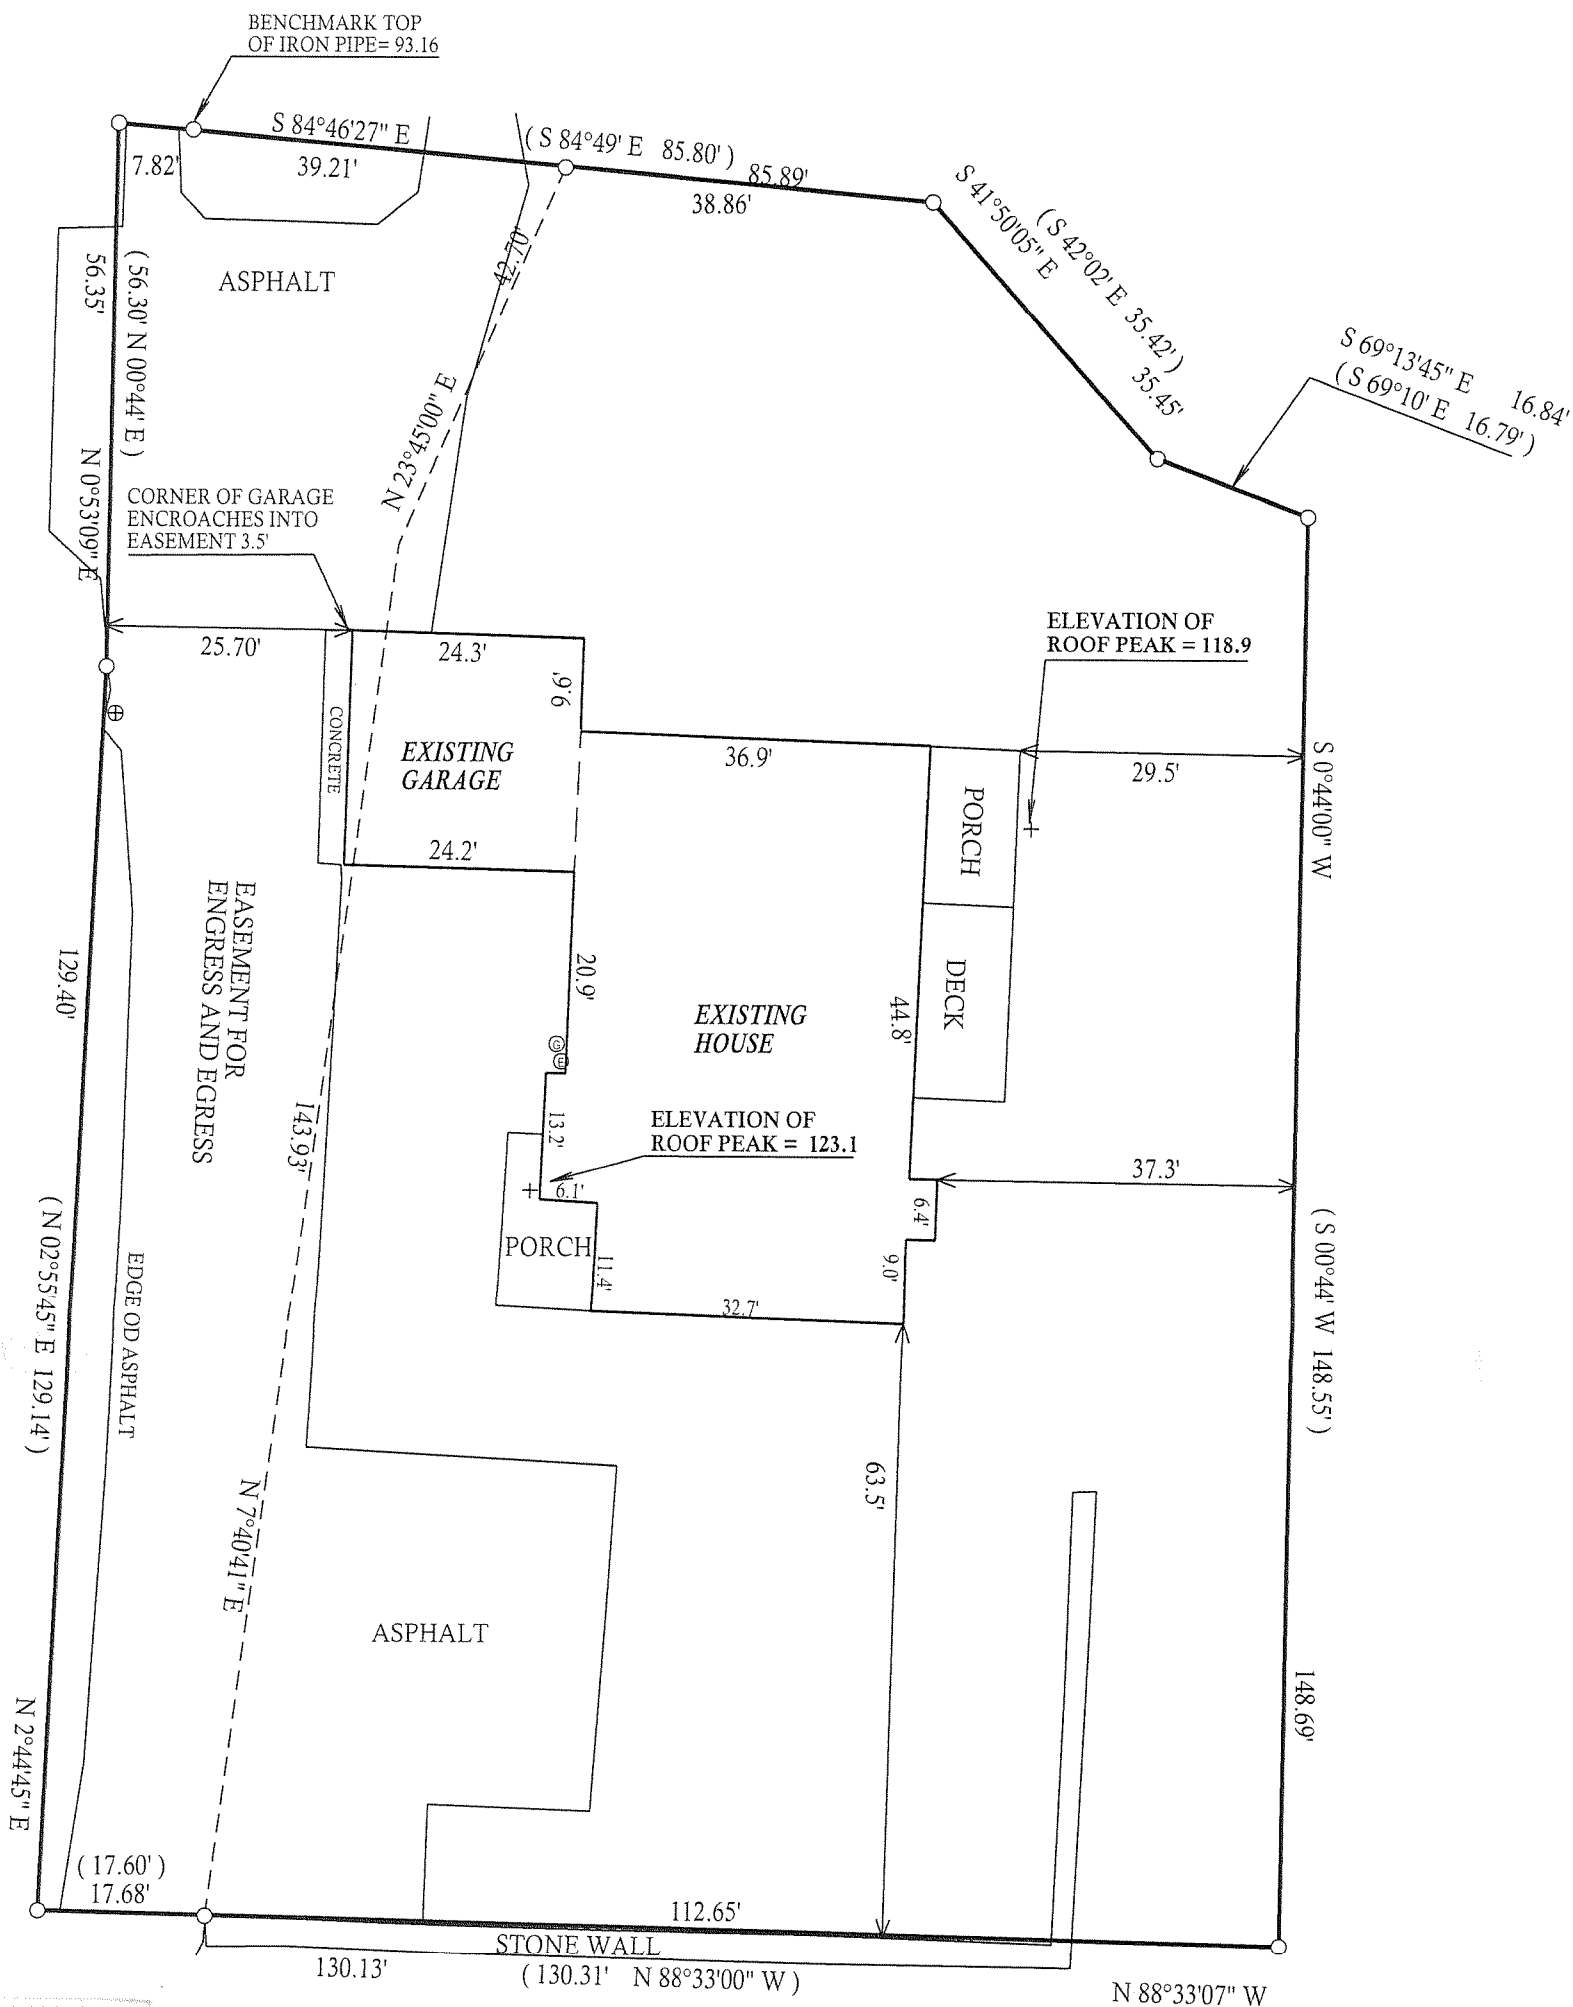


DEC - 1 2008

8mf

C.L. SOUTH LAKE SHORE DRIVE

(66' WIDE)

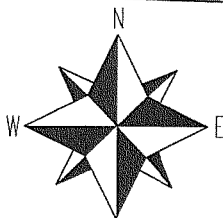

SCALE 1"=20'

LEGEND

- FOUND IRON PIPE
- FOUND IRON BAR
- SET IRON BAR
- (xx) RECORDED AS


JOB # 07-501 TAX ID # SCDB1200004

DATED THIS THE 12th DAY OF OCTOBER 2007.

COMPARE LEGAL DESCRIPTION ABOVE AND DRAWING WITH DEED
FOR BUILDING RESTRICTIONS AND EASEMENTS NOT SHOWN, REFER
TO DEED, ABSTRACT SOURCES AND LOCAL MUNICIPAL CODES. NOTIFY
THE SURVEYOR IMMEDIATELY OF ANY DISCREPANCY.

"I hereby certify that I have surveyed the above described property and that
the above map is a true representation thereof and shows the size and
location of all visible structures, apparent easements and encroachments
if any."

This survey is made for the present owners of the property, and those who
purchase, mortgage, or guarantee the title thereto, within one year from
the date hereof.

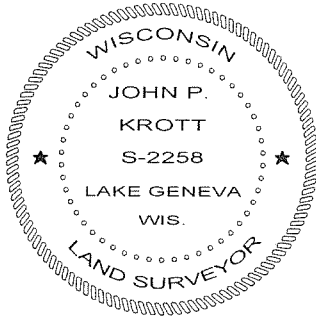

DATE OF LAST REVISION: 8 / 27 / 2008

John P. Krott

JOHN KROTT S - 2258
Wisconsin Registered Land Surveyor
(original if signed in red)

005 - 21014