


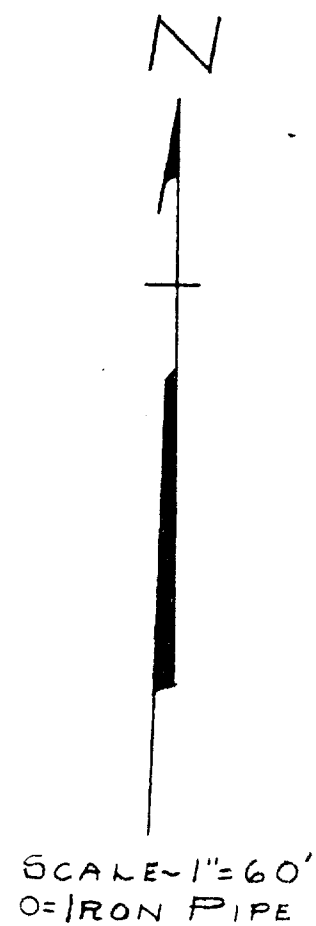

STATE OF WISCONSIN)^{SS}
WALWORTH COUNTY)

I, GEORGE T. DUNHAM, DO HEREBY CERTIFY THAT I HAVE
SURVEYED THE PROPERTY DESCRIBED AS FOLLOWS:
OUT LOT #57 ACCORDING TO THE ASSESSORS PLAT OF THE
VILLAGE OF FONTANA ON GENEVA LAKE, WALWORTH
COUNTY, WISCONSIN AS RECORDED IN VOL. 11 OF PLATS ON
PAGE 16, OFFICE OF THE REGISTER OF DEEDS FOR WALWORTH
COUNTY, WISCONSIN

DEC. 2, 1959

George T. Dunham
GEORGE T. DUNHAM, SURVEYOR
DELAVER, WISCONSIN

