


Wisconsin Registered Land Surveyor S-2582

**N9330 Knuteson Drive
Whitewater, WI 53190
Phone: (262) 495-3284
FAX : (262) 495-8421
LAND-MARKSURVEYING.COM**

**LOT 5 AND LOT 6 OF INDIAN HILLS SUBDIVISION,
LOCATED IN THE VILLAGE OF FONTANA-ON-GENEVA
LAKE, WALWORTH COUNTY, WISCONSIN.**

ORDERED BY: SCHAUDER BUILDING, INC.
4115 HWY 51 NORTH
JANESVILLE, WI 53545

SITE ADDRESS: 720 ADAHI WAY

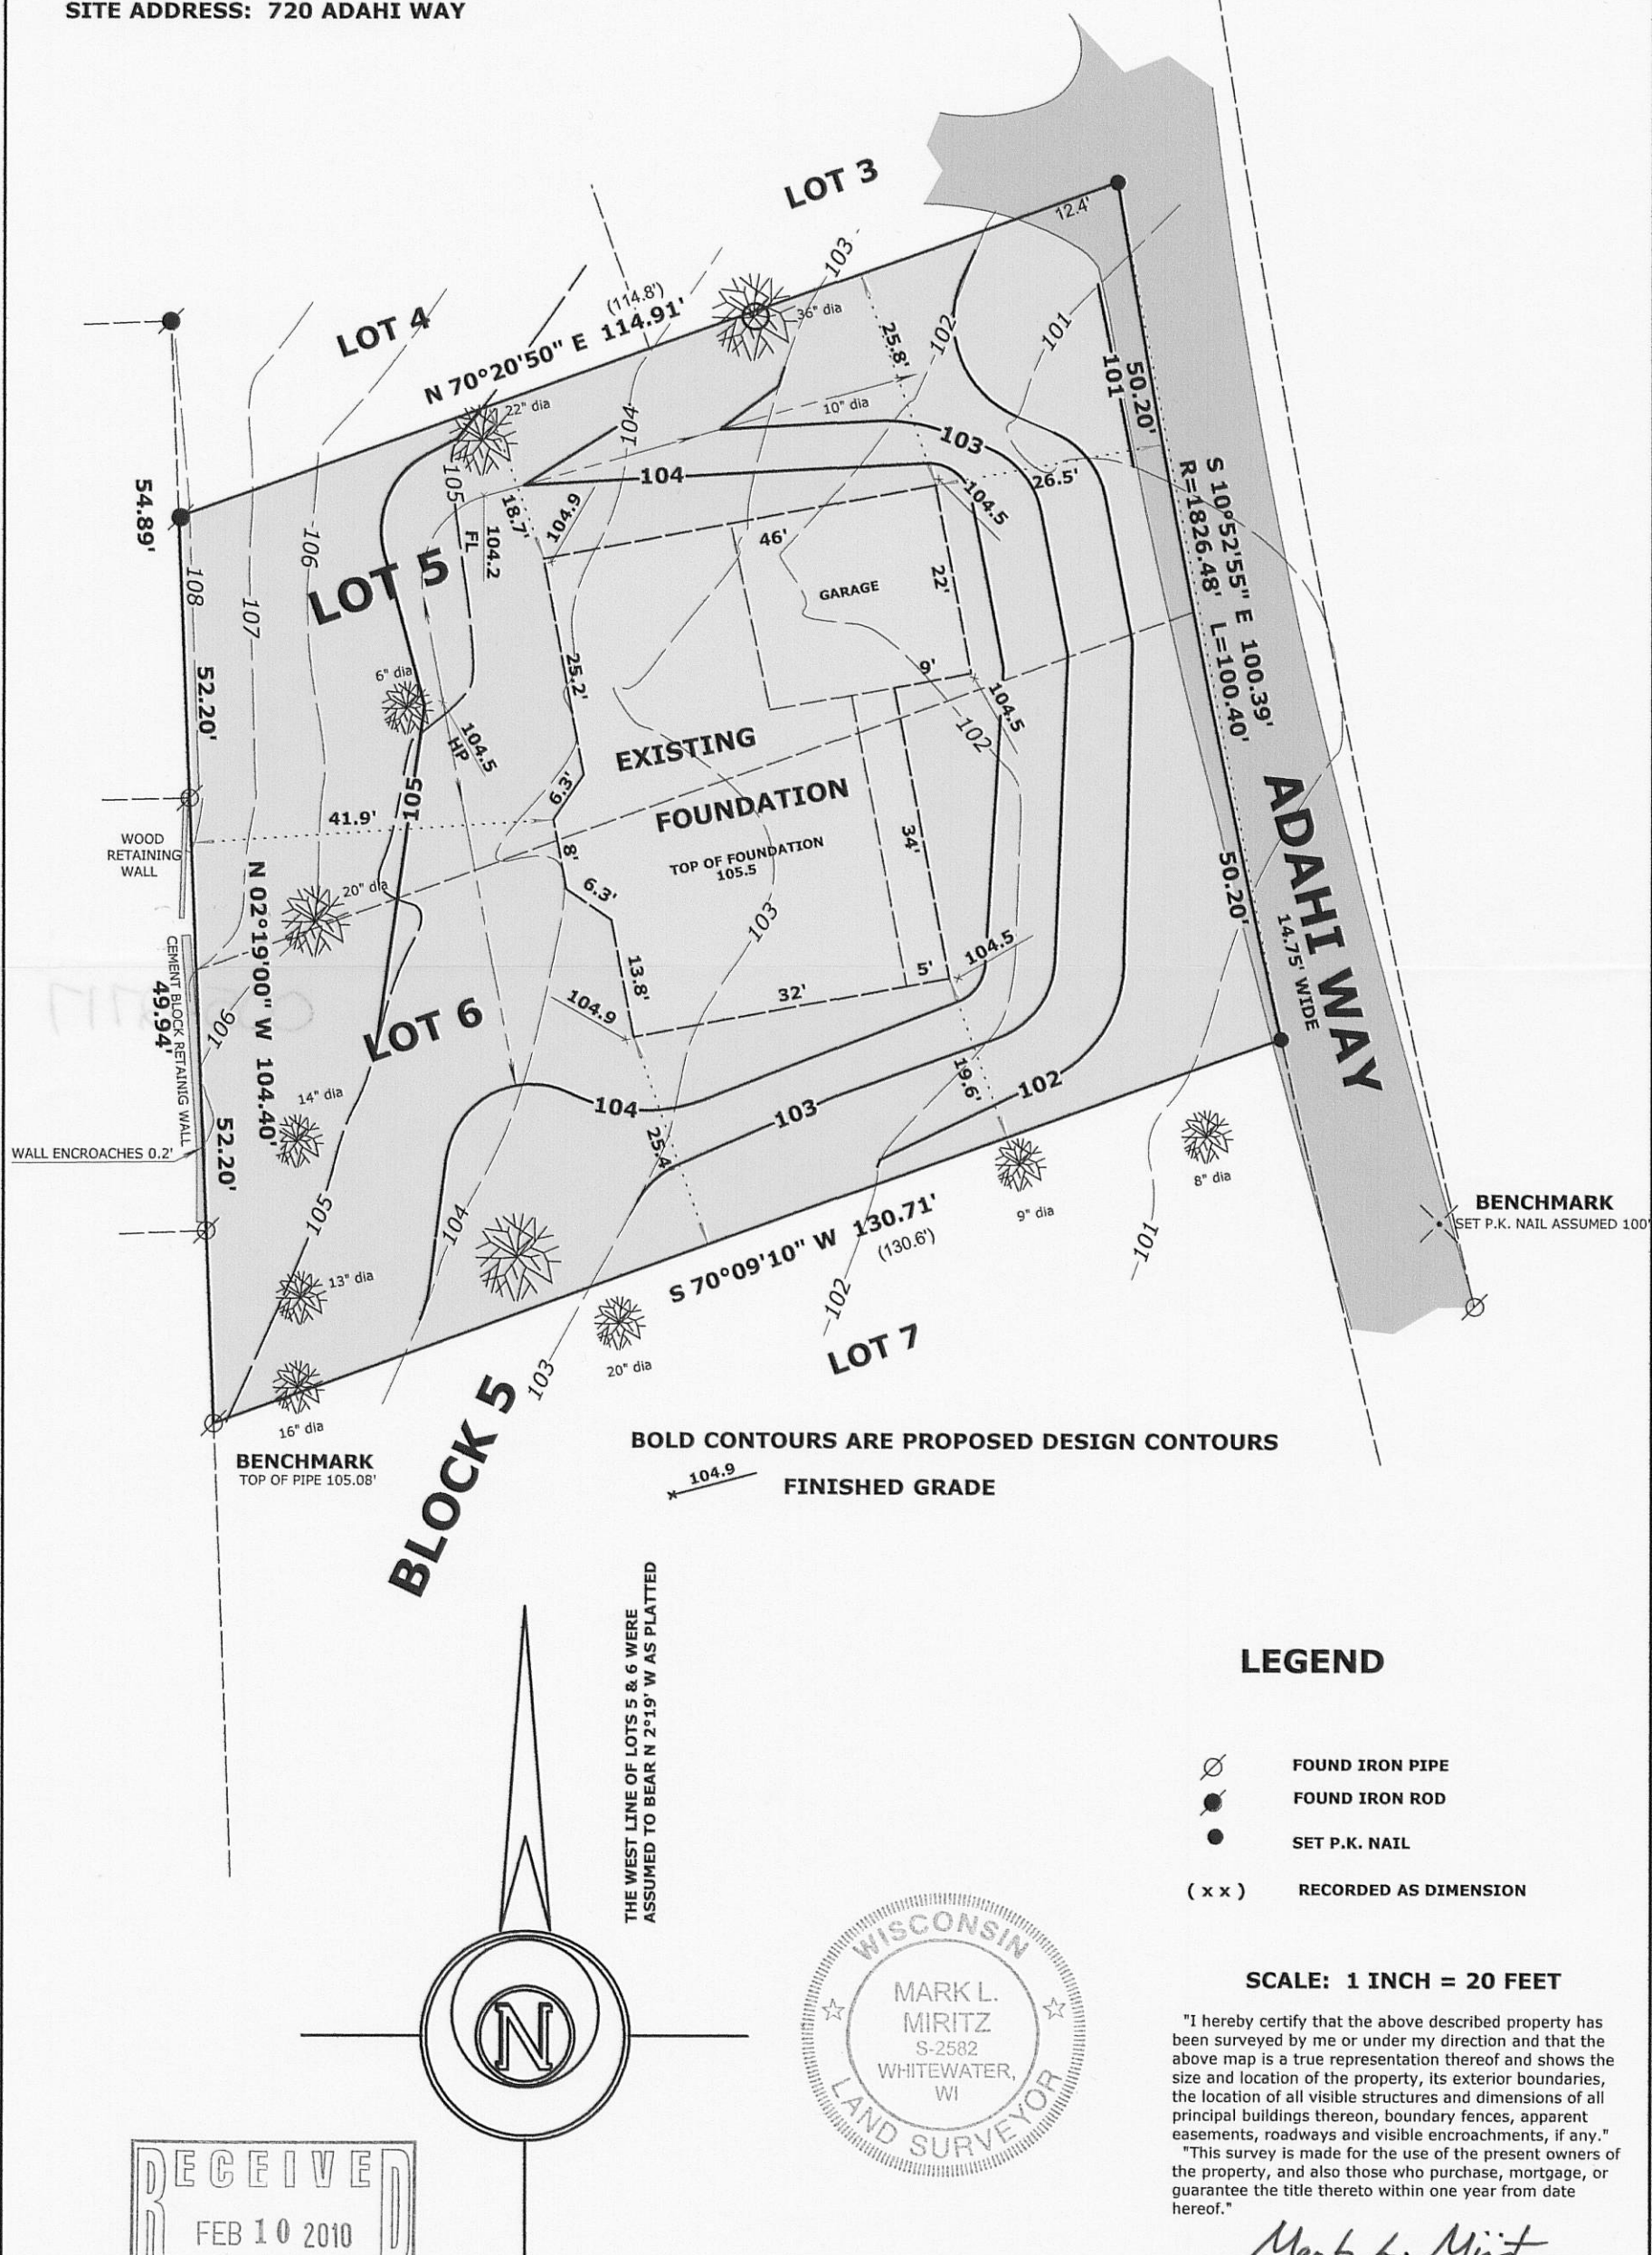

RECEIVED
FEB 10 2010
By *SMF*

REVISED DEC. 8, 2009 TO SHOW FOUNDATION "AS BUILT"

DATE: OCT. 29, 2009 JOB NO. 09.903