


PREPARED FOR
 ICON DEVELOPMENT GROUP
 2413 W. ALGONQUIN RD.
 SUITE 247
 ALGONQUIN IL. 30102

PLAT OF

KROTT SURVEYING INC.



N3705 WILLOW BEND LANE
 LAKE GENEVA WI. 53147
 PHONE # (262)248-3697
 FAX # (262)249-0639

ALL THAT PART OF THE SOUTHWEST 1/4 OF SECTION 18, TOWN 1 NORTH, RANGE 17 EAST, VILLAGE OF FONTANA-ON-GENEVA LAKE, WALWORTH COUNTY, WISCONSIN BOUNDED AND DESCRIBED AS FOLLOWS:
 COMMENCING AT THE SOUTHWEST CORNER OF BROOKWOOD SUBDIVISION, WHICH POINT IS S 0°42' E 744.22 FEET OF THE WEST 1/4 SECTION CORNER OF SAID SECTION 18 AND RUN THENCE S 0°42' E 375.86 FEET TO THE PLACE OF BEGINNING OF THE PARCEL OF LAND HEREINAFTER DESCRIBED; THENCE CONTINUING S 0°42' E 401.84 FEET; THENCE S 89°57' E 80.00 FEET; THENCE N 45°15'30" E 399.39 FEET; THENCE N 24°28'30" W 222.16 FEET; THENCE S 73°32' W 288.10 FEET TO THE PLACE OF BEGINNING.

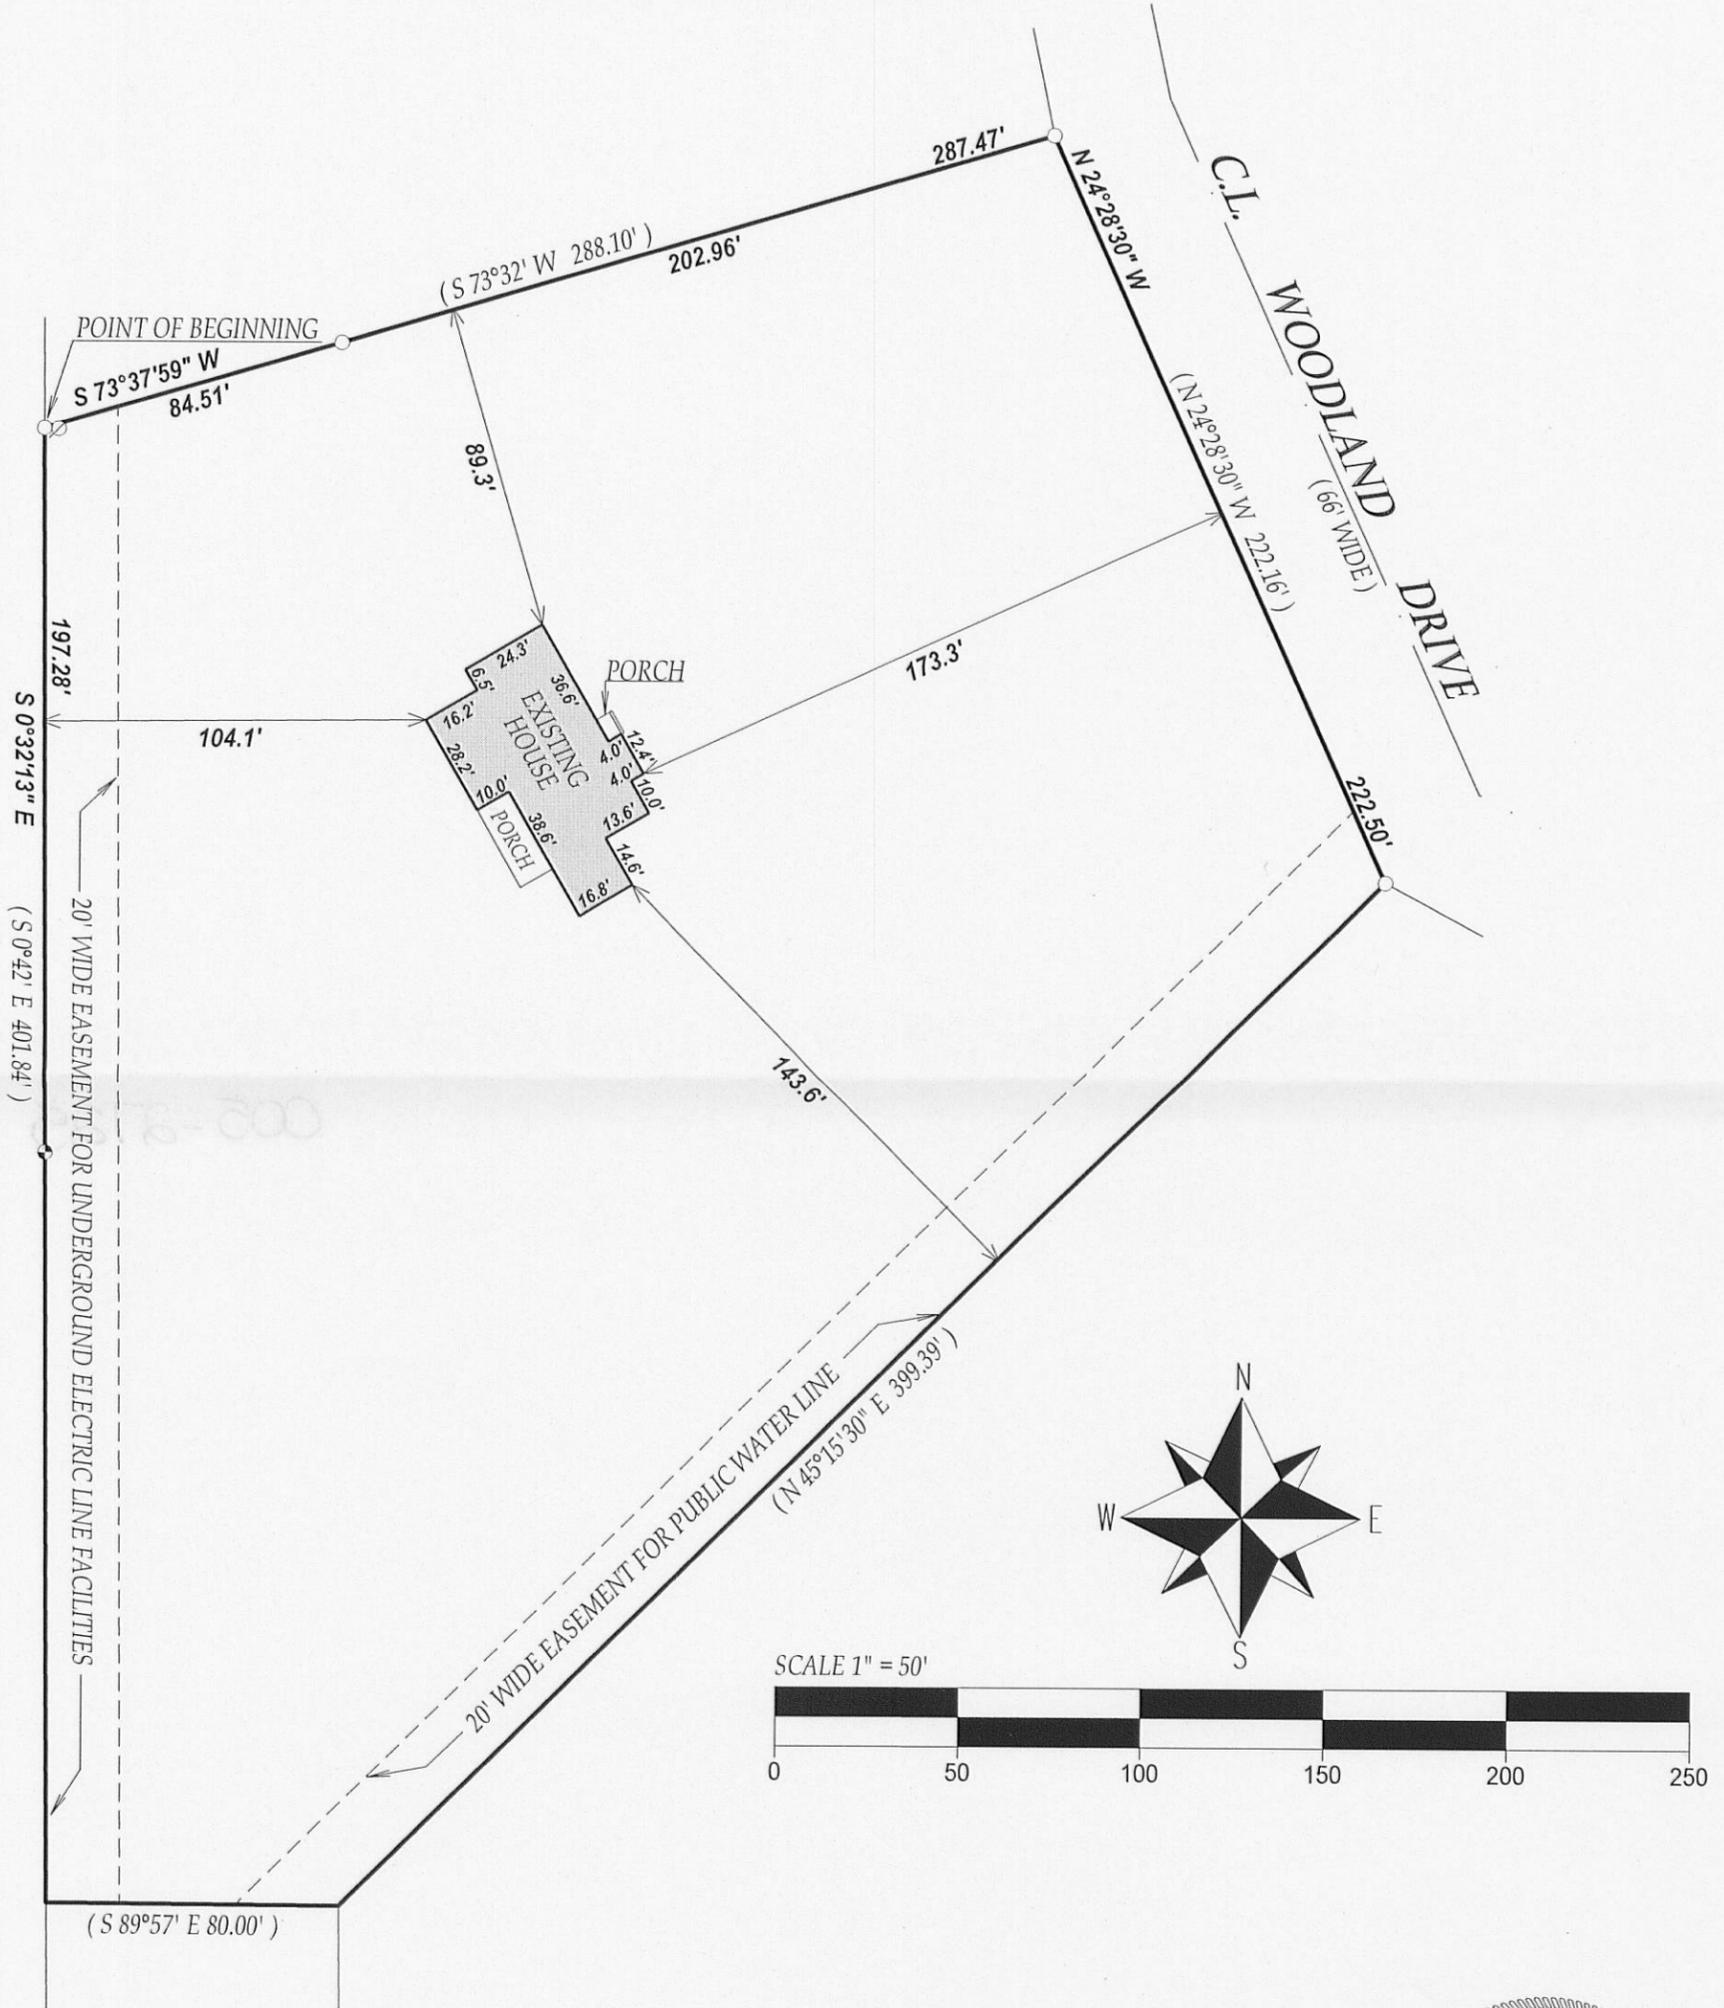

LEGEND

- FOUND IRON PIPE
- FOUND CONCRETE MONUMENT
- UTILITY POLE
- (xx) RECORDED AS
- TAX ID # SUP0001L
- JOB # 10-007

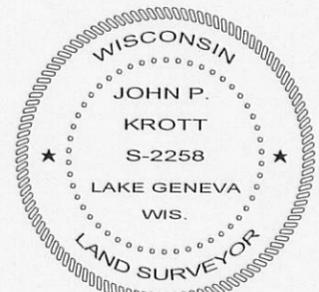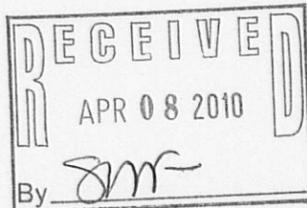

DATED THIS 18th DAY OF JANUARY 2010.

John P. Krott
 JOHN KROTT S - 2258
 Wisconsin Registered Land Surveyor
 (original if signed in red)

NOTE: BEARINGS ARE REFERENCED TO THE DEED OF RECORD AND WOODLAND DR. WAS ASSUMED TO BEAR N 24°28'30" W.

005-2725-9192