PREPARED FOR: NANCY SWATEK KEEFE REAL ESTATE, INC. 751 GENEVA PARKWAY LAKE GENEVA, WI 53147


PLAT OF SURVEY

-OF-


THE NORTH SEVENTY (70) FEET OF LOT NO. SEVENTEEN (17) AND THE SOUTH TEN (10) FEET OF LOT NO. EIGHTEEN (18) OF PEARSON SUBDIVISION, LOCATED IN THE SW 1/4 OF THE NORTHEAST 1/4 OF SECTION 35, TOWN 2 NORTH, RANGE 17 EAST, CITY OF LAKE GENEVA, WALWORTH COUNTY, WISCONSIN.

KROTT SURVEYING INC.

N3705 WILLOW BEND LANE LAKE GENEVA WI. 53147 PHONE # (262)248-3697 FAX # (262)249-0639

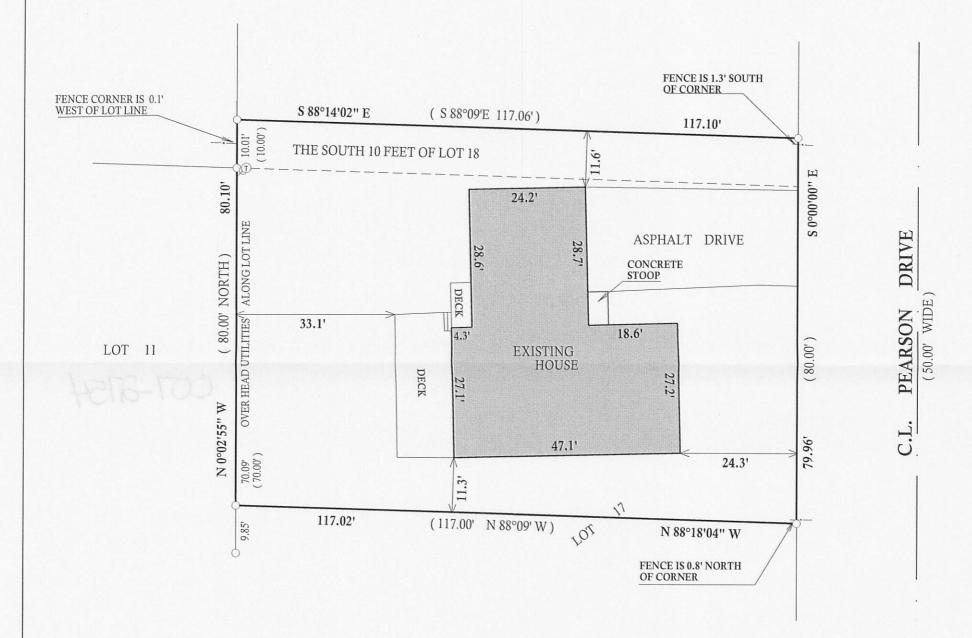



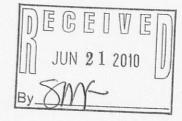

LEGEND

- Ø UTILITY POLE
- ① TELEPHONE PEDESTAL
- O FOUND IRON PIPE
- □ FOUND IRON BAR
- SET IRON BAR

(XX) RECORDED AS

JOB # 10-091

TAX ID # ZP00017A

I have surveyed the above-described property and the above map is a true representation thereof and shows the size and location of the property, its exterior boundaries, the location and dimensions of all structures thereon, fences apparent easements and roadways and visible encroachments. if any.

This survey is made for the exclusive use of the present owners of the property, and also those who puchase, mortgage, or insure the title therto within one (1) year from date hereof; and as to them I warrant the accuracy of said survey map.



DATED THIS 7th, DAY OF JUNE, 2010

JOHN KROTT S - 2258

Wisconsin Registered Land Surveyor (original if signed in red)

007-2751