

PREPARED FOR
JORNDT - FAHEY REMODELING
168 ELKHORN RD.
WILLIAMS BAY, WI 53191


PLAT OF SURVEY

OF


UNIT 94 OF ABBEY SPRINGS CONDOMINIUM NO. 3 LOCATED
IN THE SOUTH 1/2 OF SECTION 13, TOWN 1 N ORTH, RANGE
16 EAST, VILLAGE OF FONTANA-ON-GENEVA LAKE,
WALWORTH COUNTY, WISCONSIN.

KROTT SURVEYING INC.

N3705 WILLOW BEND LANE
LAKE GENEVA WI. 53147
PHONE # (262)248-3697
FAX # (262)249-0639

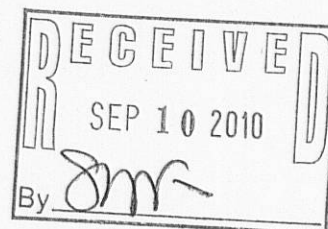

C.L. MEDINAH LANE

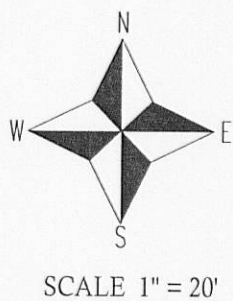

LEGEND

(XXX) RECORDED AS

- FOUND IRON PIPE
- ⊙ UTILITY PEDSTAL
- ⊙ GAS METER
- ⊙ ELECTRIC METER


TAX ID # SCDB3000094

JOB # 09-127AB

NOTE BEARINGS REFERENCED TO THE
ABBIE SPRINGS CONDOMINIUM PLAT
NO. 3

I have surveyed the above-described property and the above map is a true representation thereof and shows the size and location of the property, its exterior boundaries, the location and dimensions of all structures thereon, fences apparent easements and roadways and visible encroachments, if any.

This survey is made for the exclusive use of the present owners of the property, and also those who purchase, mortgage, or insure the title thereto within one (1) year from date hereof; and as to them I warrant the accuracy of said survey map.

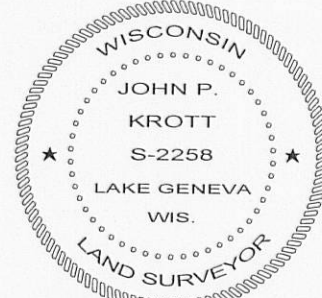

DATE OF LAST REVISION 09 / 08 / 2010
REVISED 9 / 28 / 2009
DATED THIS 16th, DAY OF SEPTEMBER, 2009

JOHN KROTT S - 2258
Wisconsin Registered Land Surveyor
(original if signed in red)