


WALWORTH COUNTY
SURVEYING & MAPPING
P. O. BOX 1115
LAKE GENEVA, WISCONSIN
414-248-0505

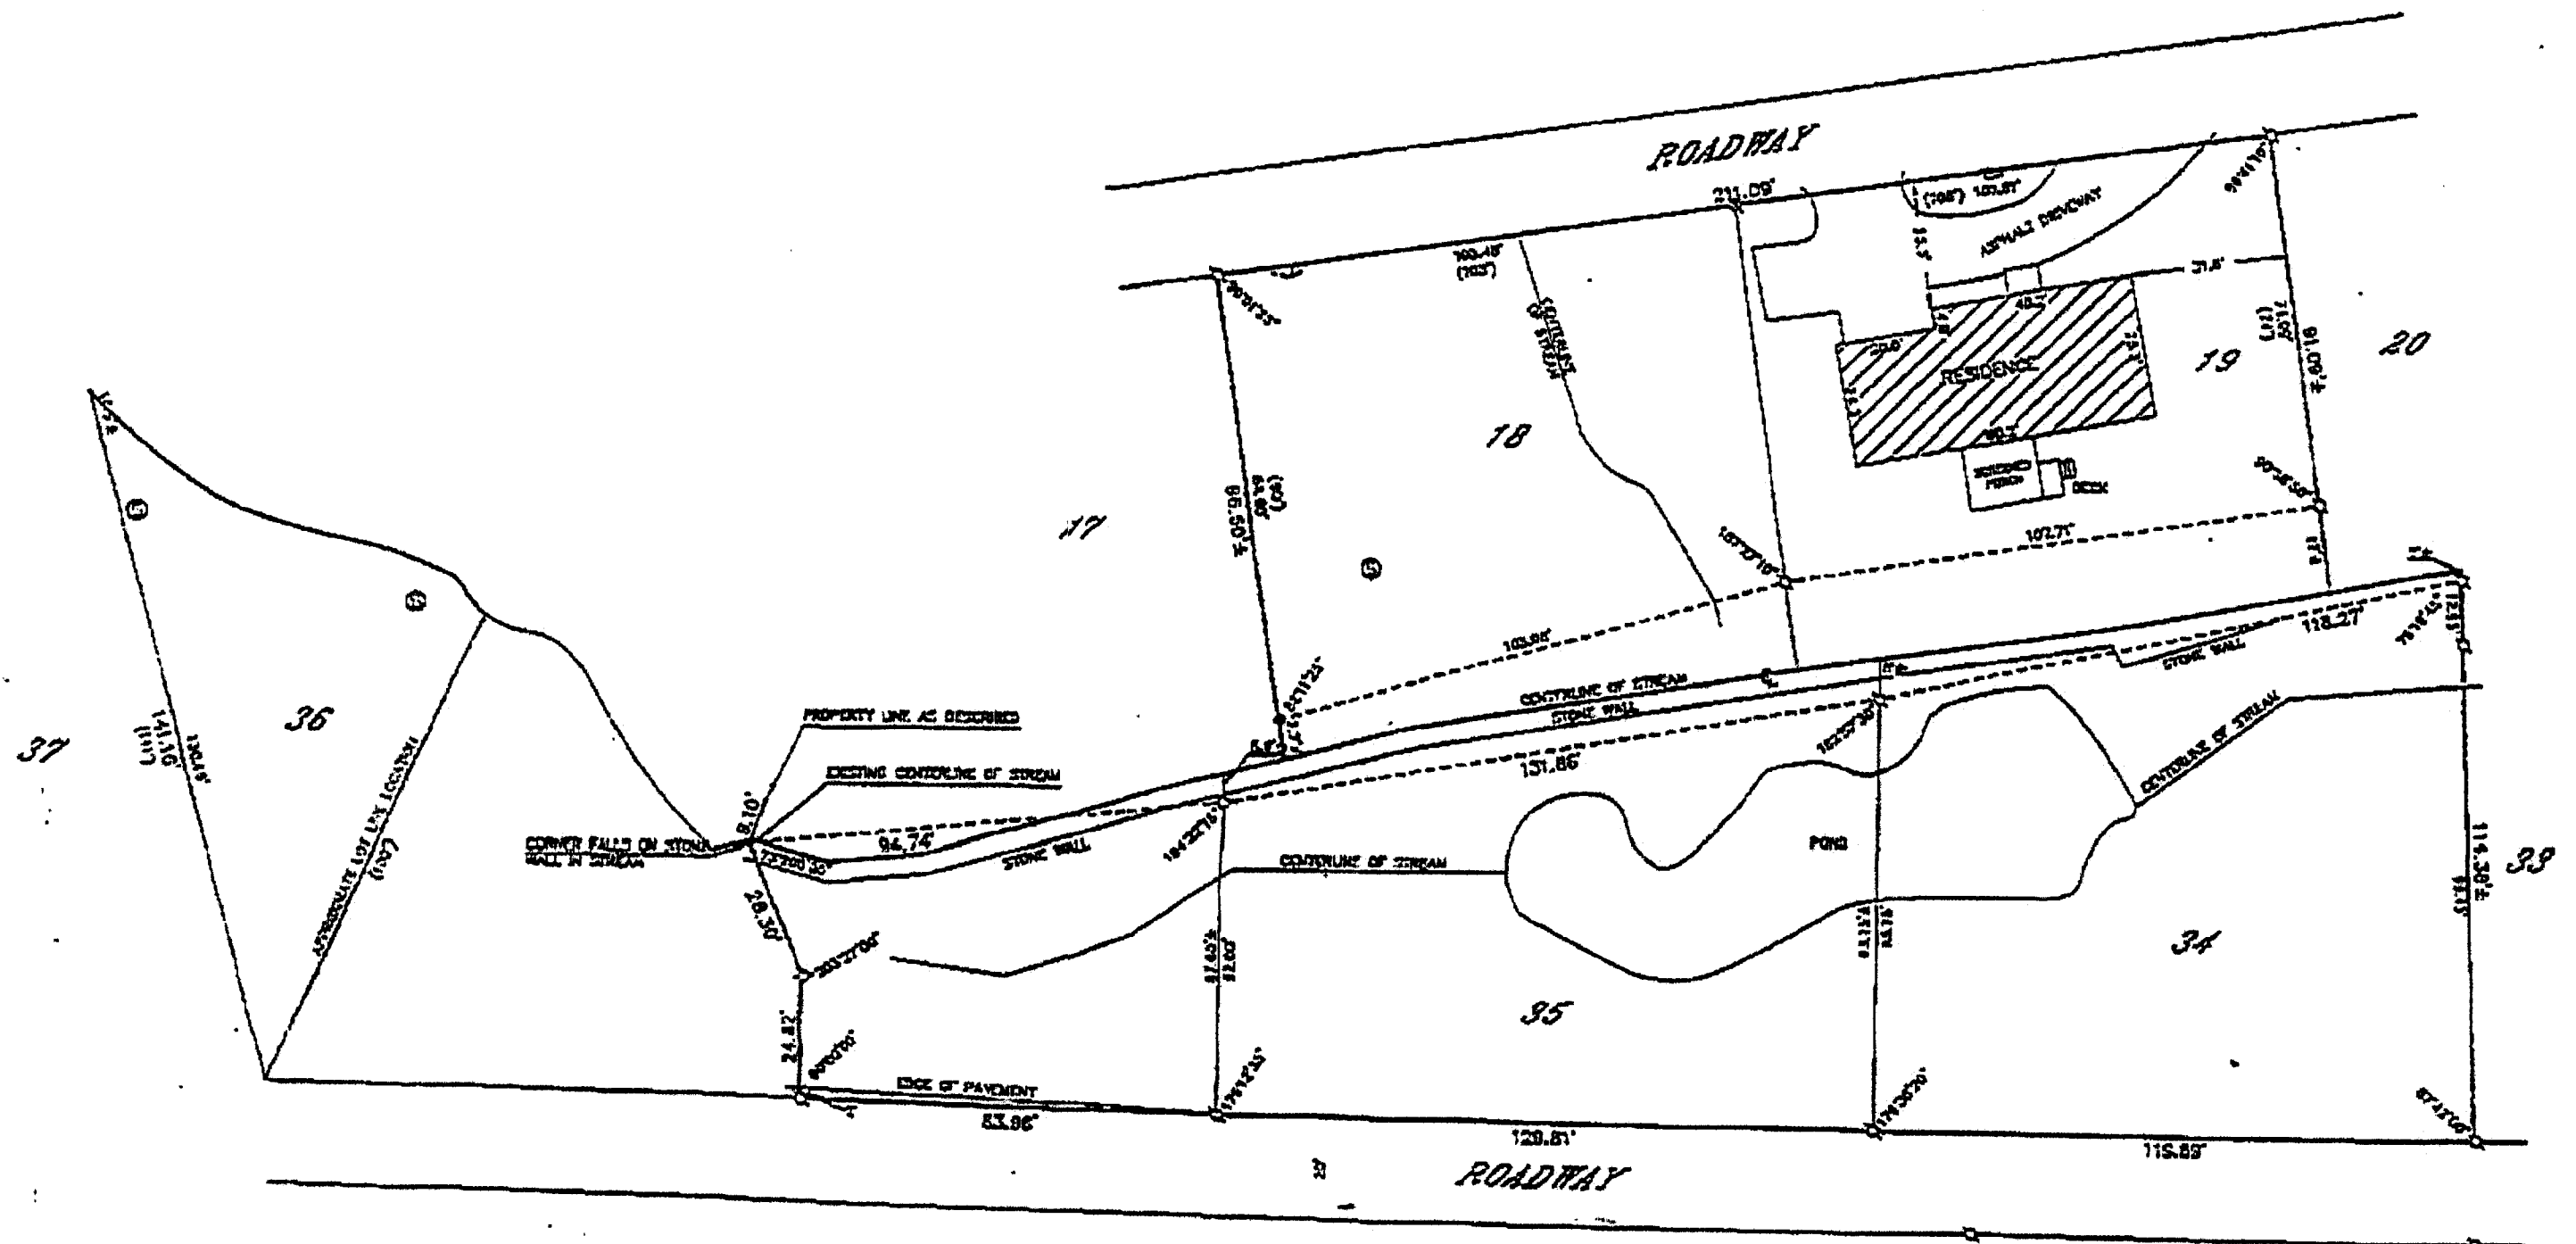


PLAT OF SURVEY OF

PARCEL 1:
LOTS 18 AND 19 IN THE GARDENS, ACCORDING TO THE REVISED PLAT THEREOF
RECORDED ON JUNE 8, 1927 IN VOLUME 8 OF PLATS AT PAGE 121, AS DOCUMENT
NO 2638718 AND BEING PART OF SECTION 17, IN T 1 N. R 16 E. IN THE VILLAGE OF
FONTANA-ON-GENEVA LAKE, WALWORTH COUNTY, WISCONSIN.

PARCEL 2:
AN UNDIVIDED 1/2 INTEREST IN THE FOLLOWING DESCRIBED PROPERTY: LOTS 34
35 AND 36 IN THE GARDENS SUBDIVISION, VILLAGE OF FONTANA-ON-GENEVA LAKE,
WALWORTH COUNTY, WISCONSIN, ALSO PARCEL BOUNDED ON WEST BY PUBLIC
ROAD, ON SOUTH BY LOT 35, ON EAST BY LOT 17, ON NORTH BY A LINE
COMMENCING ON THE NORTHERLY LINE OF ROAD 84 FEET NORTHWESTERLY FROM
WESTERLY CORNER OF LOT 35, NORTHEASTERLY AT RIGHT ANGLE 24.82 FEET,
THENCE LEFT 23°27' 28.3 FEET, THENCE TO THE RIGHT 41°31' 5.1 FEET TO
CENTER OF BROOK.

ORDERED BY: KEEFE REAL ESTATE
751 GENEVA PARKWAY
LAKE GENEVA, WISCONSIN
53147

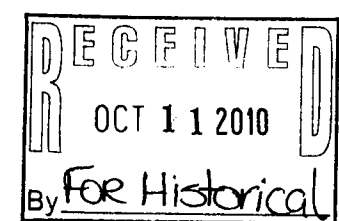


I HEREBY CERTIFY THAT I HAVE SURVEYED THE ABOVE DESCRIBED
PROPERTY AND THAT THE ABOVE MAP IS A TRUE REPRESENTATION
THEREOF AND SHOWS THE SIZE AND LOCATION OF THE PROPERTY
AND CONTAINS ALL NECESSARY INFORMATION FOR THE PURPOSES
AND PURPOSES OF ALL PERSONS INTERESTED THEREIN. I HAVE
ALSO APPROPRIATELY DESCRIBED ADJACENT AND NEARBY ESTATE
NOTES, IF ANY, TO THE BEST OF MY KNOWLEDGE AND BELIEF.

THIS SURVEY IS MADE FOR THE USE OF THE PRESENT OWNERS OF
THE PROPERTY AND ALSO THEIR HEIRS AND SUCCESSORS OR
ASSIGNEES. THE TITLE HEREON IS NOT A GUARANTEE OF THE
TITLE.

Robert M. Bausch
ROBERT M. BAUSCH
WISCONSIN REGISTERED LAND SURVEYOR, S-1234

DATE: *June 30, 2004*
BY: *[Signature]*
NOTES: THIS IS NOT A CONTROLLED COPY UNLESS SEALED.

GRAPHIC SCALE

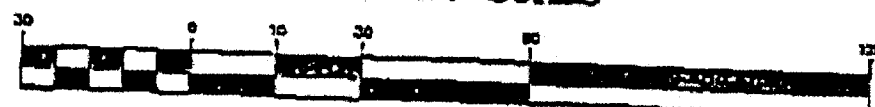

- (IN FEET)
- 1 inch = 30 ft.
- ⊕-IRON PIPE FOUND
- ⊕-IRON ROD FOUND
- ⊕-CONCRETE MONUMENT FOUND
- ⊕-IRON PIPE PLACED
- ⊕-RECORDED AS
- ⊕-SANITARY MANHOLE
- ⊕-UTILITY POLE