


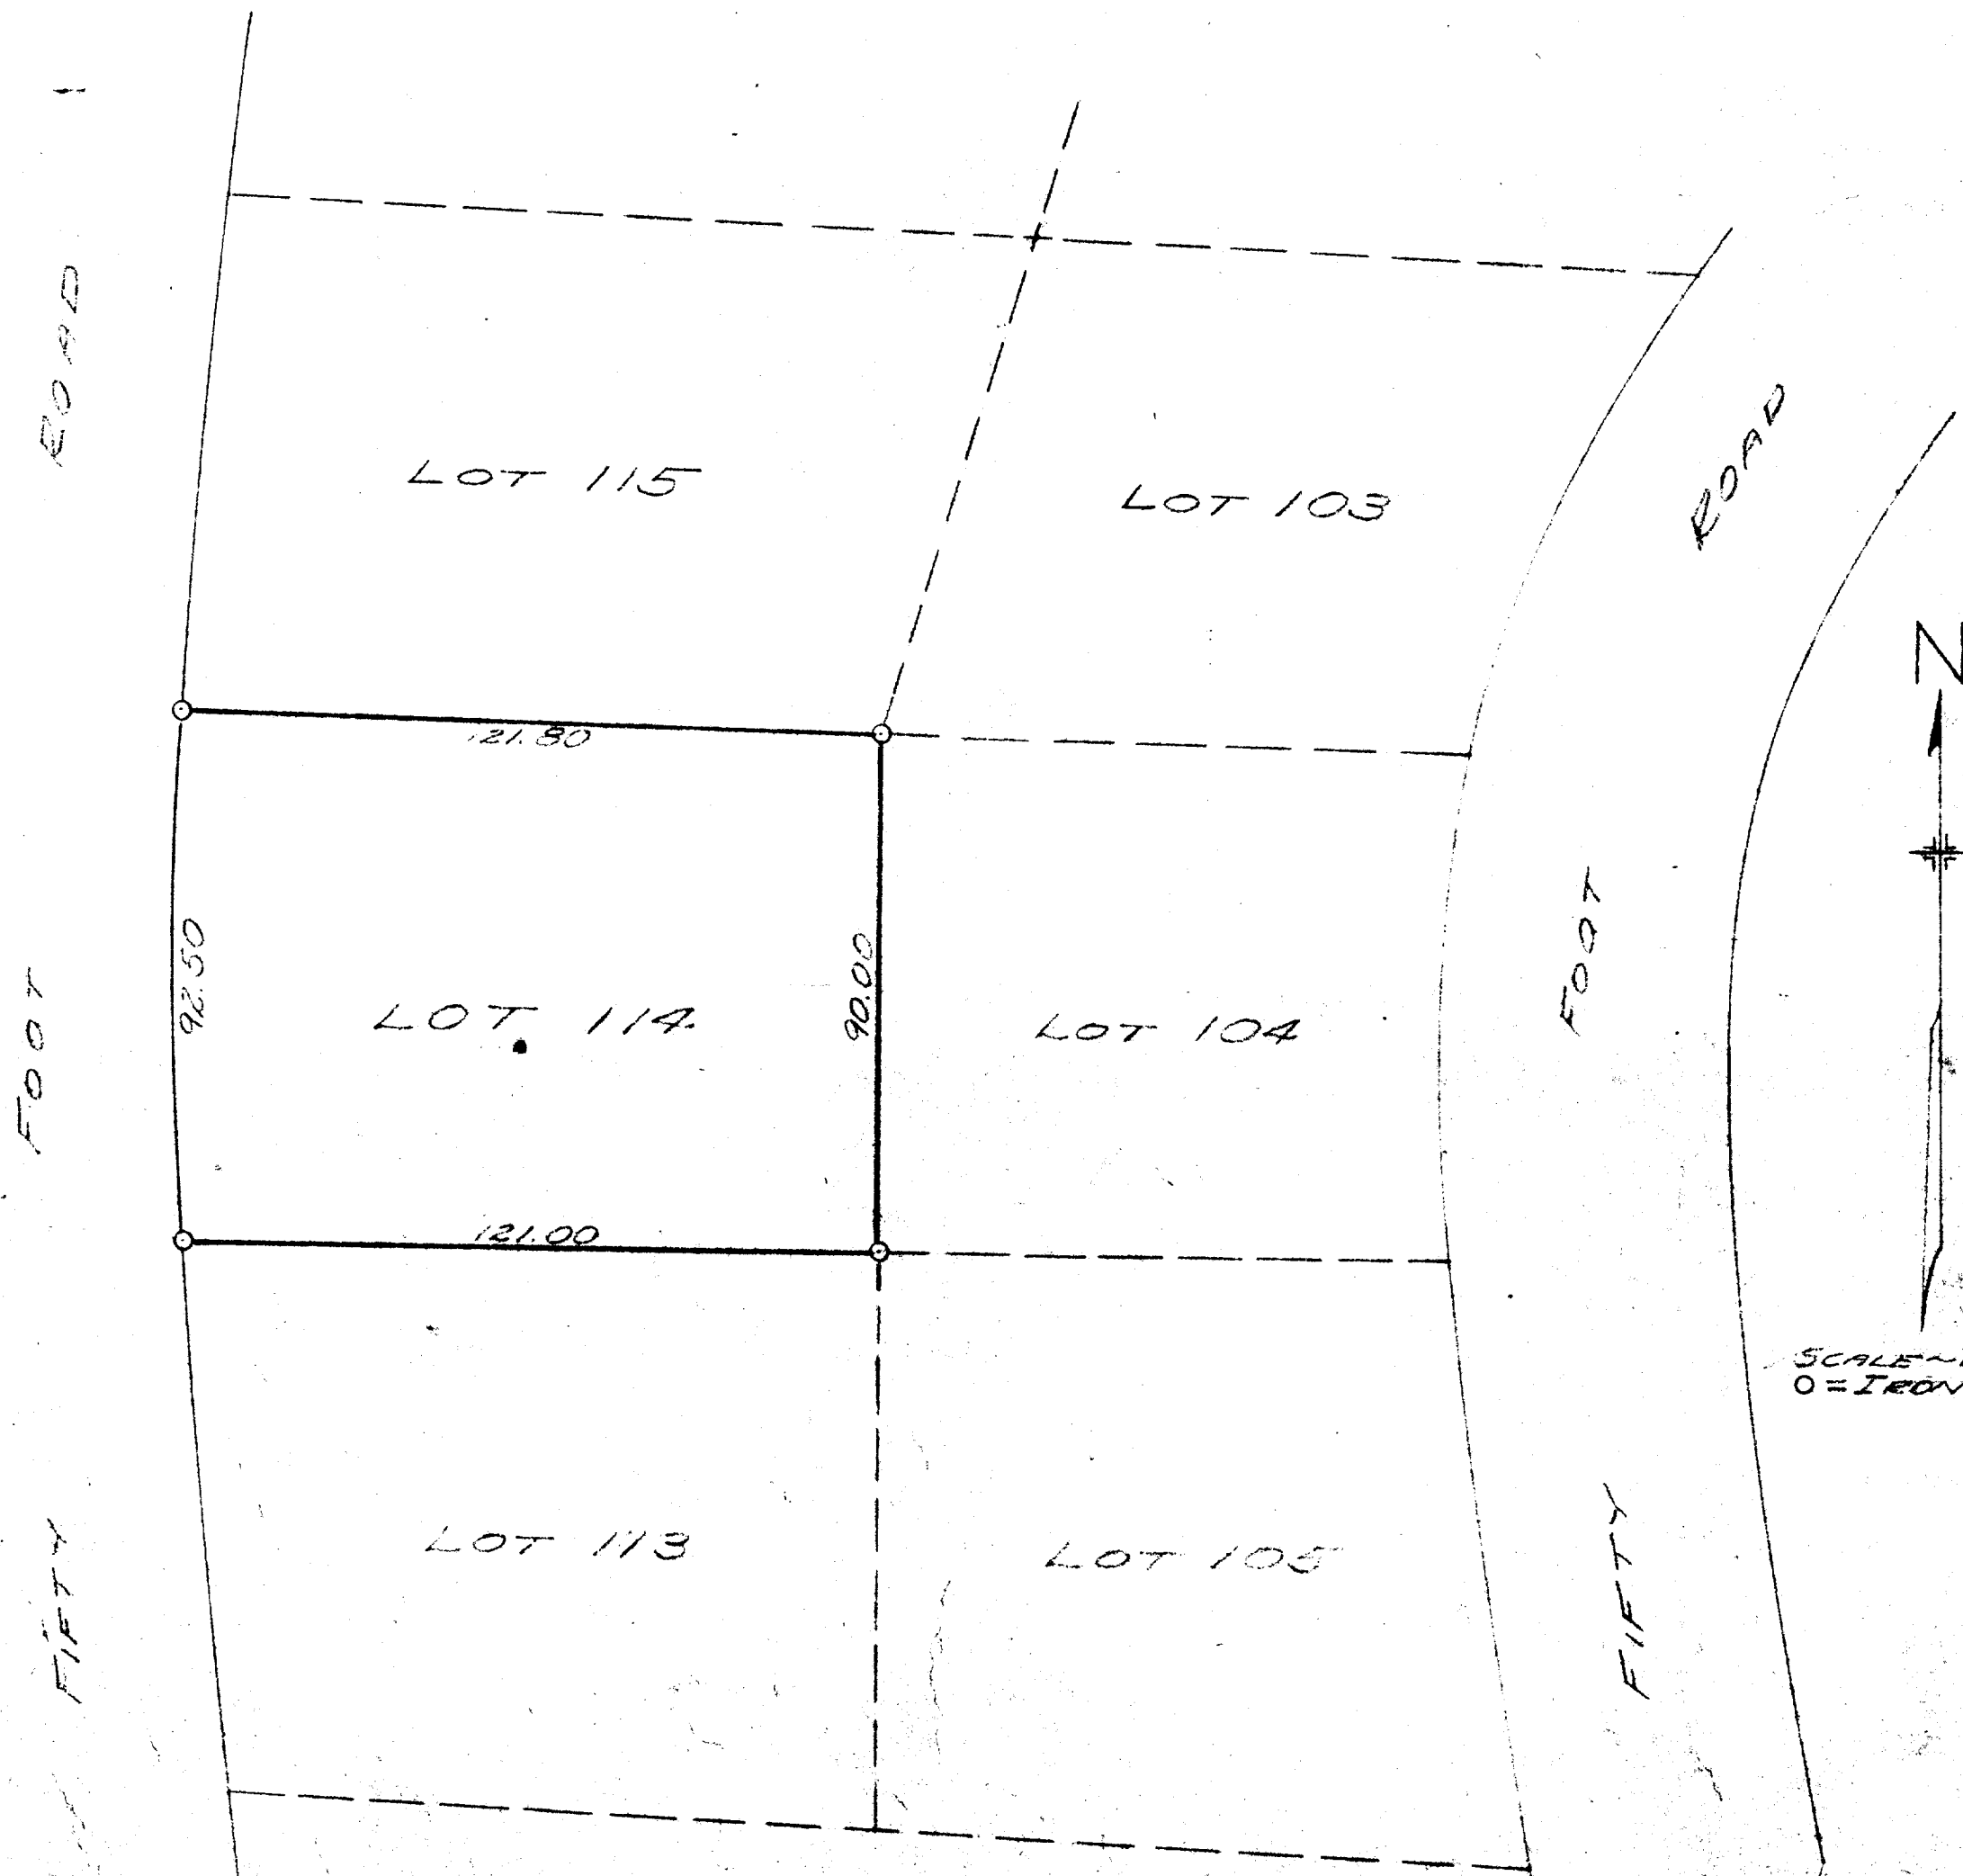

PLAT OF SURVEY OF LOT 114 OF UNIT 2 OF COUNTRY CLUB ESTATES, A SUBDIVISION LOCATED IN SECTIONS 18 AND 23 T1N, R1E OF WALWORTH COUNTY, WISCONSIN.
NOV. 23, 1945

Lloyd L. Jensen
COUNTY SURVEYOR

5-273

5802-108