PREPARED FOR FRED GELDERMANN REMAX GENEVA REALTY 101 BRAOD ST. SUITE 102 LAKE GENEVA WI 53147

## SURVEY OF PLAT

-OF-


OF FONTANA-ON- GENEVA LAKE, WALWORTH COUNTY,


WISCONSIN.

LOTS 22 AND 23, BLOCK 6 INDIAN HILLS SUBDIVISION BEING LOCATED IN SECTION 14 TOWN 1 NORTH, RANGE 16 EAST, VILLAGE

KROTT SURVEYING INC. N3705 WILLOW BEND LANE

LAKE GENEVA WI. 53147 PHONE # (262)248-3697 FAX # (262)249-0639

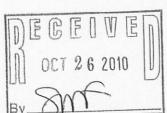

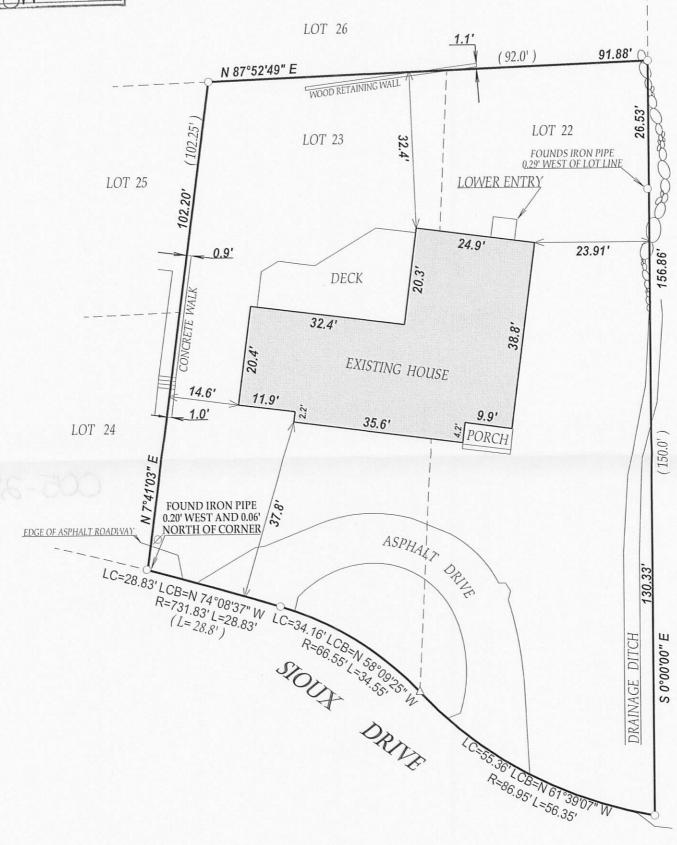


LEGEND

O FOUND IRON PIPE

△ FOUND P.K. NAIL

Ø UTILITY POLE


(XX) RECORDED AS TAX (D # SIHB00015 JOB # 10-150

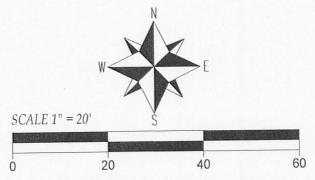

I have surveyed the above-described property and the above map is a true representation thereof and shows the size and location of the property, its exterior boundaries, the location and dimensions of all structures thereon, fences apparent easements and roadways and visible encroachments. if any.

This survey is made for the exclusive use of the present owners of the property, and also those who puchase, mortgage, or insure the title therto within one (1) year from date hereof; and as to them I warrant the accuracy of said survey map.

NOTE : THE EAST LINE OF LOT 22 WAS ASSUMED TO BEAR SOUTH.

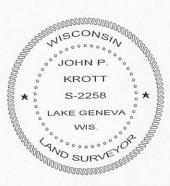

DATED THIS 14th DAY OF SEPTEMBER 2010.



JOHN KROTT S - 2258 Wisconsin Registered Land Surveyor (original if signed in red)

