

West 1/4 Corner
Section 18-1-17.

(S0°42'E 744.22')

Southwest Corner
Brookwood Subd.

(East 286.52')

(66.01')
65.90'
(67.44')

Lot 1

Lot 2

Lot 3

B l o c k
B r o o k w o o d S u b d i v i s i o n

(East 325.77')
325.62'
99.87'
(100.00')

Overhead Wires

81.56'
(81.66')

18.41'
(18.34')

Property Corner is 0.72'
East of a found Iron Pipe
marking the Southwest
Corner of Lot 1 of Block 5
of Brookwood Subdivision.

(144.82')
144.91'
144.19'

Plat of Survey


of

A parcel of land described in a Warranty Deed recorded August 4, 1971 in Vol. 52 on Page 399 as Document No. 639014, as shown below:

Parcel 11: All that part of the SW 1/4 of Section 18, T1N, R17E, Walworth County, Wisconsin bounded and described as follows: Commencing at the Southwest Corner of Brookwood Subdivision which point is S 0 degrees 42' E 744.22 feet of the West 1/4 Section Corner of said Section 18 and run thence Due East along the South line of said Subdivision 286.52 feet to the place of beginning of the parcel of land hereinafter described: then continue Due East along said line 325.77 feet; thence S 15 degrees 28' E 161.60 feet; thence S 69 degrees 17' W 332.67 feet; thence N 11 degrees 52' W 279.41 feet to the place of beginning, containing 1.6 acres of land.

Surveyed for:

John Bohm
P.O. Box 125
Williams Bay, Wisconsin. 53191

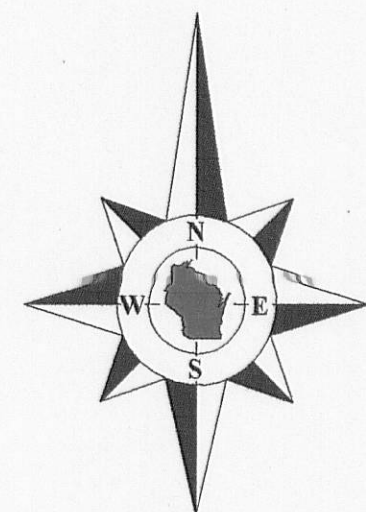

Bearings referenced to the South line
of Brookwood Subdivision which is
recorded as East.

Copyright 2011 by Jensen & Olson Land Surveying, LLC.

All rights reserved. No part of this survey plat may be reproduced or transmitted in any form by any means - graphic, electronic, or mechanical, including photocopying, tracing, or information storage and retrieval systems - without permission in writing from Douglas G. Olson, Jensen & Olson Land Surveying, LLC.

I hereby certify that I have surveyed the above described property and the map hereon is correct to the best of my professional knowledge and belief and shows the size and location of the property, its exterior boundaries, the location and dimensions of all visible structures thereon, boundary fences, apparent easements and roadways and visible encroachments, if any.

This survey is made for the exclusive use of the present owners of the property, and also those who purchase, mortgage or guarantee title thereto, within one year from the date hereof.

Douglas G. Olson
Wisconsin Registered Land Surveyor - 2093

Woodland Drive
(66' Wide)



N11°51'19"W 279.35'
(111°22' N 29°11' E 279.11')

**Tax Parcel
SUP 00001B**

1.636 Acre
71,258 Sq.Ft.

**Tax Parcel
SUP 00001I**

**Tax Parcel
SUP 00001E**

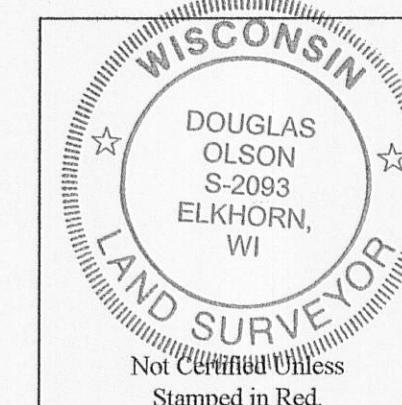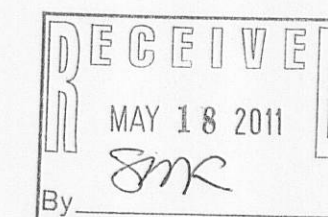


Notes:

- 1) This survey plat is not certified unless signed and sealed in red ink.
- 2) This survey is subject to Wisconsin lien laws. This Plat of Survey is the notice of intent to file lien. Lien waiver required.

Survey Date: April 12, 2011.
Revisions:

Scale in Feet
1" = 30'

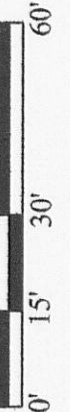

Jensen & Olson Land Surveying, LLC

45 South Wisconsin Street * P.O. Box 322 * Elkhorn, Wisconsin. 53121
Telephone: (262) 723-3434 * Facsimile: (262) 723-8044
Email: jensen.olson@elknet.net

Legend

- Found Iron Pipe
- Recorded Information
- Utility Pole
- Utility Box or Pedestal
- Manhole
- Asphalt Surface
- Concrete Surface

Sheet 1 of 1 Sheets
Drawing Name: Unit 7-2011016-2011016P1a.sgi

Job Reference Number
2011.016

2011.016