

LAND-MARK SURVEYING

Mark L. Miritz

Wisconsin Registered Land Surveyor S-2582

N9330 Knuteson Drive
Whitewater, WI 53190
Phone: (262) 495-3284
FAX: (262) 495-8421
LAND-MARKSURVEYING.COM

PLAT OF SURVEY

LOT 5 OF GLENWOOD TERRACE SUBDIVISION

LOCATED IN THE NORTH 1/2 OF THE NORTHEAST 1/4
OF THE NORTHEAST 1/4 OF SECTION 22, TOWN 1 NORTH,
RANGE 16 EAST, VILLAGE OF FONTANA - ON - GENEVA
LAKE, WALWORTH COUNTY, WISCONSIN.

ORDERED BY: CHRIS HUMMEL
HUMMEL BUILDERS
N1958 COUNTY "O"
DELAVER, WI. 53115

30

31

32

(FOREST DRIVE)

FOREST GLEN ROAD 40' WIDE

S 87°28'07" W
71.93'

71.93'

15' WIDE EASEMENT
FOR DRAINAGE DITCH
AND UTILITIES

WATER STOP BOX

54.1'

LOT 5
13,878 S.F.

14.9'

12'

12'

28.3'

29.5'

14.9'

14.9'

4'

36.7'

EXISTING
FOUNDATION

31'

S 02°37'59" E 192.97'

10'

5'

9'

14.9'

4.2'

8'

4.2'

N 02°38'00" W 192.91'

6


4

BASIS FOR BEARINGS
THE NORTH LINE OF GLENWOOD
TERRACE SUBDIVISION WAS
ASSUMED TO BEAR N 87°28'E
TO MATCH EXISTING SURVEYS
IN THIS SUBDIVISION.

LEGEND

FOUND IRON PIPE

FOUND IRON ROD

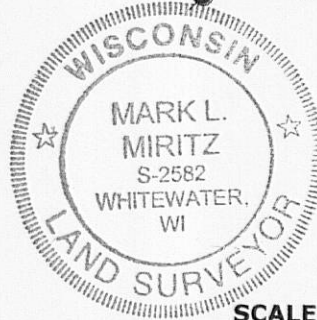

SCALE: 1 INCH = 20 FEET


"I hereby certify that the above described property has been surveyed by me or under my direction and that the above map is a true representation thereof and shows the size and location of the property, its exterior boundaries, the location of all visible structures and dimensions of all principal buildings thereon, boundary fences, apparent easements, roadways and visible encroachments, if any."
"This survey is made for the use of the present owners of the property, and also those who purchase, mortgage, or guarantee the title thereto within one year from date hereof."

MARK L. MIRITZ

WISCONSIN REGISTERED
LAND SURVEYOR S-2582

DATE: SEPT. 10, 2004 JOB NO. 04.903

REVISED AUGUST 23, 2011 TO
SHOW PROPOSED RESIDENCE
REVISED OCT. 3, 2011 TO SHOW
FOUNDATION "AS BUILT"

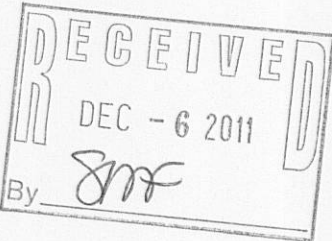

SOUTH LINE OF GLENWOOD TERRACE SUBD.

SGT-2B

005-2873