

PREPARED FOR
JASON BERNARD
201 BROAD ST.
LAKE GENEVA WI 53147


PLAT OF SURVEY

-OF-

LOT 1, BLOCK 1 BROOKWOOD SUBDIVISION, LOCATED IN THE VILLAGE OF
FONTANA - ON - GENEVA LAKE, WALWORTH COUNTY, WISCONSIN.

KROTT SURVEYING INC.

N3705 WILLOW BEND LANE
LAKE GENEVA WI. 53147
PHONE # (262)248-3697
FAX # (262)249-0639

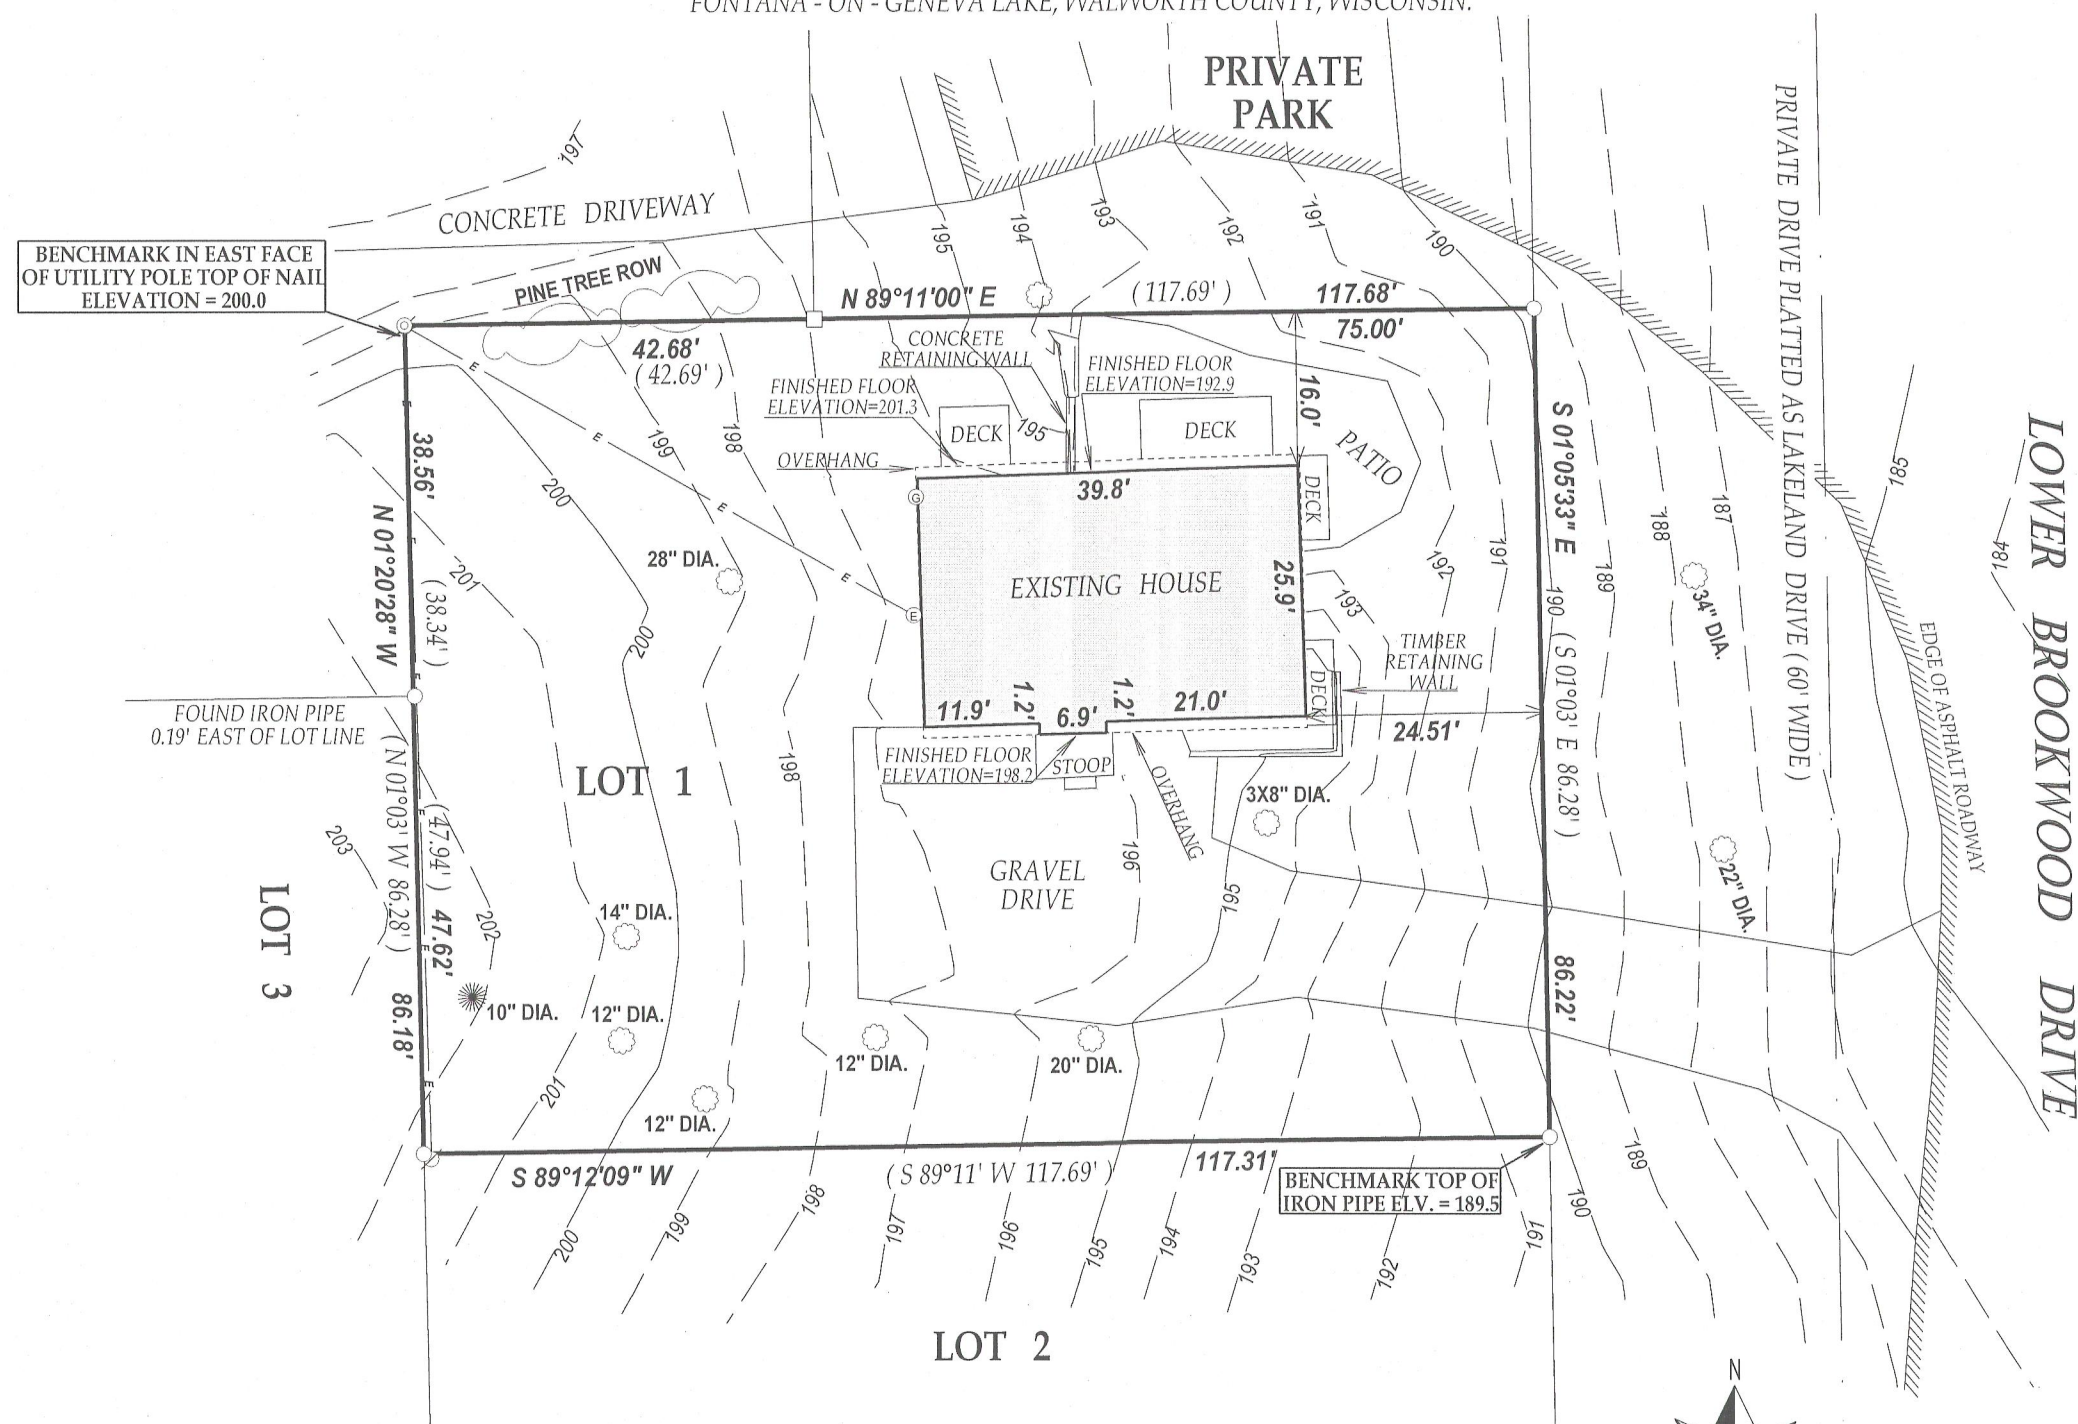

LEGEND

- FOUND 1" DIA. IRON PIPE
- ⊙ FOUND 2" DIA. IRON PIPE
- FOUND IRON BAR
- ⓔ ELECTRIC METER
- ⓖ GAS METER
- ⊘ UTILITY POLE
- OVERHEAD WIRES

- ⊙ DECIDUOUS TREE
- ⊙ CONIFER TREE


(XX) RECORDED AS

TAX ID # SBS00001

JOB # 12-011

I have surveyed the above-described property and the above map is a true representation thereof and shows the size and location of the property, its exterior boundaries, the location and dimensions of all structures thereon, fences apparent easements and roadways and visible encroachments, if any.



This survey is made for the exclusive use of the present owners of the property, and also those who purchase, mortgage, or insure the title thereto within one (1) year from date hereof; and as to them I warrant the accuracy of said survey map.

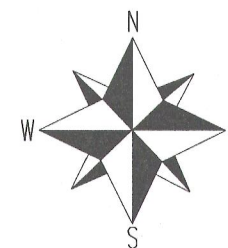

SCALE 1"=20'



NOTE: BEARINGS ARE REFERENCED TO THE RECORD PLAT

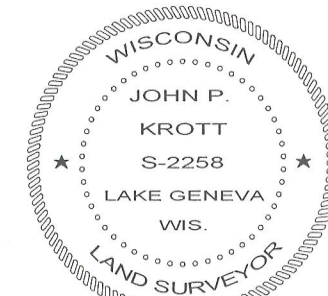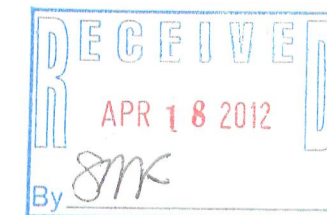

DATED THIS 15th DAY OF FEBRUARY 2012.

John P. Krott

JOHN KROTT S - 2258
Wisconsin Registered Land Surveyor
(original if signed in red)

005-2888