


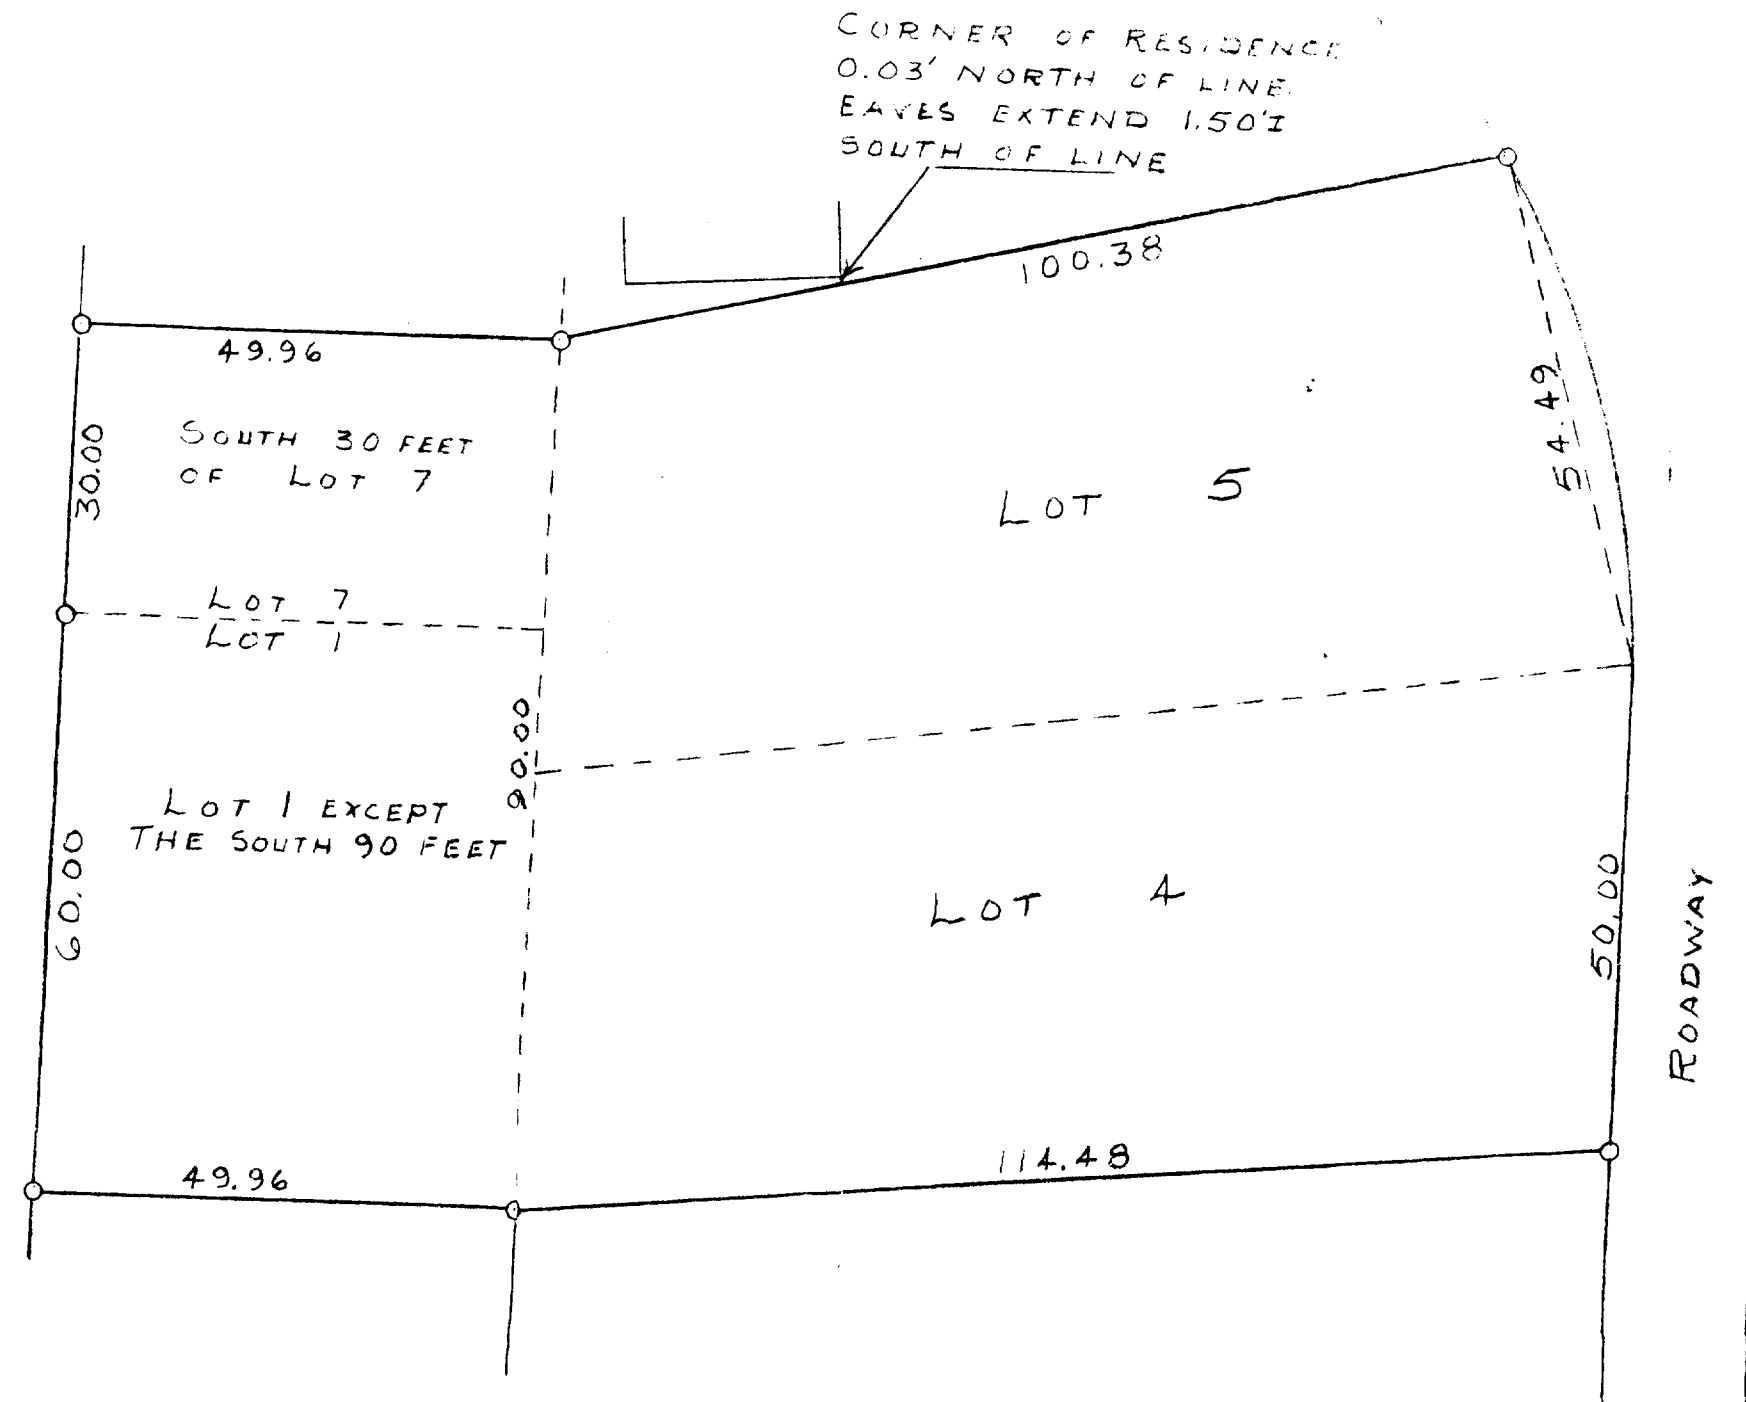

SCALE - 1" = 20'
O = IRON PIPE



PLAT OF SURVEY OF LOTS 4 AND 5 IN BLOCK 1 AND LOT 1 EXCEPT THE SOUTH 90 FEET IN BLOCK 1 AND THE SOUTH 30 FEET OF LOT 7 IN BLOCK 1 INDIAN HILLS LOCATED IN THE VILLAGE OF FONTANA, WALWORTH COUNTY, WISCONSIN
NOV. 3, 1959
REVISED NOV. 11, 1959

George T. Dunham
GEORGE T. DUNHAM, SURVEYOR 5-29
DELAVER, WISCONSIN

SIH
11-5
11-7
SIH-1