
## HAROLD H. KOLB

REGISTERED PROFESSIONAL LAND SURVEYOR LAKE GENEVA, WISCONSIN



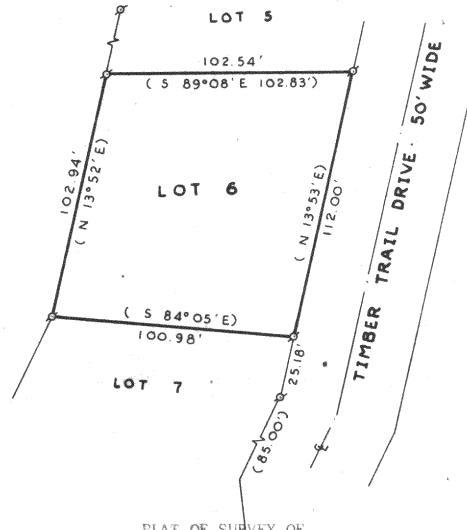

SCALE: 1":40"

PLAT OF SURVEY OF

Lot 6. Addition "F" to Chuntry Club Estates. Village of Fontana-on-Geneva-Lake, Walworth County, Wisconsin.

## LEGEND

- IRON PIPE FOUND
- IRON PIPE PLACED
- CONCRETE MONUMENT
- X SPIKE
- () Platted As

KOLB

I. HAROLD H. KOLB, DO HEREBY CERTIFY THAT I HAVE SURVEYED THE PROPERTY HEREON DESCRIBED ACCORDING TO THE OFFICIAL RECORDS, AND THAT THE PLAT HEREON IS A CORRECT REPRESENTATION OF THE LOT LINES.

HAROLD H. KOLB WISCONSIN REGISTERED CAND SURVEYOR, S-187

DATE August 3, 1973

5-290