



PLAT OF SURVEY
LOT 17 OF PHEASANT RIDGE
LOCATED IN THE SE 1/4 OF NE 1/4 SECTION 23, TOWN 1 NORTH, RANGE 16 EAST
VILLAGE OF FONTANA-ON-GENEVA LAKE, WALWORTH COUNTY, WISCONSIN

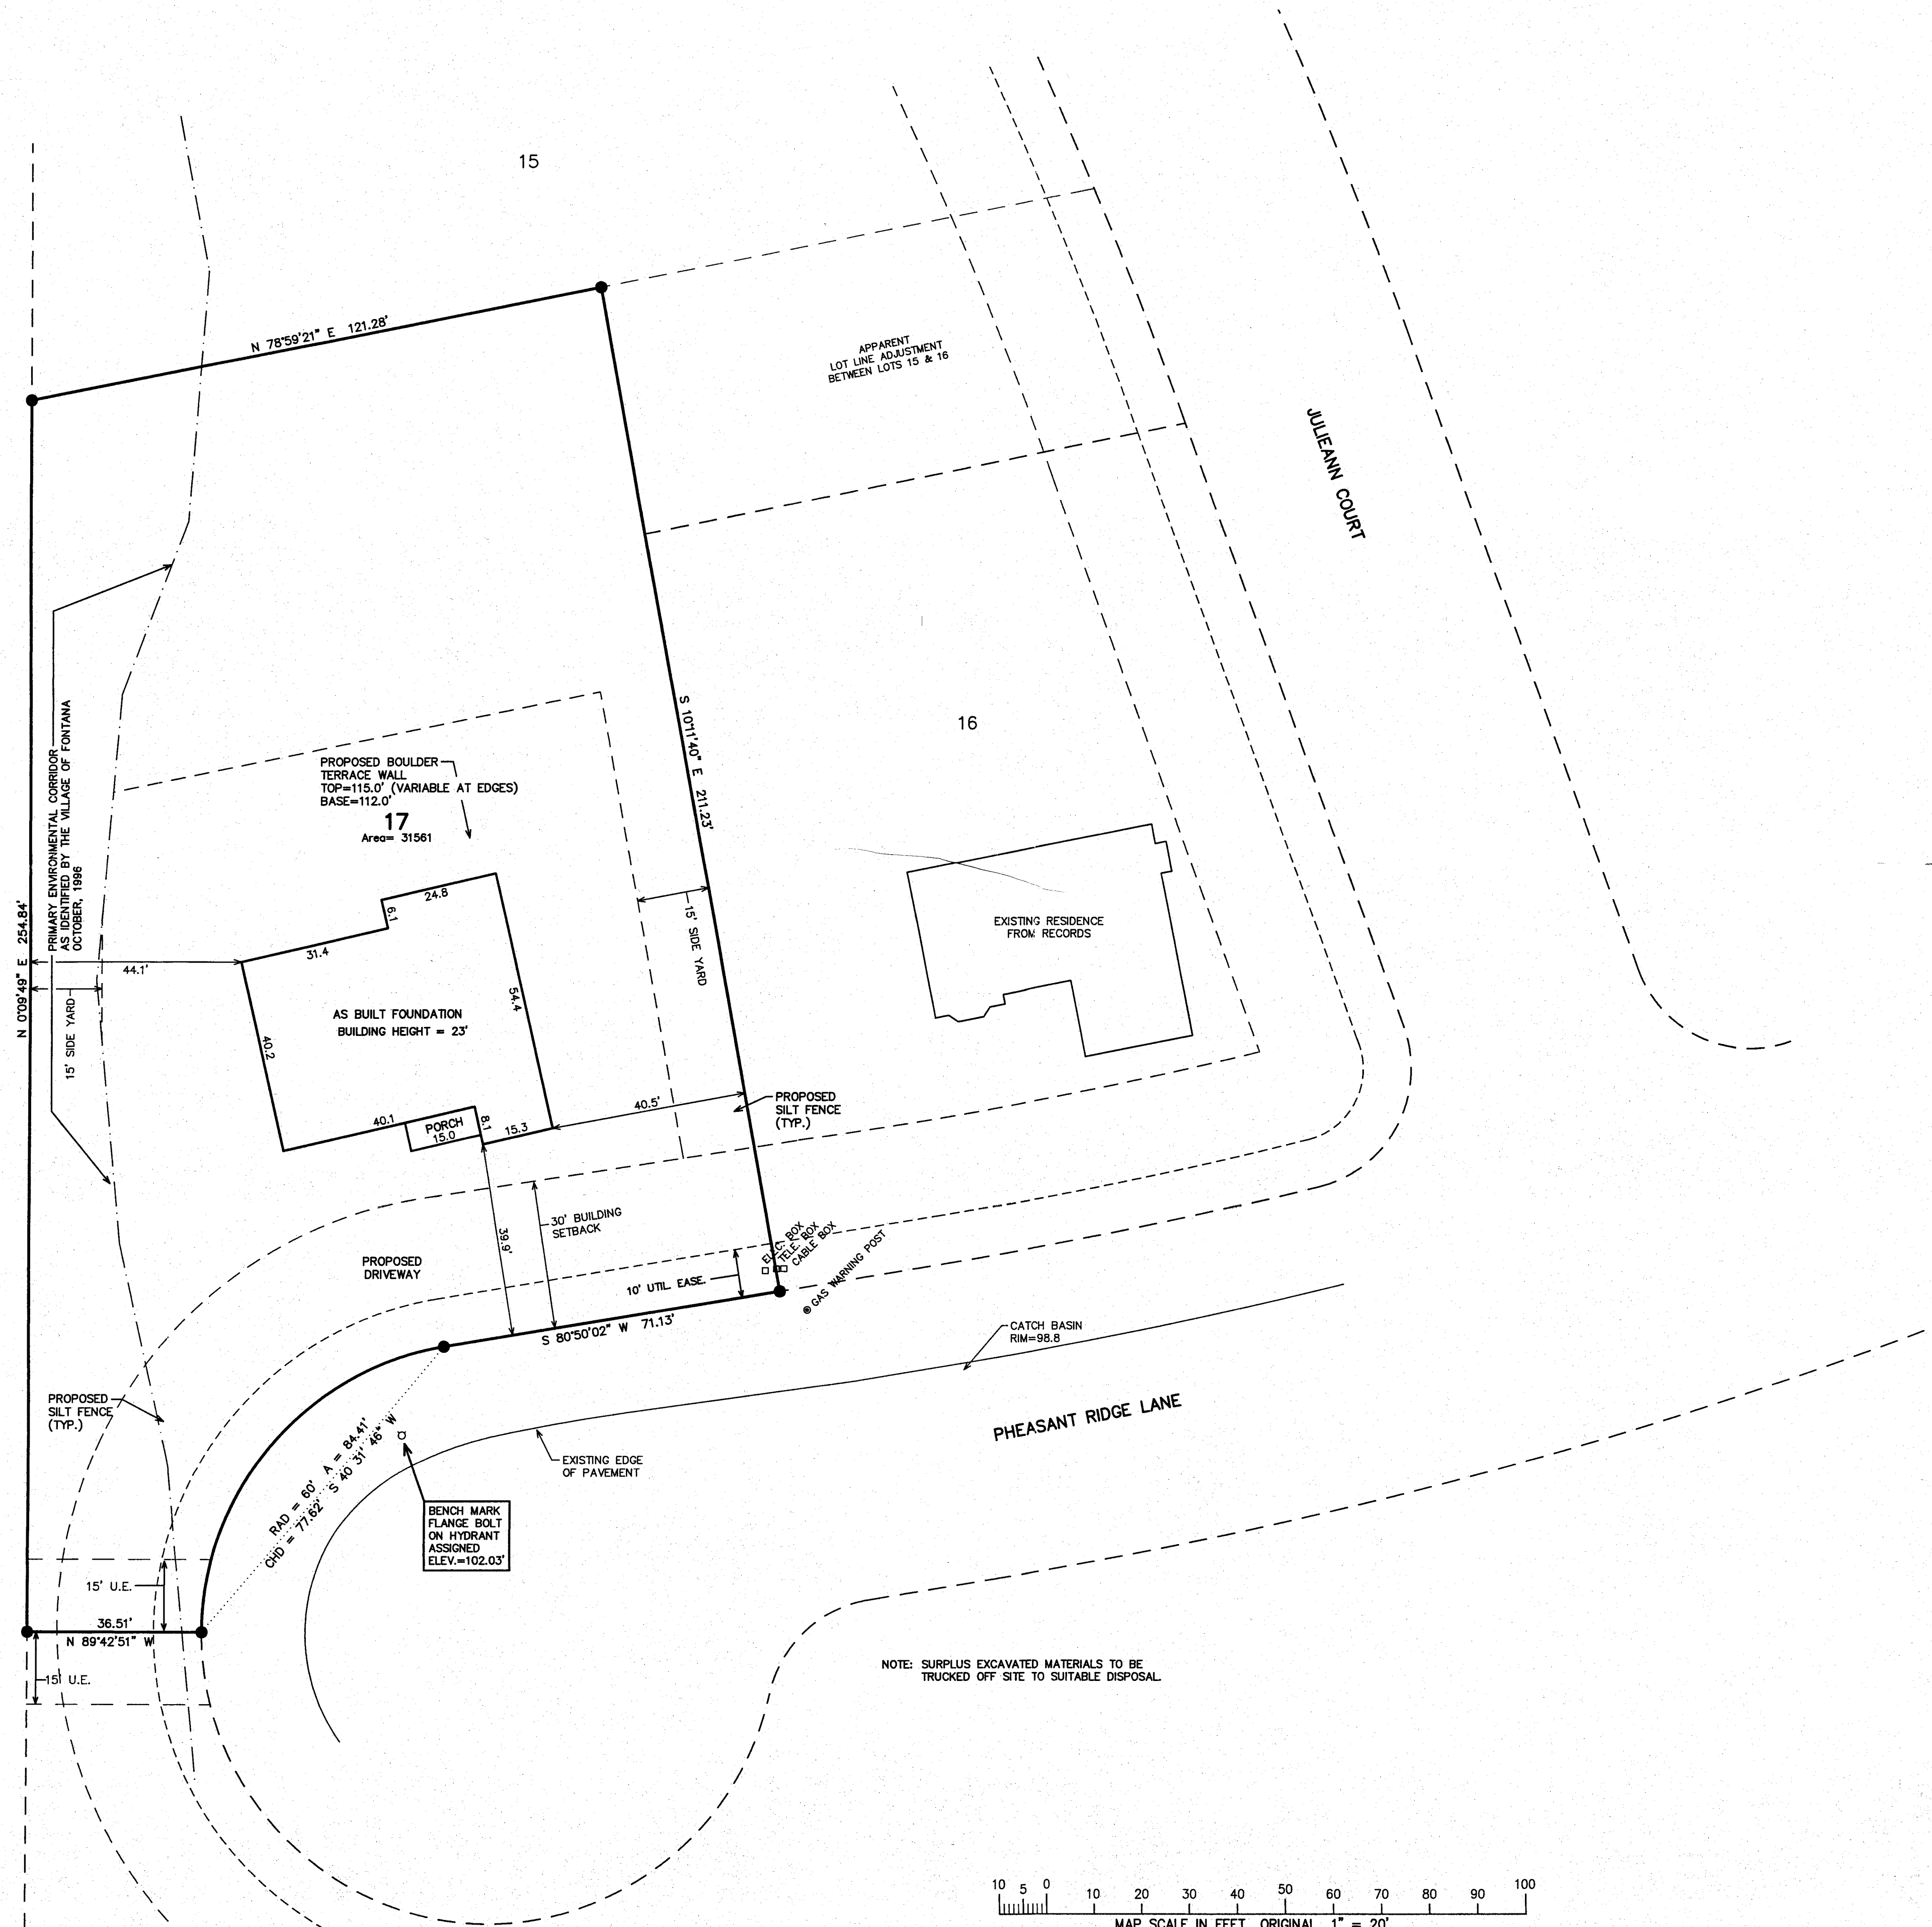


LEGEND
● = FOUND IRON REBAR STAKE

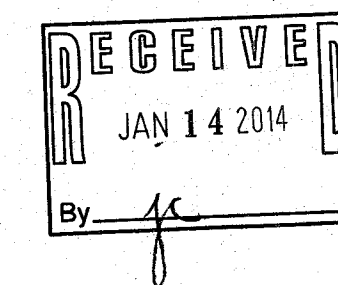

NOTES: COPIES OF THIS MAP TO WHICH THE FOLLOWING CERTIFICATE WILL APPLY SHOW SURVEYOR'S ORIGINAL SEAL AND SIGNATURE IN RED INK. COPIES BY ANY OTHER MEANS MAY HAVE ALTERATIONS WHICH DO NOT REPRESENT THE SURVEYOR'S WORK PRODUCT.

I HEREBY CERTIFY THAT THE ABOVE DESCRIBED PROPERTY HAS BEEN SURVEYED UNDER MY DIRECTION AND THAT THE ABOVE MAP IS A TRUE REPRESENTATION THEREOF AND SHOWS THE SIZE AND LOCATION OF THE PROPERTY AND ITS EXTERIOR BOUNDARIES. THIS SURVEY IS MADE FOR THE USE OF THE PRESENT OWNERS OF THE PROPERTY, AND ALSO THOSE WHO PURCHASE, MORTGAGE, OR GUARANTEE THE TITLE THERETO WITHIN ONE YEAR FROM THE DATE HEREOF.

DATED: 3-10-2013
REVISOR: 8/21/2013-KB
ADJUST THE SIZE OF PROPOSED RESIDENCE
REVISED 12-02-2013 TO SHOW SIZE & LOCATION OF AS BUILT FOUNDATION
PETER S. GORDON R.L.S. 2101

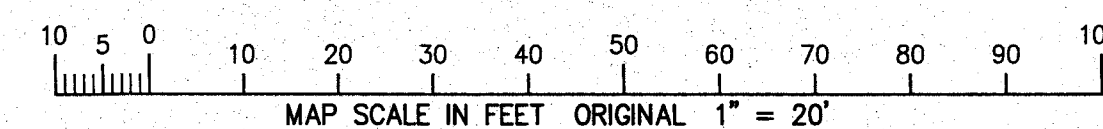

NOTE: SURPLUS EXCAVATED MATERIALS TO BE TRUCKED OFF SITE TO SUITABLE DISPOSAL.



SITE, GRADING, DRAINAGE, &
EROSION CONTROL PLAN

WORK ORDERED BY -
GENEVA LAKE DREAM HOMES
P.O. BOX 259
FONTANA, WI 53125

FARRIS, HANSEN & ASSOCIATES, INC.
ENGINEERING - ARCHITECTURE - SURVEYING
7 RIDGWAY COURT P.O. BOX 437
ELKHORN, WISCONSIN 53121
OFFICE: (262) 723-2098 FAX: (262) 723-5886

REVISIONS

PROJECT NO.
3997.17.13

DATE
04/08/2013

SHEET NO.
1 OF 1

8PHR -17

005-3025