
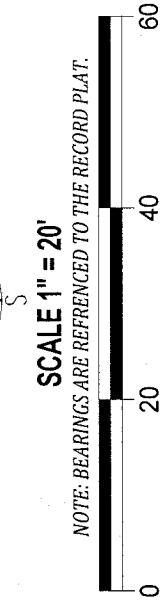
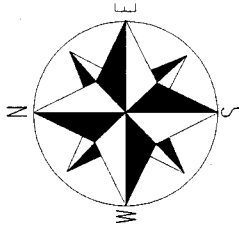
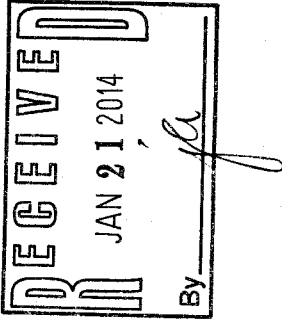


PREPARED FOR:
TRACY GROUP, INC.
525 KENOSHA ST.
WALWORTH, WI 53184

PLAT OF SURVEY OF

LOT 24, OF ADDITION "D" TO COUNTRY CLUB ESTATES, AS PER PLAT
RECORDED JULY 25, 1953, IN VOLUME 12 OF PLATS, PAGE 85, AND
LOCATED IN SECTION 14, TOWN 1 NORTH, RANGE 16 EAST, VILLAGE
OF FONTANA, WALWORTH COUNTY, WISCONSIN.

KROTT SURVEYING INC.
(262) 248-3697
N 3705 WILLOW BEND LANE
LAKE GENEVA WI. 53147

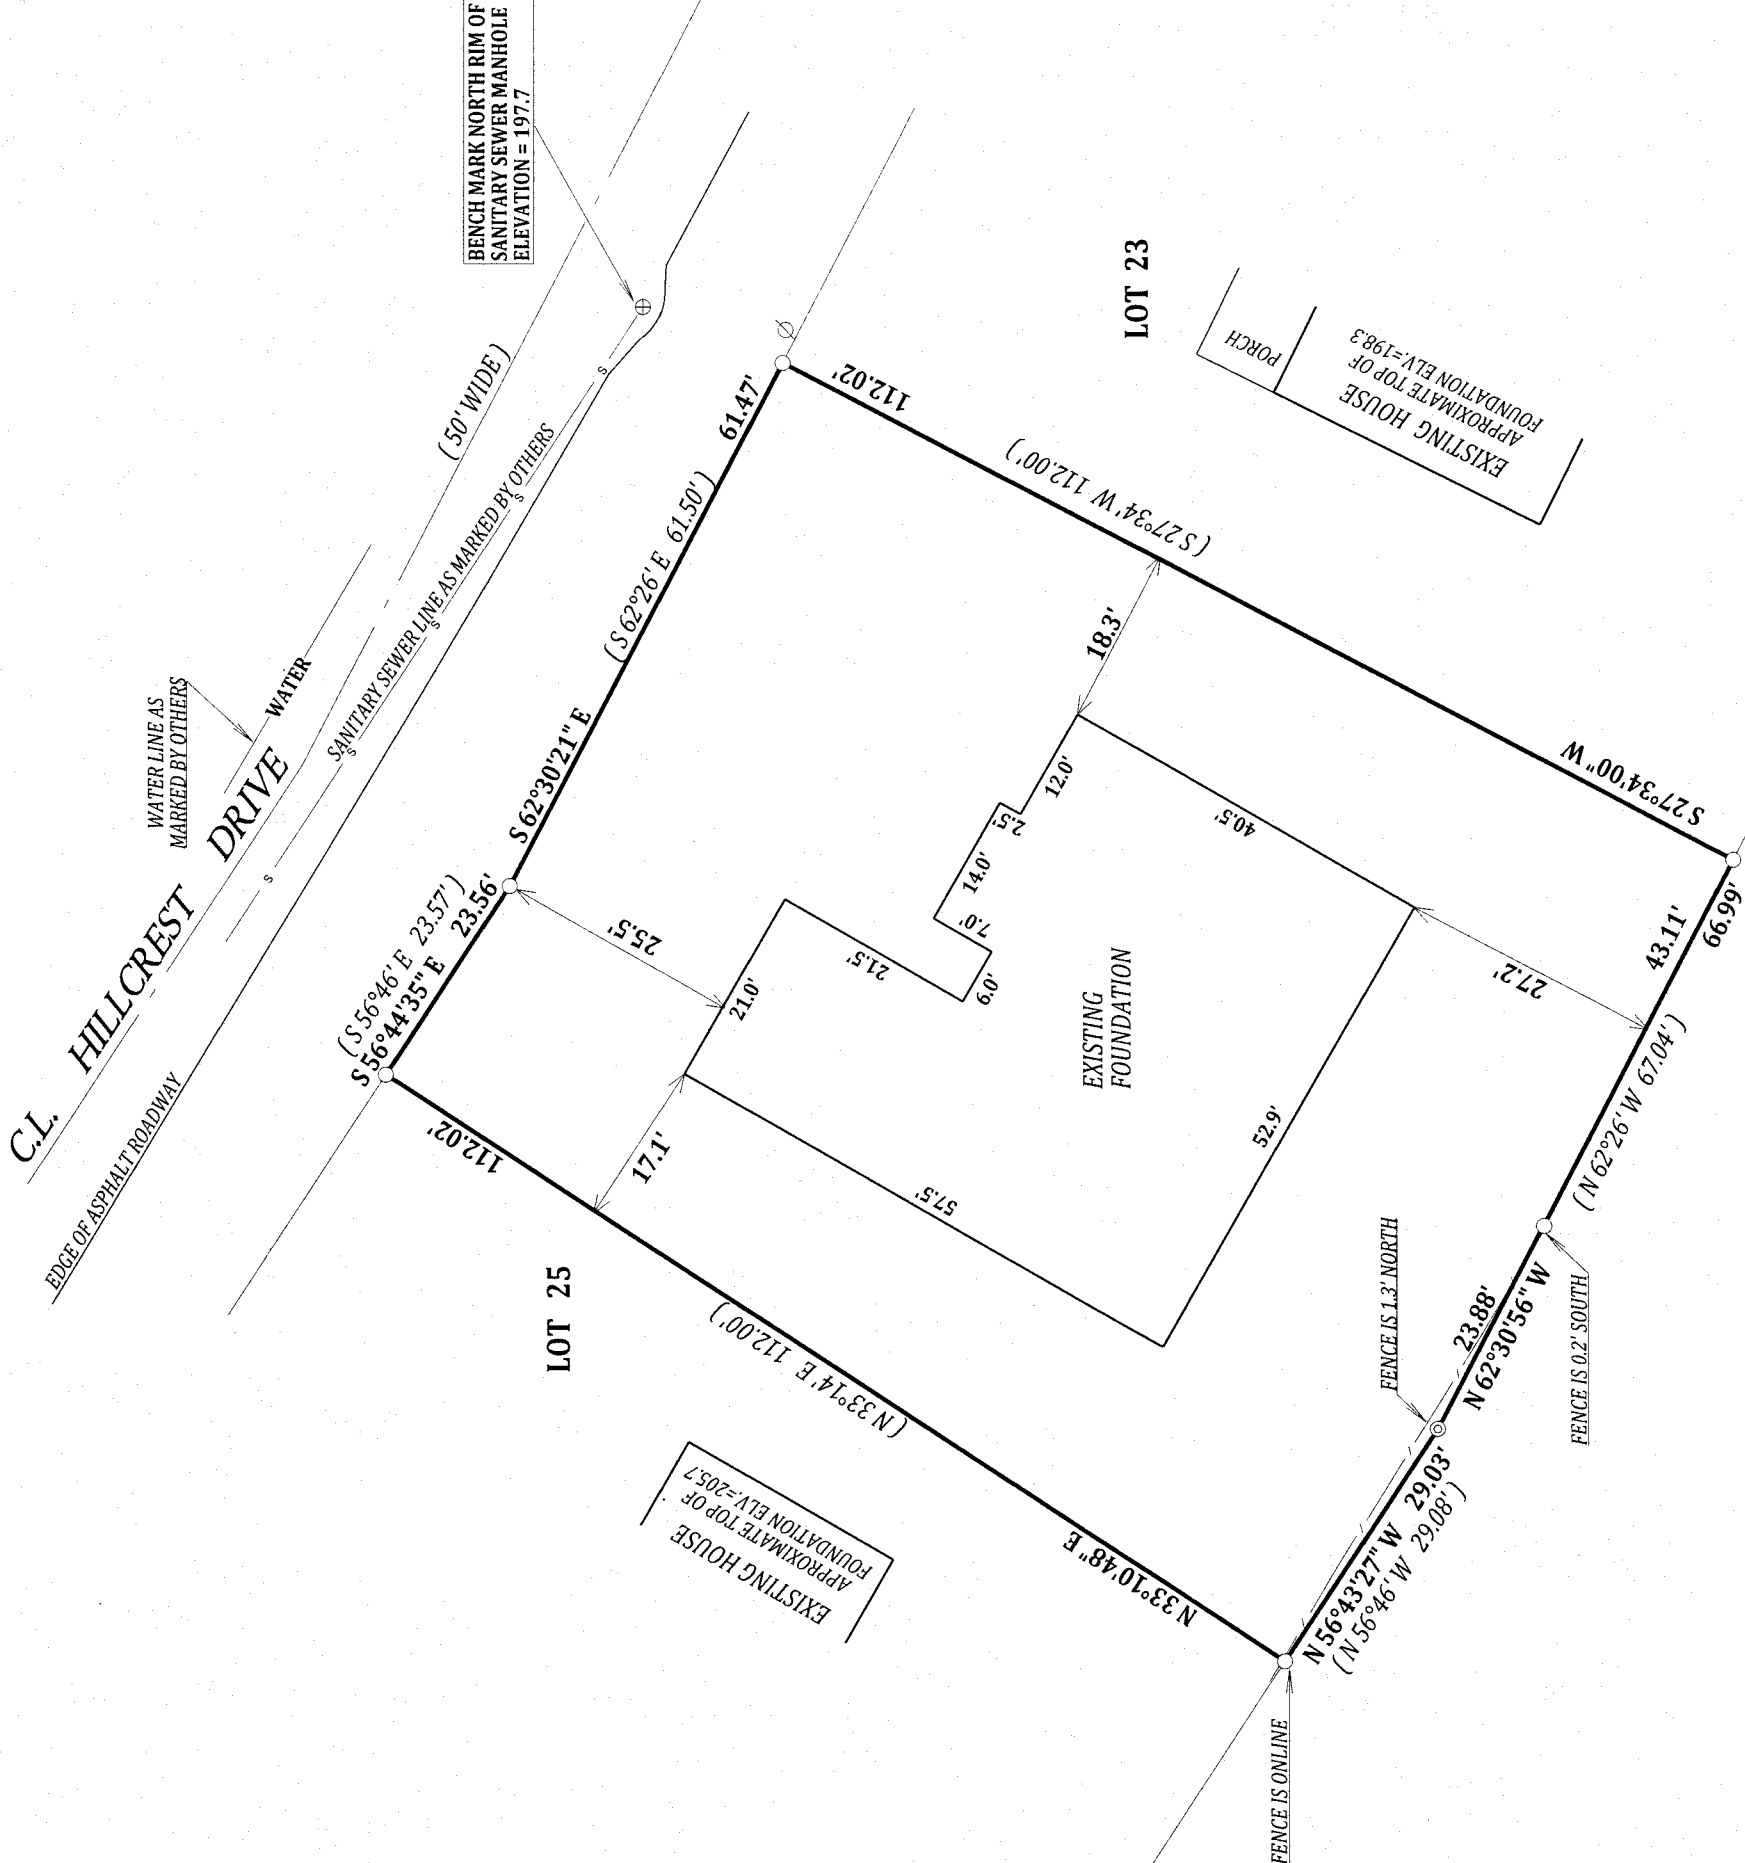


- LEGEND**
- FOUND 1" DIA. IRON PIPE
 - ⊙ FOUND 2" DIA. IRON PIPE
 - ⊕ SANITARY SEWER MAN HOLE
 - ⊗ UTILITY POLE
 - WOOD FENCE

(XX) RECORDED AS
TAX ID # SCTD00025
JOB # 13-151

I have surveyed the above-described property and the above map is
a true representation thereof and shows the size and location of the
property, its exterior boundaries, the location and dimensions of all
structures thereon, fences apparent easements and roadways and
visible encroachments, if any.

This survey is made for the exclusive use of the present owners of
the property, and also those who purchase, mortgage, or insure the
title thereto within one (1) year from date hereof; and as to them I
warrant the accuracy of said survey map.

DATED THIS 2nd DAY OF OCTOBER 2013
DATE OF LAST REVISION: 12 / 04 / 2013

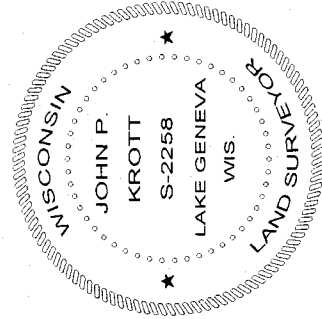

John P. Krott
JOHN P. KROTT S-2258
WISCONSIN REGISTERED LAND SURVEYOR
(NOTE: THIS IS NOT A CERTIFIED COPY
UNLESS SIGNED IN RED INK)

SCTD -25 005-3035