
## Plat of Survey

Survey For: Location: Wm. Kilps

Description: LOT 132 ABBEY SPRINGS a parcel of land located in the S.W. 1/4 of the S.W. 1/4 of Section 18, T. 1 N., R. 17 E., Village of Fontana, on Geneva Lake, Walworth County, Wisconsin, being mose particularly described as follows: Beginning at the N.W. corner of Unit 133 of Abbey Springs; thence N. 0'49' E., 80.00 feet; thence S. 89'11' E., 175.00 feet; thence S. 0'49' W. 80.00 feet; thence N. 89'11' W., 175.00 feet to the point of beginning, containing 0.3214 acres more or less.





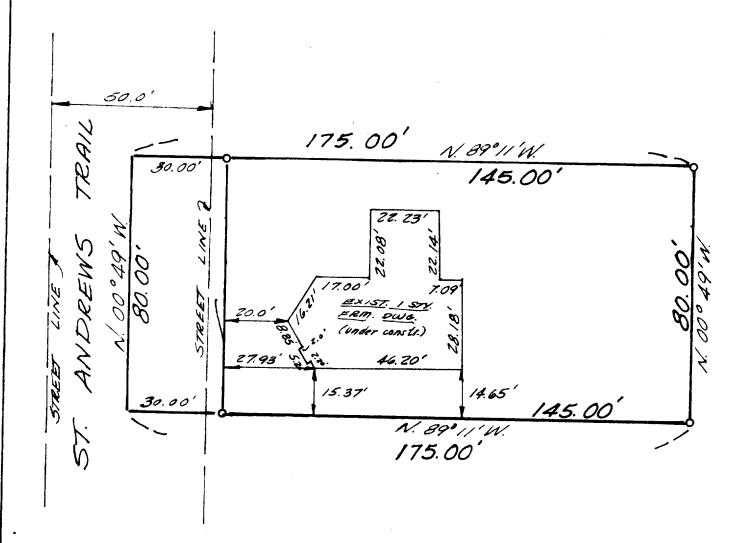

INMAN ENGINEERING
OF
MILWAUKEE, INC.
ENGINEERS – SURVEYORS

State of Wisconsin )
Milwaukee County )

I hereby certify that I have surveyed the above described property, that the above plat is a true representation thereof and correctly shows the exterior boundary lines, location of principal buildings and other visible improvements relative to said boundary lines.

Thomas Inman, Registered Land Surveyor

Date: 9/13/73 Job No 6996

Scale: / **# 3**0