PREPARED FOR: MARGARET LABUS D'APRILE PROPERTIES PO BOX 72 FONTANA, WI 53125


PLAT OF **SURVEY**

-OF-

LOT 11 IN UNIT 2 OF COUNTRY CLUB ESTATES, VILLAGE OF FONTANA, ACCORDING TO THE PLAT THEREOF RECORDED IN VOLUME 8 OF PLATS ON PAGE 67 AND 68; SAID LAND BEING IN THE VILLAGE OF FONTANA, WALWORTH COUNTY, WISCONSIN.

LYNCH & ASSOCIATES ENGINEERING CONSULTANTS, LLC.

5482 S. WESTRIDGE DR. NEW BERLIN, WI 53151 (262) 248-3697

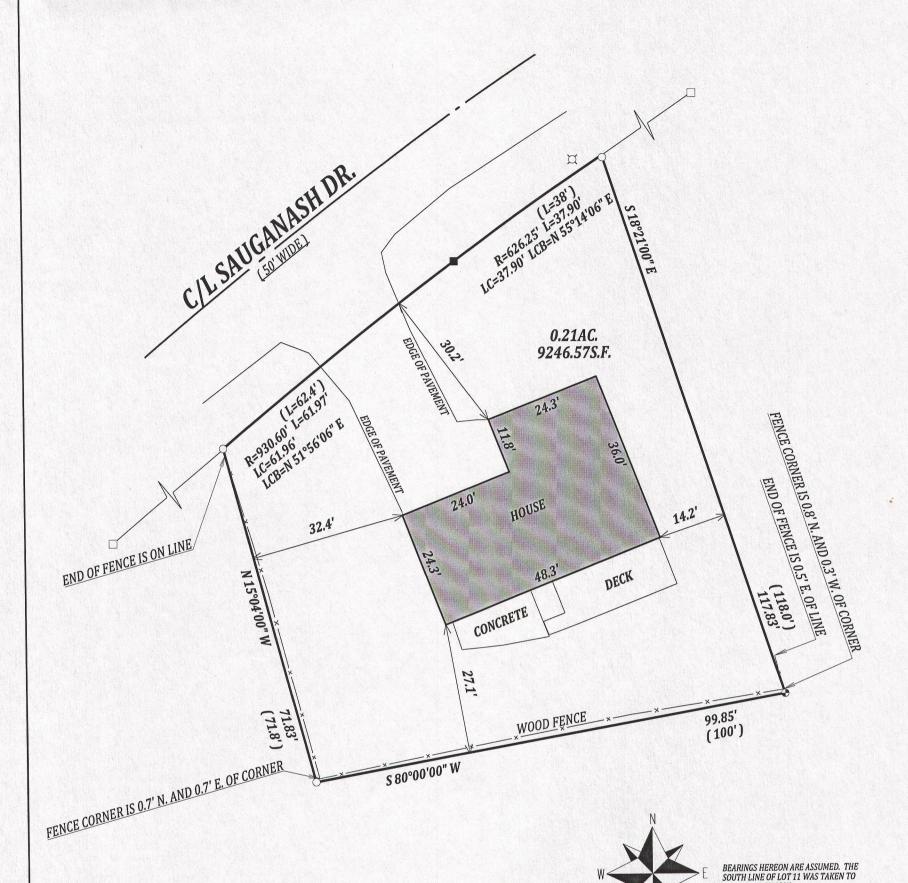


LEGEND

- O FOUND 1" IRON PIPE
- □ FOUND 5/8" IRON ROD
- SET 1.30" O.D. X 18" IRON PIPE 1.13#/L.F.

(XX) RECORDED AS

☐ LIGHT POLE

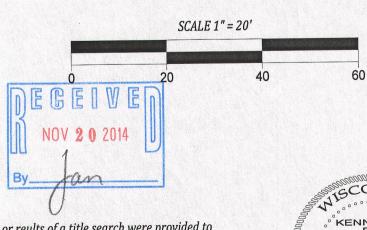


NOTE:

No title commitment or reults of a title search were provided to this office pertaining to this survey. This Plat Of Survey may not reflect easements of record, encumbrances, restrictions, ownership, title evidence, or other facts that a current and accurate title search may disclose accurate title search may disclose.

I have surveyed the above-described property and the above map is a true representation thereof and shows the size and location of the property, its exterior boundaries, the location and dimensions of all structures thereon, fences apparent easements and roadways and visible encroachments. if any.

This survey is made for the exclusive use of the present owners of the property, and also those who puchase, mortgage, or insure the title therto within one (1) year from date hereof; and as to them I warrant the accuracy of said survey map.

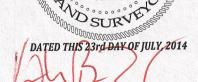

MEHRING S-2838 WATERFORD

KENNETH B. MEHRING S - 2838 Wisconsin Registered Land Surveyor (original if signed in red)

JOB # 14-584 TAX ID # SCO2 00010