


HAROLD H. KOLB

REGISTERED PROFESSIONAL LAND SURVEYOR
LAKE GENEVA, WISCONSIN

PUBLIC ROAD - 49.5' WIDE

PLAT OF SURVEY OF

Lot 3, Block 3, Brookwood Sub-
division, Village of Fontana-on-
Geneva-Lake, Walworth County,
Wisconsin.

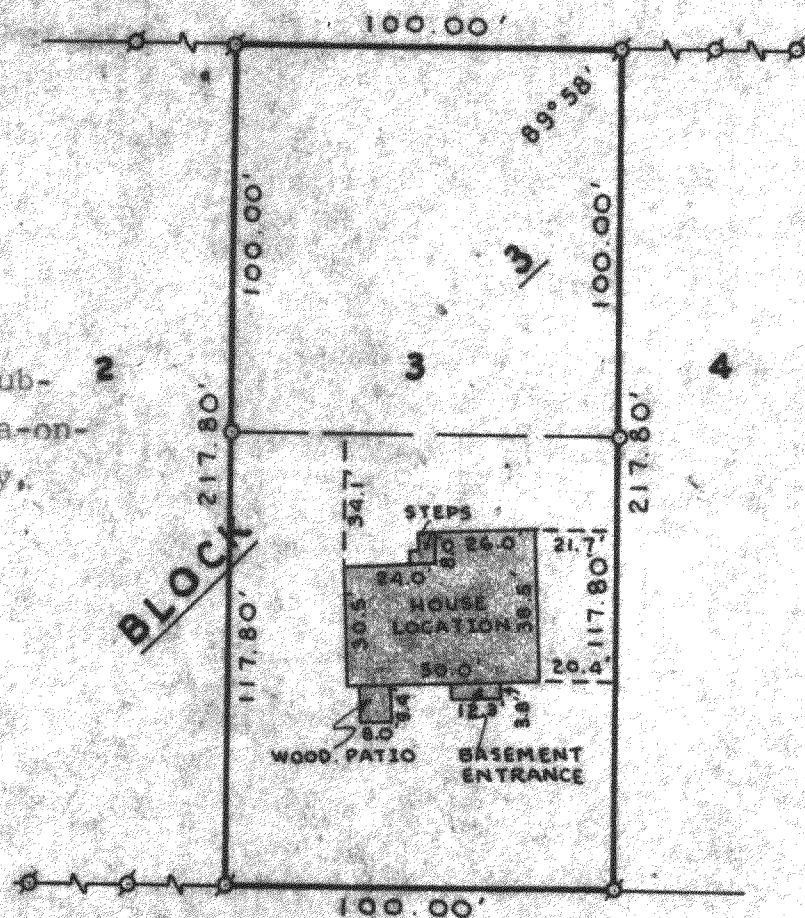

N



SCALE: 1"=50'

LEGEND

- ⊕ — IRON PIPE FOUND
- — IRON PIPE PLACED
- — CONCRETE MONUMENT
- x — SPIKE



I, HAROLD H. KOLB, DO HEREBY CERTIFY THAT I HAVE
SURVEYED THE PROPERTY HEREON DESCRIBED ACCORDING
TO THE OFFICIAL RECORDS, AND THAT THE PLAT HEREON
IS A CORRECT REPRESENTATION OF THE LOT LINES, and
the principle building lines thereon.

Harold H. Kolb

HAROLD H. KOLB
WISCONSIN REGISTERED LAND SURVEYOR, S-187
DATE October 10, 1973

SBS-24

5-309