## LAND-MARK SURVEYING Mark L. Miritz


Wisconsin Professional Land Surveyor S-2582


**N9330 Knuteson Drive** Whitewater, WI 53190 Phone:(262)495-3284 MARKMIRITZ@ LAND-MARKSURVEYING.COM

## PLAT OF SURVEY

LOT 4 AND LOT 5 IN BLOCK 14 OF GLENWOOD SPRINGS, LOCATED IN THE SOUTHEAST 1/4 OF SECTION 14, TOWN 1 NORTH, RANGE 16 EAST, VILLAGE OF FONTANA, WALWORTH COUNTY, WISCONSIN.

**ORDERED BY: MICHAEL AND PEGGY BENTLEY KEEFE REAL ESTATE 751 GENEVA PARKWAY LAKE GENEVA, WI 53147** 

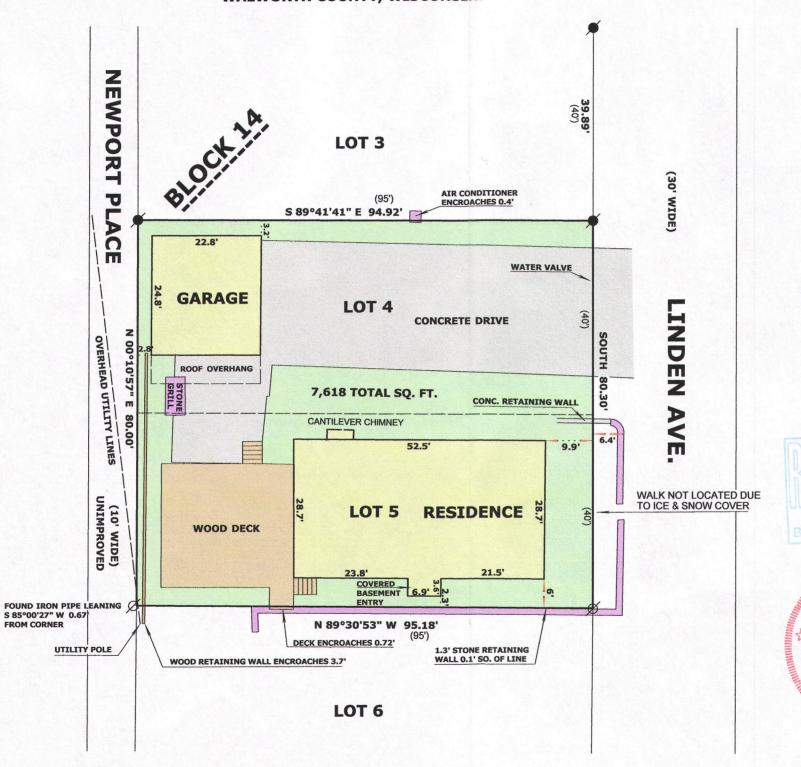

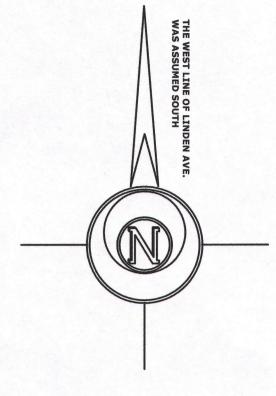

## **LEGEND**

**FOUND IRON PIPE** 

FOUND IRON ROD

RECORDED AS DIMENSION



"I hereby certify that the above described property has been surveyed by me or under my direction and that the above map is a true representation thereof and shows the size and location of the property, its exterior boundaries, the location of all visible structures and dimensions of all principal buildings thereon, boundary fences, apparent easements, roadways and visible encroachments, if any."

"This survey is made for the use of the present owners of the property, and also those who purchase, mortgage, or guarantee the title thereto within one year from date hereof."

MARK L. MIRITZ

WISCONSIN PROFESSIONAL **LAND SURVEYOR S-2582** 

DATE: FEB. 19, 2016 JOB NO. 16.203

FEB 2 2 2016

CONS

MARK L

MIRITZ

S-2582

WHITEWATER,

WI

SUR

tan