


DEC 23 2016

12/14/2016 X:\Projects\4378\4378-5\ASBUILT

CBTR-5



LOT 5


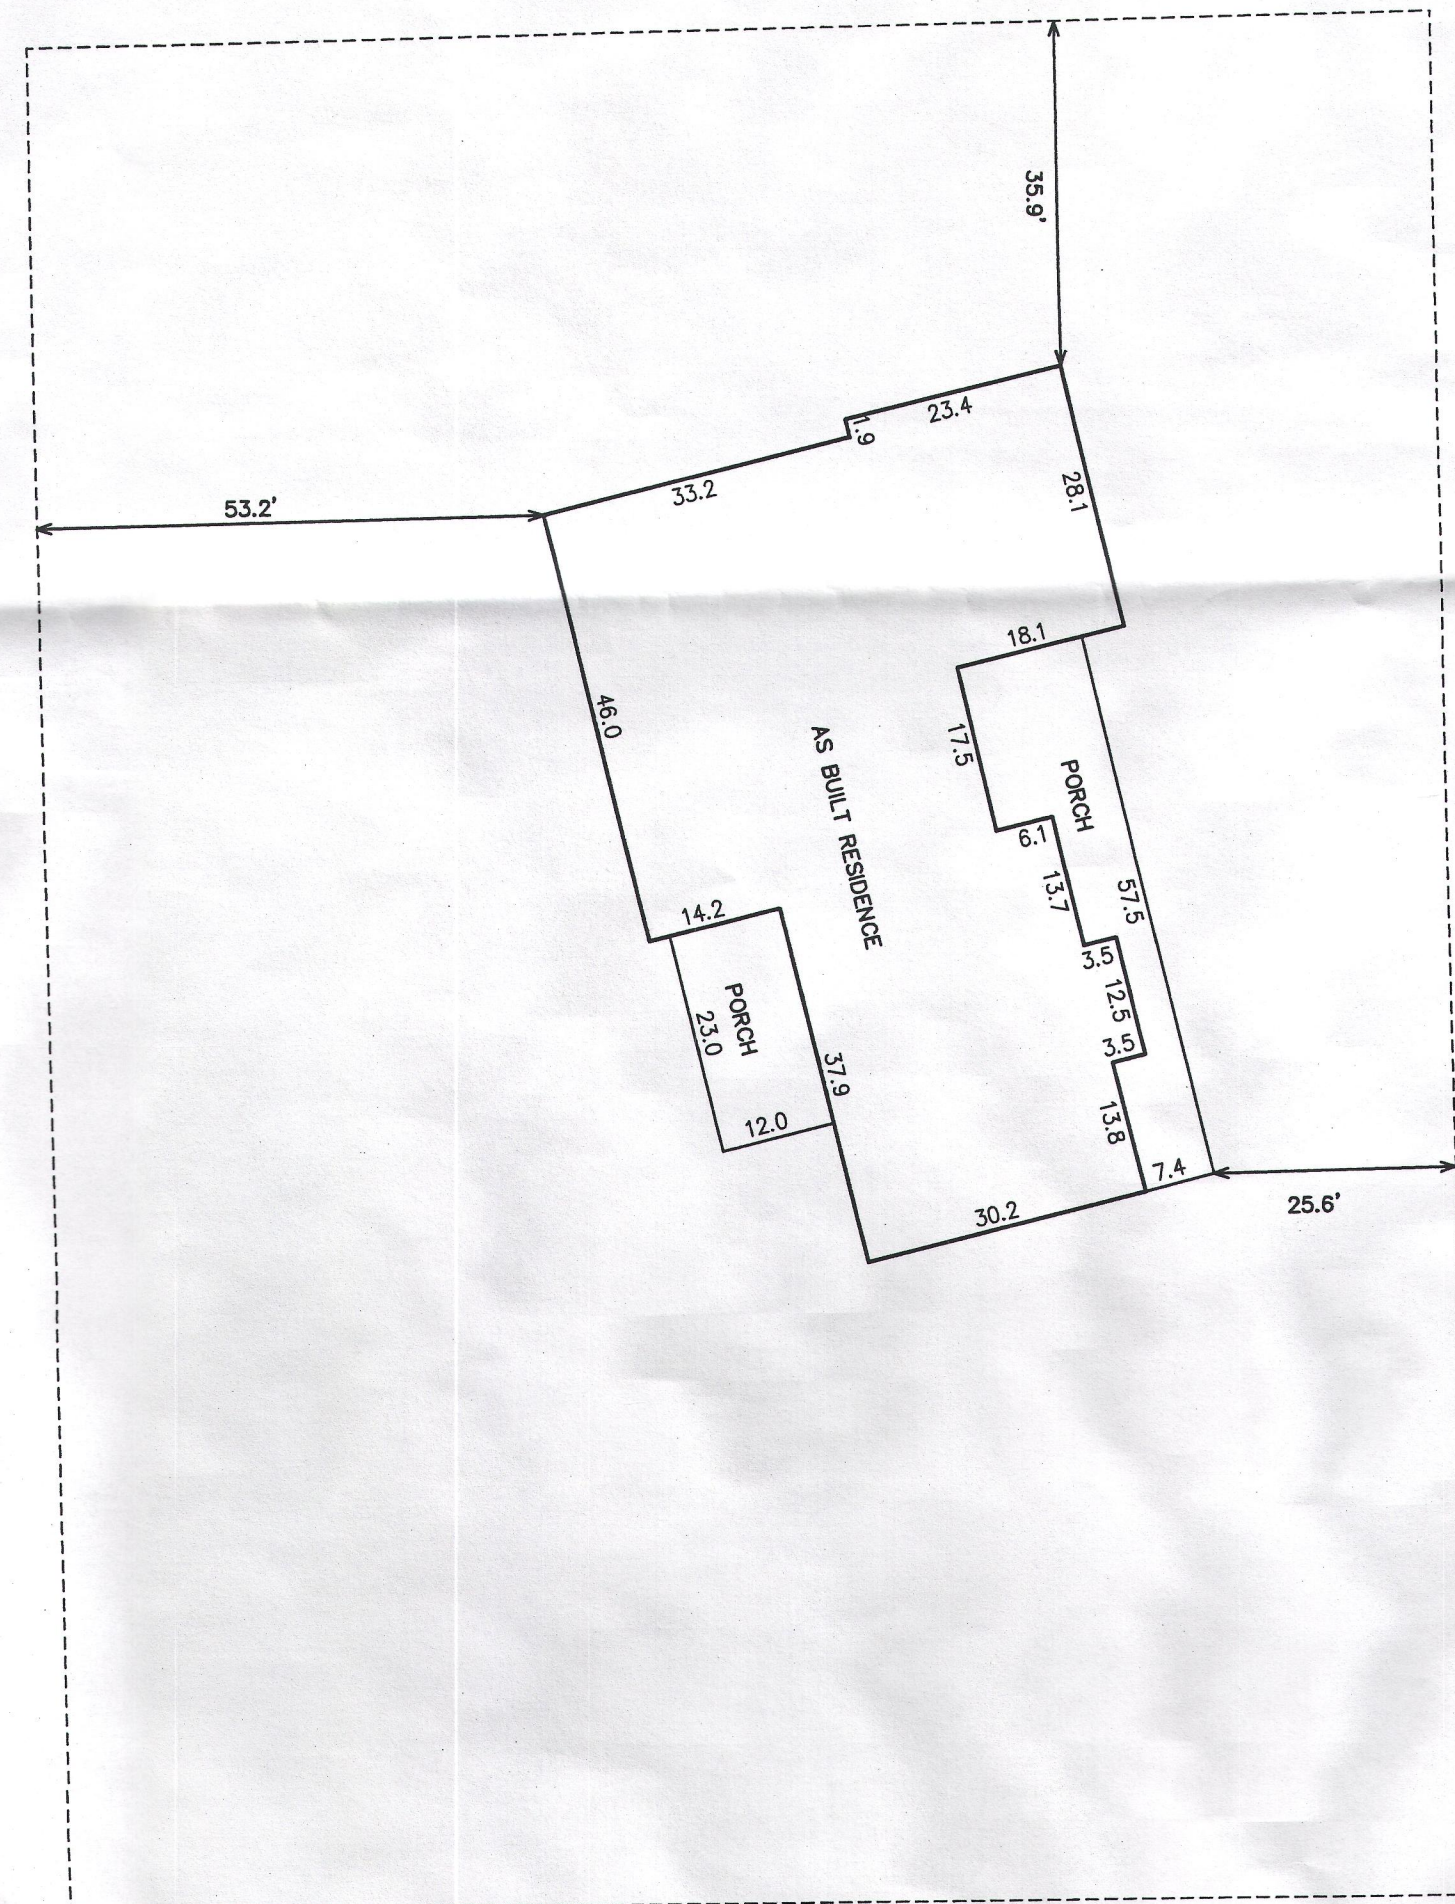


BEAR TRAP LANE

BENCH MARK
SET NAIL IN WEST SIDE
16" DECIDUOUS TREE
EL. = 1017.72

AS BUILT SURVEY
ADDENDUM TO PLAT OF SURVEY
LOT 5 BEAR TRAP RIDGE SUB.


LEGEND
● = IRON REBAR STAKE
{XXX} = RECORDED AS

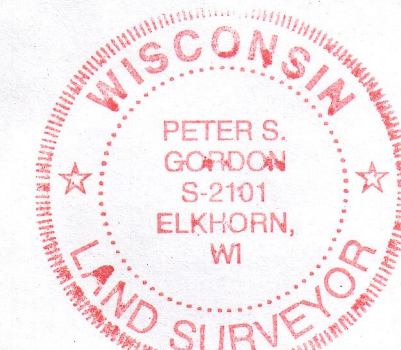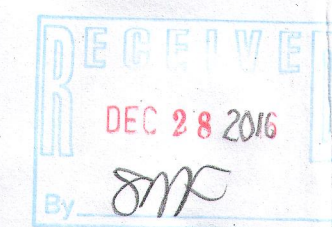

12/28/2016
Peter S. Gordon

10 5 0 10 20 30 40 50 60 70 80 90 100
MAP SCALE IN FEET ORIGINAL 1" = 20'

005-3793

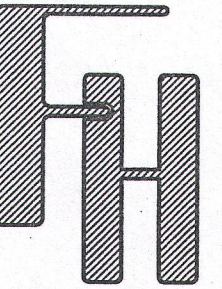

MILLER RESIDENCE

ORDERED BY:
JENNY MILLER
4804 LINDWALL ROAD
HARVARD, IL. 60033

FARRIS, HANSEN & ASSOCIATES, INC.
ENGINEERING - ARCHITECTURE - SURVEYING
7 RIDGWAY COURT P.O. BOX 437
ELKHORN, WISCONSIN 53121
OFFICE: (262) 723-2098 FAX: (262) 723-5886

REVISIONS

PROJECT NO.
4378.5.16
DATE
06-06-2016
SHEET NO.
1 OF 1