
FARRIS, HANSEN & ASSOCIATES, INC.

ENGINEERING - ARCHITECTURE - SURVEYING
7 RIDGWAY COURT - P.O. BOX 437 - ELKHORN, WISCONSIN 53121
PHONE: (262) 723-2098 FAX: (262) 723-5886

PLAT OF SURVEY

 WORK ORDERED BY – KRISTINA TARANTINO 1754 GROVE STREET GLENVIEW, IL. 60025

The South 1/2 of Lots 1 and 2 in Addition to Glenwood Springs, a subdivision in part of Section 14, TlN, R16E, Village of Fontana-on Geneva Lake, County of Walworth, State of Wisconsin, together with that part of Grove Avenue as platted immediately adjoining said South half of Lots 1 and 2.

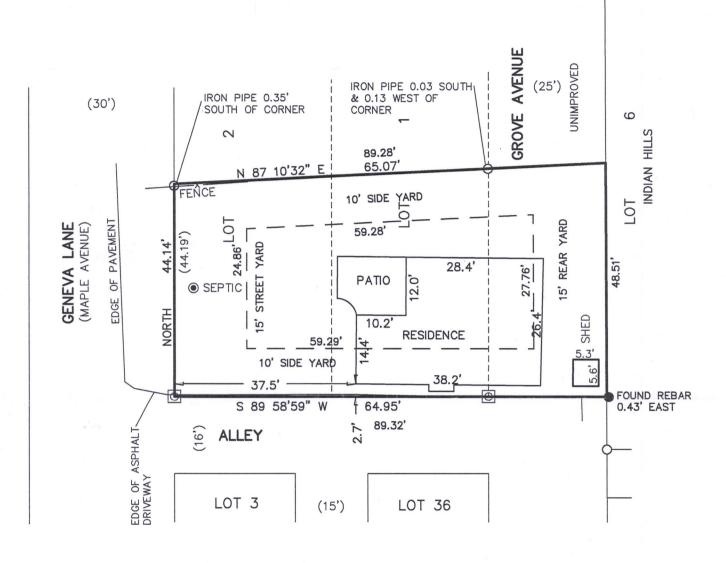

10 5 0 10 20 30 40 50 60 70 80 90 100 MAP SCALE IN FEET ORIGINAL 1" = 20'

AREA = 4,135 S.F.

LEGEND

O = FOUND IRON PIPE STAKE

= FOUND IRON REBAR STAKE

O = FOUND CONCRETE MONUMENT
(XXX) = RECORDED AS

NOTE: COPIES OF THIS MAP TO WHICH THE FOLLOWING CERTIFICATE WILL APPLY SHOW SURVEYOR'S ORIGINAL SEAL AND SIGNATURE IN RED INK. COPIES BY ANY OTHER MEANS MAY HAVE ALTERATIONS WHICH DO NOT REPRESENT THE SURVEYOR'S WORK PRODUCT.

I HEREBY CERTIFY THAT THE ABOVE DESCRIBED PROPERTY HAS BEEN SURVEYED UNDER MY DIRECTION AND THAT THE ABOVE MAP IS A TRUE REPRESENTATION THEREOF AND SHOWS THE SIZE AND LOCATION OF THE PROPERTY AND ITS EXTERIOR BOUNDARIES. THIS SURVEY IS MADE FOR THE USE OF THE PRESENT OWNERS OF THE PROPERTY, AND ALSO THOSE WHO PURCHASE, MORTGAGE, OR GUARANTEE THE TITLE THERETO WITHIN ONE YEAR FROM THE DATE HEREOF.

DATED: JULY 8, 2010

REVISED 04-17-2017
TO REFLECT NEW LEGAL DESCRIPTION
AND SHOW MINIMUM SETBACKS PER
RON NYMAN CORRESPONDENCE

PETER S. GORDON R.L.S. 2101





PROJECT: 8192 DATE: 07-08-2010 SHEET 1 OF 1

4/19/2017 X:\Projects\8192\DCAD\PLAT2017