

LAND-MARK SURVEYING

Mark L. Miritz

Wisconsin Professional Land Surveyor S-2582



N9330 Knuteson Drive
Whitewater, WI 53190
Phone: (262) 949-1239
MARKMIRITZ@

LAND-MARKSURVEYING.COM

PLAT OF SURVEY

LOT 10 OF THE REVISED PLAT OF THE GARDENS, LOCATED IN SECTION 11,
TOWN 1 NORTH, RANGE 16 EAST, VILLAGE OF FONTANA, WALWORTH
COUNTY, WISCONSIN.

ORDERED BY:
JOHN LAW
RE/MAX GENEVA REALTY
101 BROAD STREET, SUIT 102
LAKE GENEVA, WI 53147

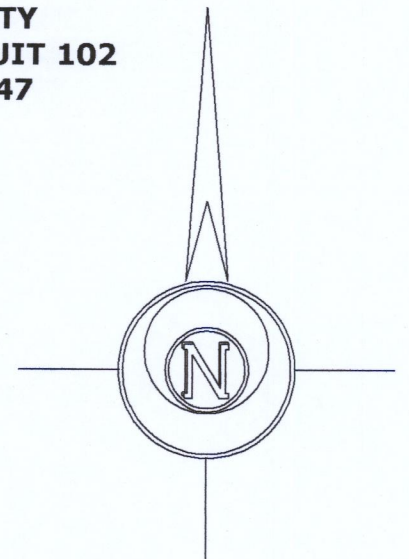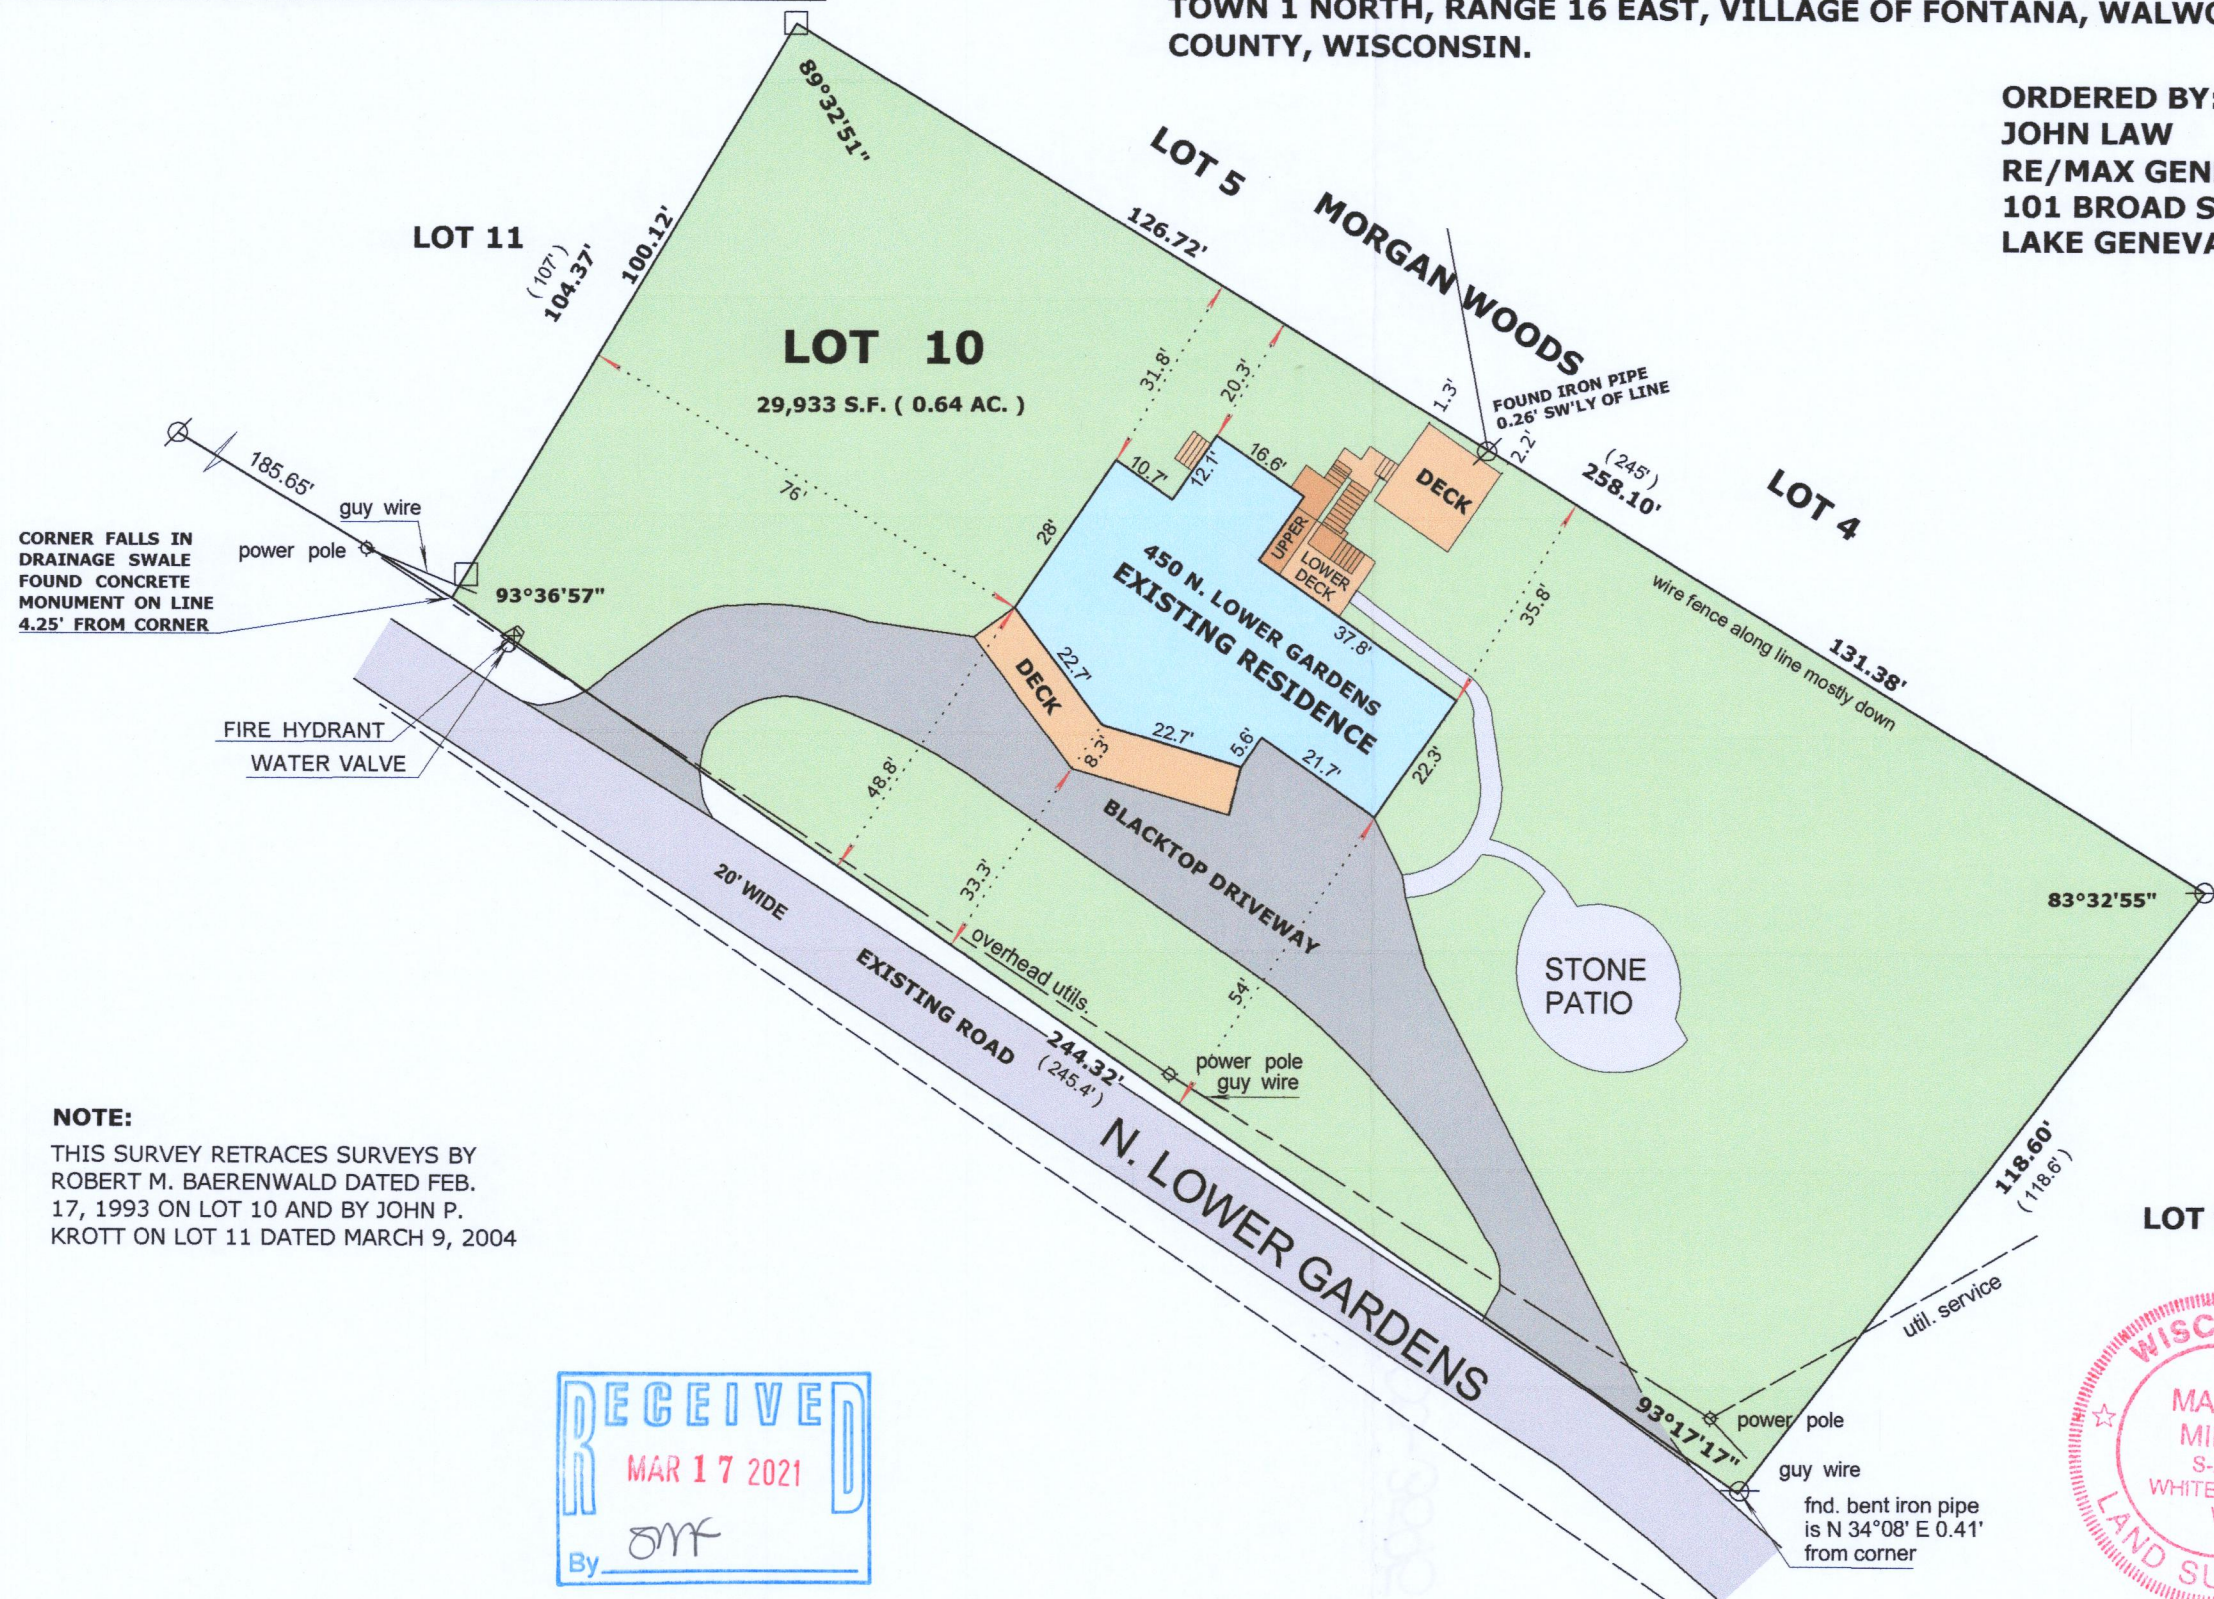

SCALE: 1 INCH = 30 FEET


LEGEND

- FOUND IRON PIPE
- FOUND CONCRETE MONUMENT
- (x x) RECORDED AS DIMENSION

"I hereby certify that the above described property has been surveyed by me or under my direction and that the above map is a true representation thereof and shows the size and location of the property, its exterior boundaries, the location of all visible structures and dimensions of all principal buildings thereon, boundary fences, apparent easements, roadways and visible encroachments, if any."
"This survey is made for the use of the present owners of the property, and also those who purchase, mortgage, or guarantee the title thereto within one year from date hereof."

Mark L. Miritz
MARK L. MIRITZ
WISCONSIN PROFESSIONAL
LAND SURVEYOR S-2582

DATE: DEC. 19, 2020 JOB NO. 06.309

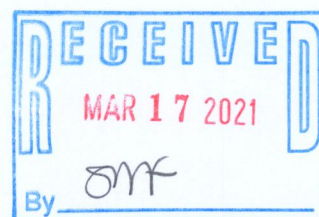

SG-10

005-3595