
## PLAT OF SURVEY UNIT 591 OF ABBEY SPRINGS CONDOMINIUM NO. 13

LOCATED IN THE SOUTHEAST 1/4 OF SECTION 13, TOWN 1 NORTH, RANGE 16 EAST, WALWORTH COUNTY, WISCONSIN

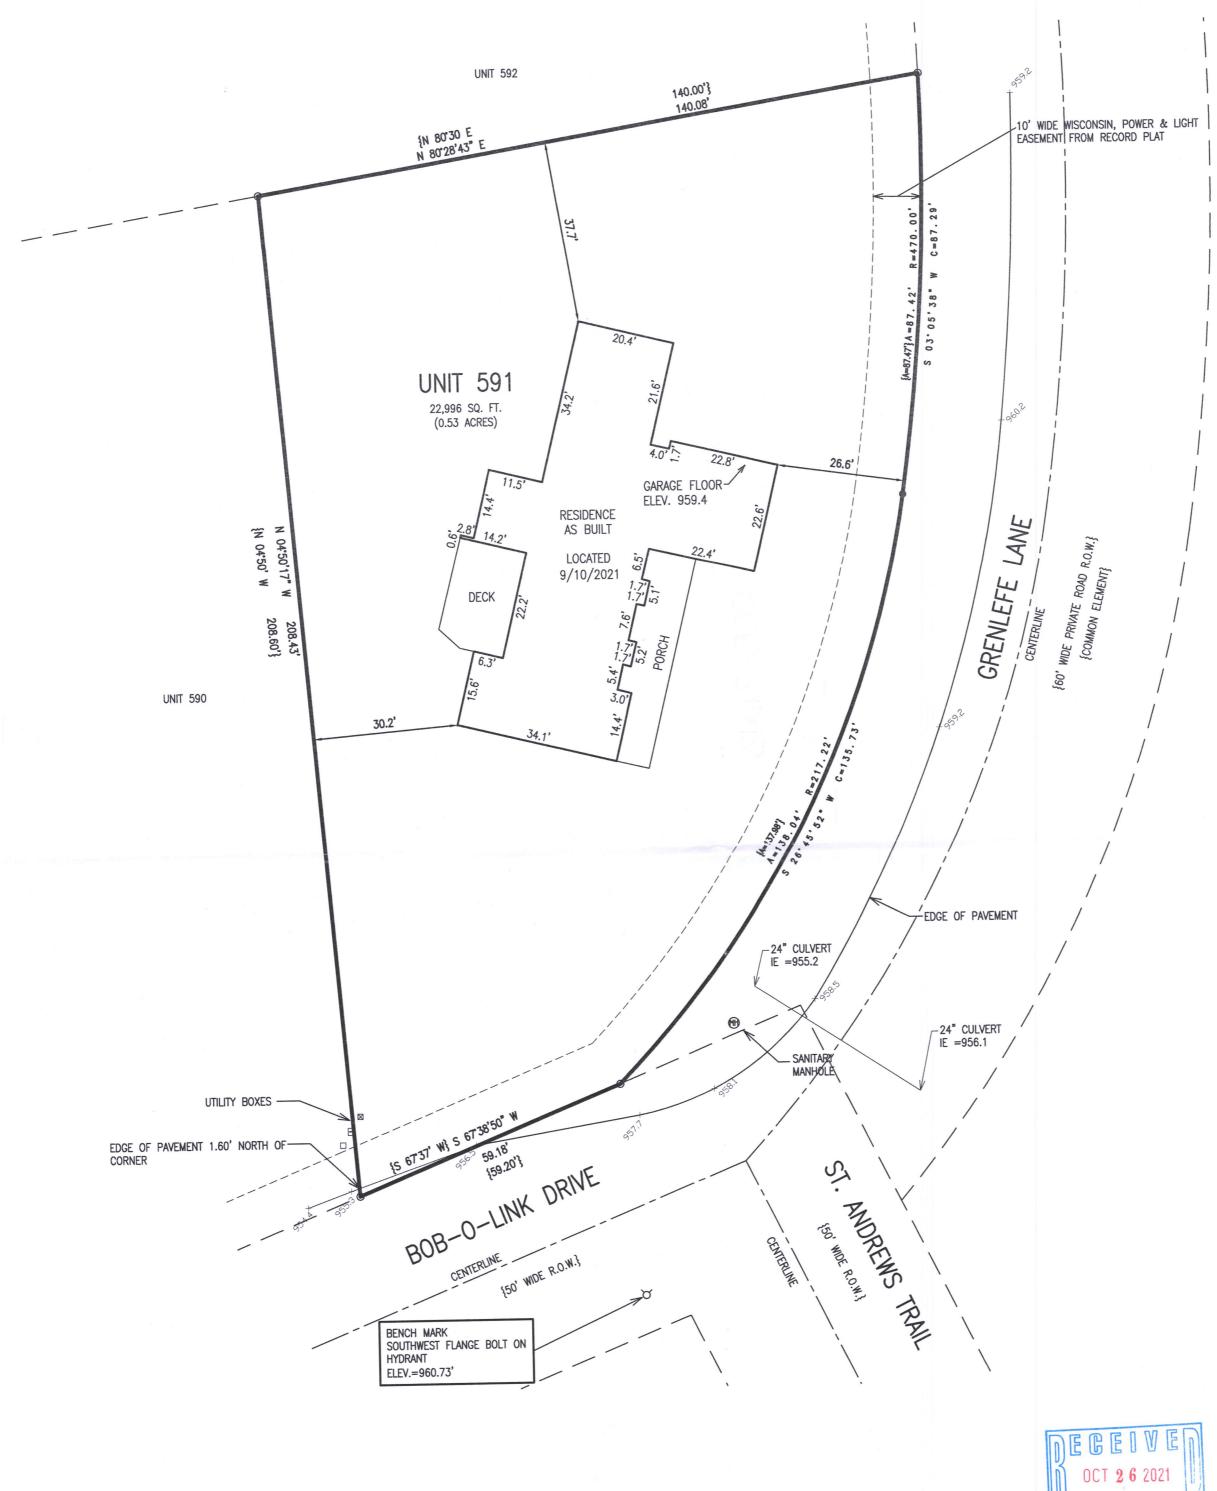

NOTE: COPIES OF THIS MAP TO WHICH THE FOLLOWING CERTIFICATE WILL APPLY SHOW THE SURVEYOR'S ORIGINAL SEAL AND SIGNATURE IN RED INK. COPIES BY ANY OTHER MEANS MAY HAVE ALTERATIONS WHICH DO NOT REPRESENT THE SURVEYOR'S WORK PRODUCT.

I HEREBY CERTIFY THAT THE ABOVE DESCRIBED PROPERTY HAS BEEN SURVEYED UNDER MY DIRECTION AND THAT THE ABOVE MAP IS A TRUE REPRESENTATION THEREOF AND SHOWS THE SIZE AND LOCATION OF THE PROPERTY AND ITS EXTERIOR BOUNDARIES. THIS SURVEY IS MADE FOR THE USE OF THE PRESENT OWNERS OF THE PROPERTY, AND ALSO THOSE WHO PURCHASE, MORTGAGE, OR GUARANTEE THE TITLE THERETO WITHIN ONE YEAR FROM THE DATE HEREOF.

4/29/2021

REVISED 10/14/2021 TO SHOW RESIDENCE AS BUILT.

CHRISTOPHER A. HODGES P.L.S. S-2760

1013-59

LEGEND

= FOUND IRON PIPE STAKE  $\{XXX\}$  = RECORDED AS

591 BEARS W RECORD WEST LINE OF UNIT 8 N 04'50'17" 1 PER SURVEY OF F

9467.21

DATE:

1 OF 1

MAP SCALE IN FEET - ORIGINAL 1"=20'



DATED:

PLAT OF SURVEY SITE, GRADING, DRAINAGE, & EROSION CONTROL PLAN

FARRIS, HANSEN & ASSOCIATES, INC.

ENGINEERING - ARCHITECTURE - SURVEYING RIDGWAY COURT P.O. BOX 437 ELKHORN, WISCONSIN 53121 7 RIDGWAY COURT OFFICE: (262) 723-2098 FAX: (262) 723-5886 - WORK ORDERED BY -ED SALOGA 448 COURTNEY CIR SUGAR GROVE, IL 60554

PROJECT NO. **REVISIONS** 02/26/2021 SHEET NO.