


HAROLD H. KOLB

REGISTERED PROFESSIONAL LAND SURVEYOR
LAKE GENEVA, WISCONSIN

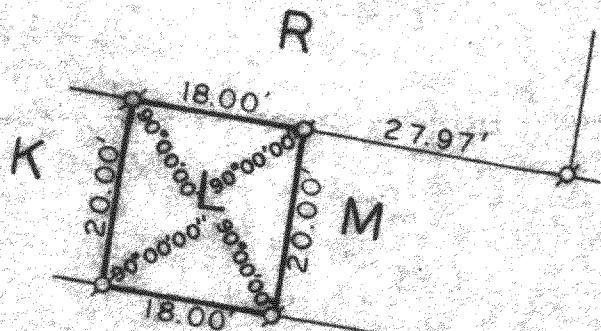

SCALE 1" = 20'

PLAT OF SURVEY OF

Lot "L" and Garage Lot "L", of the
Garden's Second Addition, a subdivision
located in the Village of Fontana-on-
Geneva Lake, Walworth County, Wisconsin.

NOTE: 1" iron pipe set by
William Child, surveyor,
in 1924.

Accuracy: Distances -- $\pm 0.01'$
Angles -- $\pm 05''$
Error of Closure - Less than
1/5000


FOUND CONCRETE MONUMENT

10' WIDE PATH

PRIVATE ROAD
20' WIDE

SET IRON PIPE ON LINE BETWEEN
CONC. MONUMENT AND 1" IRON PIPE

FOUND 1" IRON PIPE

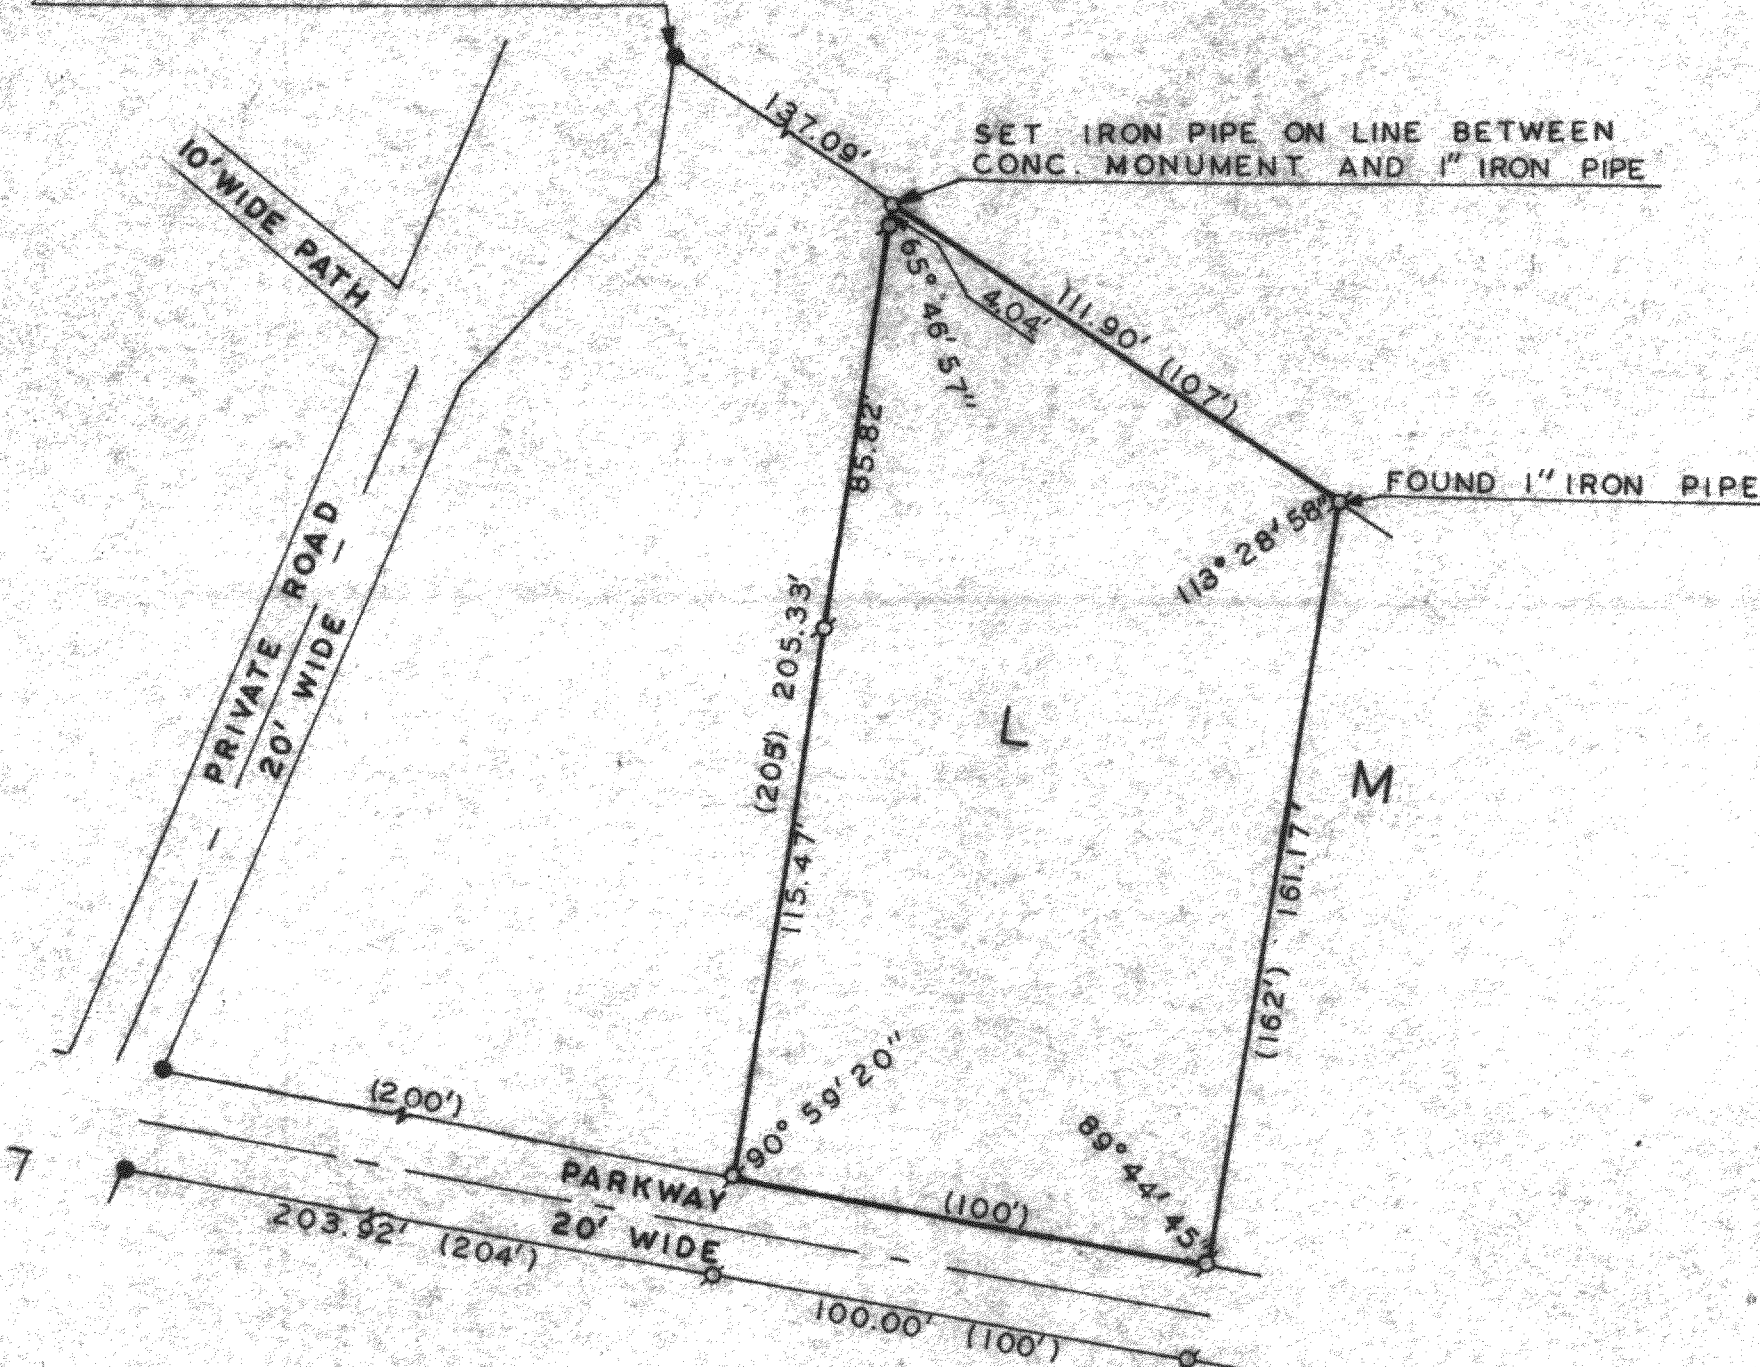

Owner: Bernard P. Kaufmann

Ordered by: Conroy Realty Co.


N



SCALE 1" = 40'

LEGEND

- - IRON PIPE FOUND
- - IRON PIPE PLACED
- - CONCRETE MONUMENT
- x - SPIKE
- () - PLATTED AS

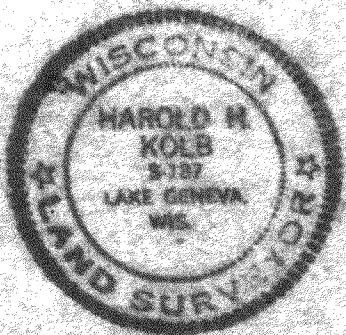

I, HAROLD H. KOLB, DO HEREBY CERTIFY THAT I HAVE
SURVEYED THE PROPERTY HEREON DESCRIBED ACCORDING
TO THE OFFICIAL RECORDS, AND THAT THE PLAT HEREON
IS A CORRECT REPRESENTATION OF THE LOT LINES.

Harold H. Kolb
HAROLD H. KOLB

WISCONSIN REGISTERED LAND SURVEYOR, S-187
DATE Aug 2, 1974

Revised: August 21, 1974

SGA-11

5-378