


DUNHAM & RASMUSSEN
SURVEYING & ENGINEERING
DELAVER, WISCONSIN

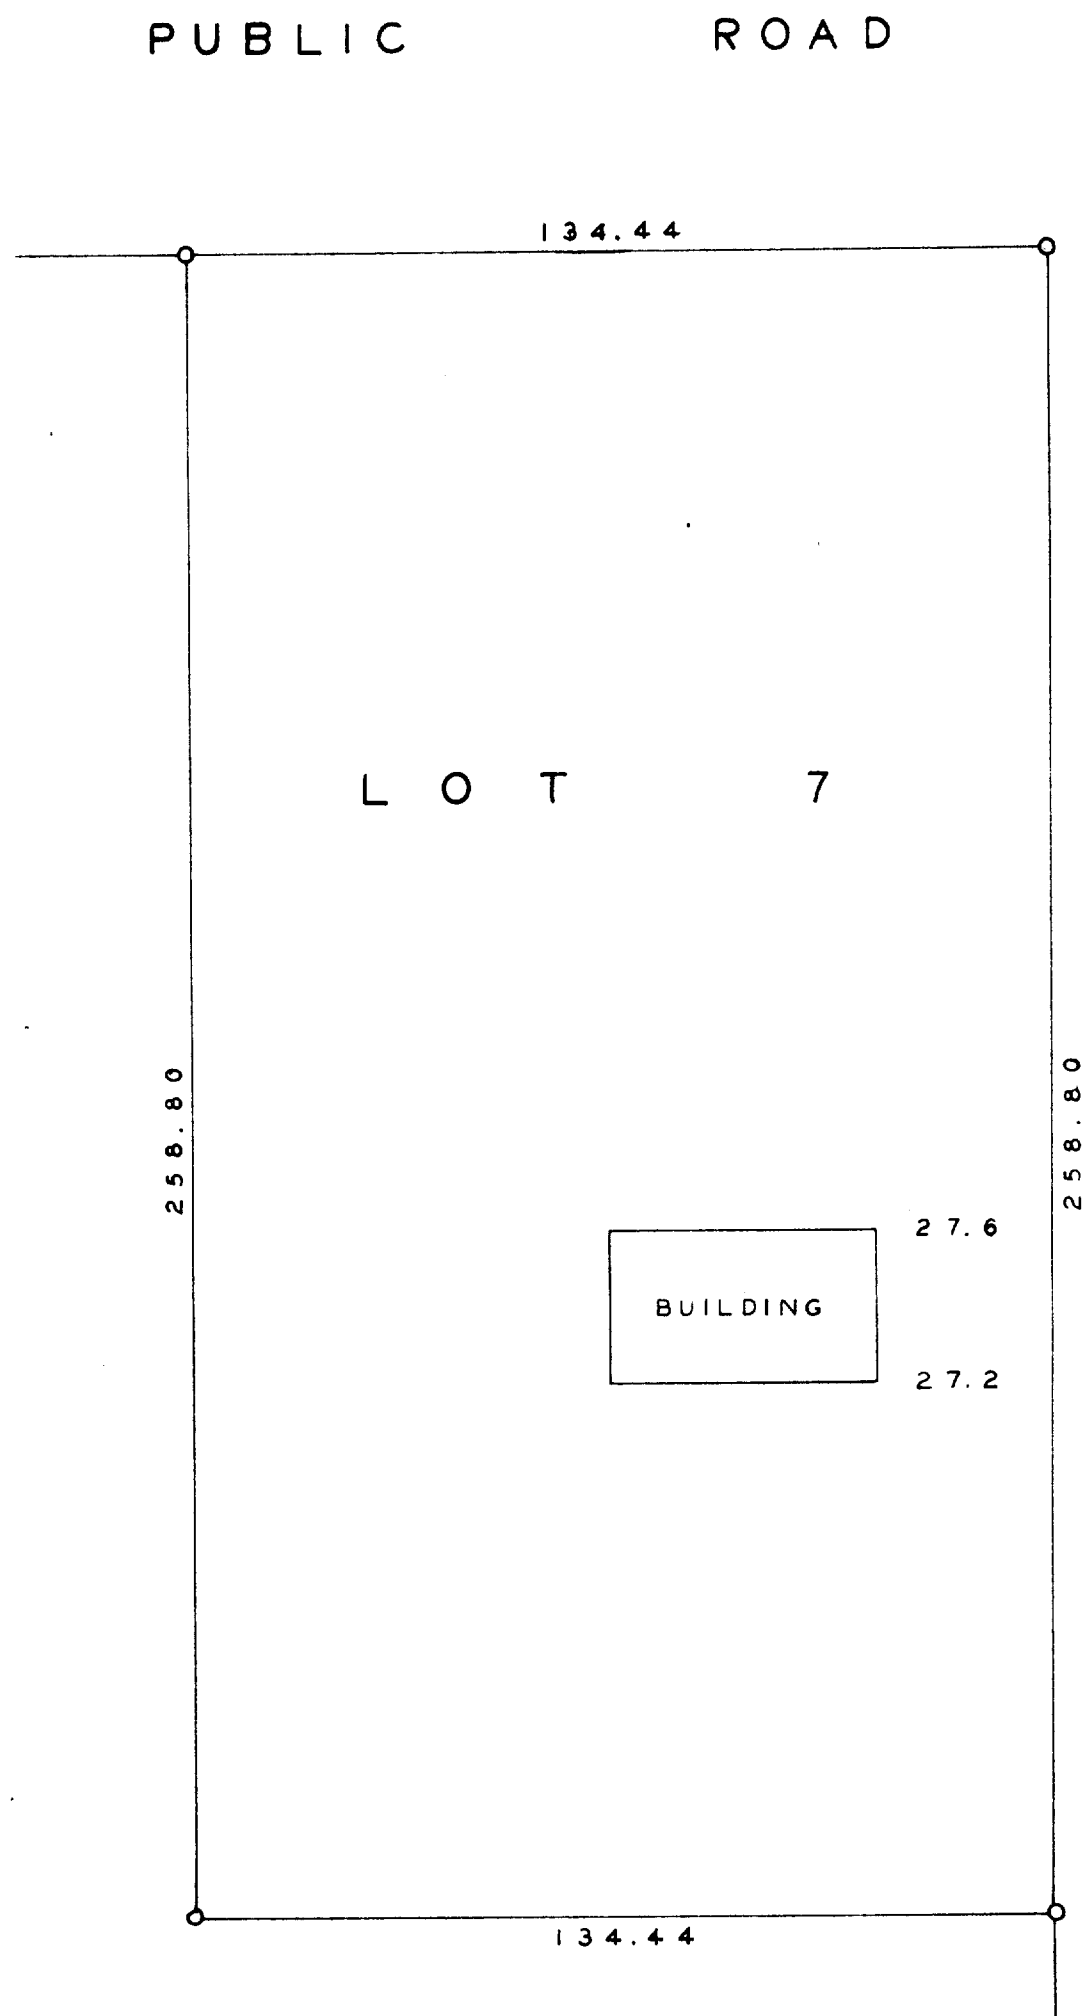

SCALE 1"=30'
O=IRON PIPE

Blk 3
Plat of survey of lot 7 in Brookwood Subdivision, Village
of Fontana, Walworth County, Wisconsin.

June 13, 1960

George T. Dunham
George T. Dunham, Surveyor