


# HAROLD H. KOLB

REGISTERED PROFESSIONAL LAND SURVEYOR  
LAKE GENEVA, WISCONSIN

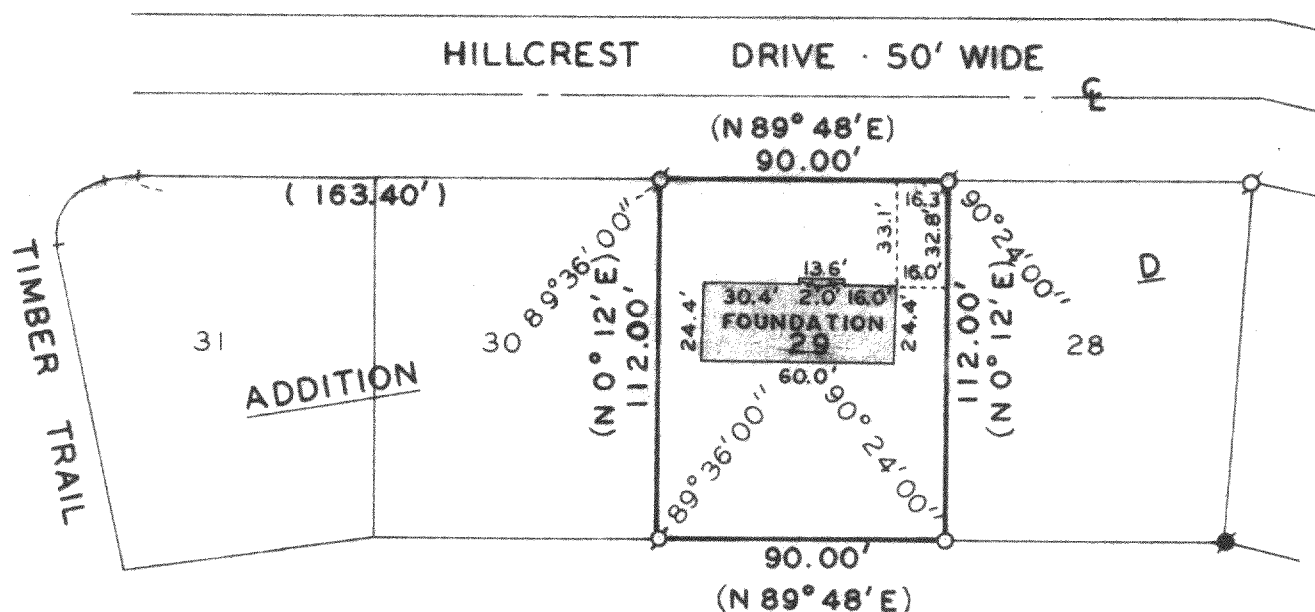

## PLAT OF SURVEY OF

Lot 29, Addition D, Country Club Estates,  
Village of Fontana-on-Geneva Lake, Wal-  
worth County, Wisconsin.

OWNER: David Denton

ACCURACY: Distances  $\pm 0.01'$   
Angles  $\pm 05''$   
Error of closure less  
than  $1/3000$


N



SCALE: 1" = 60'

## LEGEND

- φ — IRON PIPE FOUND
- — IRON PIPE PLACED
- — CONCRETE MONUMENT
- x — SPIKE
- ( ) — Platted As

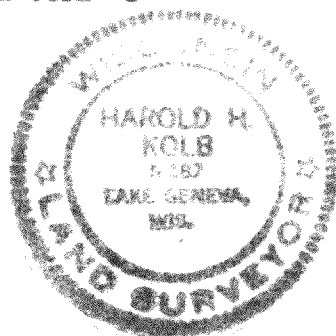

I, HAROLD H. KOLB, DO HEREBY CERTIFY THAT I HAVE  
SURVEYED THE PROPERTY HEREON DESCRIBED ACCORDING  
TO THE OFFICIAL RECORDS, AND THAT THE PLAT HEREON  
IS A CORRECT REPRESENTATION OF THE LOT LINES.

*Harold H. Kolb*  
HAROLD H. KOLB  
WISCONSIN REGISTERED LAND SURVEYOR, S-187  
DATE Sept. 11, 1979

Revised; December 12, 1974

5-382

SCD-30