

HAROLD H. KOLB

REGISTERED PROFESSIONAL LAND SURVEYOR
LAKE GENEVA, WISCONSIN

Plat of Survey of


Lot 3, Block 1, Brookwood Subdivision,
T 1 N, R 17 E, Walworth County, Wisconsin

ACCURACY: Angles $\pm 05''$

Distances $\pm 0.01'$

Error of Closure---
less than 1/3000

OWNER: Freeman Kemmerer

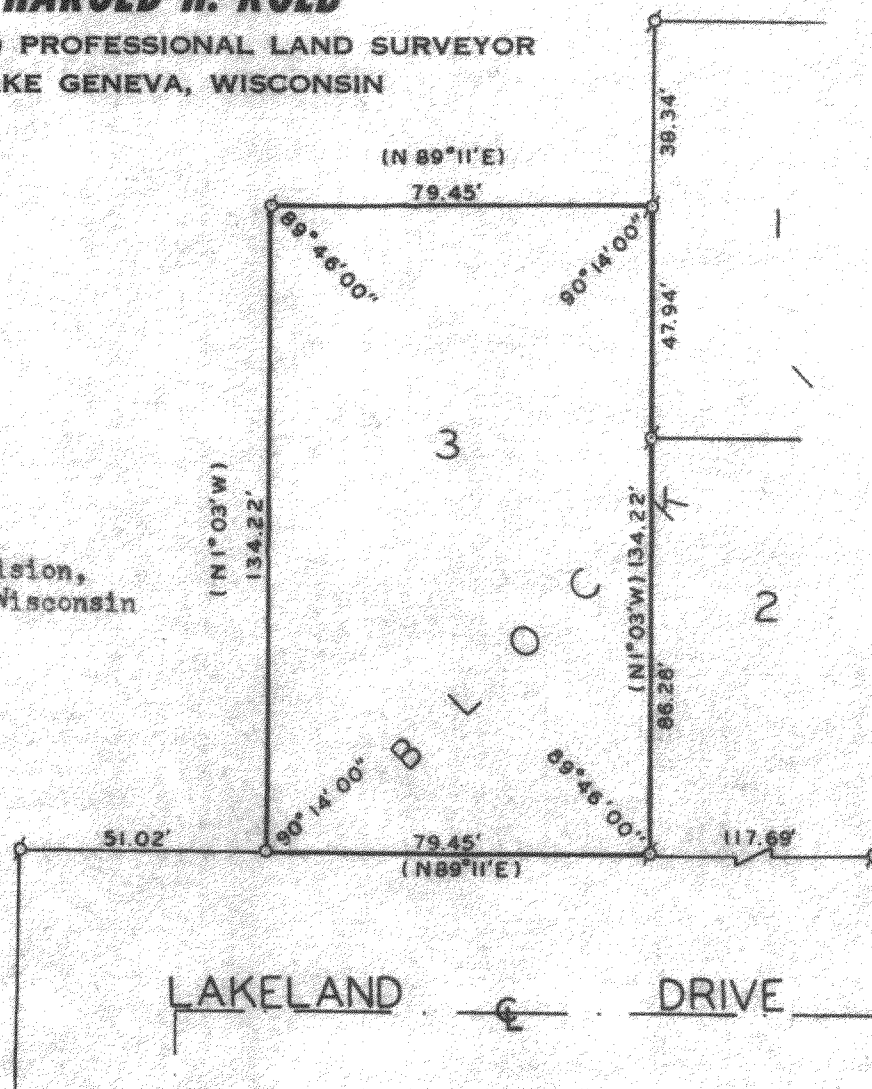

N




SCALE: 1" = 40'

LEGEND

- phi - IRON PIPE FOUND
- O - IRON PIPE PLACED
- - CONCRETE MONUMENT
- x - SPIKE

() - As Platted

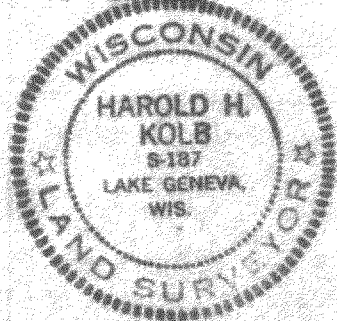

I, HAROLD H. KOLB, DO HEREBY CERTIFY THAT I HAVE
SURVEYED THE PROPERTY HEREON DESCRIBED ACCORDING
TO THE OFFICIAL RECORDS, AND THAT THE PLAT HEREON
IS A CORRECT REPRESENTATION OF THE LOT LINES.

Harold H. Kolb

HAROLD H. KOLB
WISCONSIN REGISTERED LAND SURVEYOR, S-187

DATE Nov. 6, 1974

5-385

~~117-464~~

SBS-3