
HAROLD H. KOLB

REGISTERED PROFESSIONAL LAND SURVEYOR LAKE GENEVA, WISCONSIN

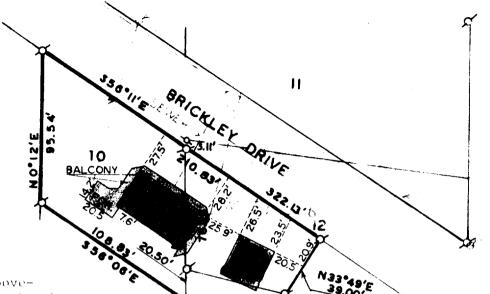

I have surveyed the abovedescribed property and the above map is a true representation thereof and shows the size and location of the property, its w exterior boundaries, the location and dimensions of all structures thereon, fences, apparent casements and roadways and visible encroachments, if any.

This survey is made for the use of the present owners of the property, and also those who purchase, mortgage, or guarantee the title thereto within one (1) year from date hereof. Harold H. Kolb

March 21, 1975

Committee of the committee.



14. 3° SEVER 36 egan of the 10,12, and 13, Addition 0. to Donor Diam estates, sillar Fontar amora choosed gake, Autoor

SCALE 1"= 60'

LEGEND

Ø + IRON PIPE FOUND

O - IRON PIPE PLACED

• - CONCRETE MONUMENT

X - SPIKE

Undergrawid

AWARREST ROBERT ROBERT

13

NOTE: Underground utility locations are approximate from owners testimony.

I, HAROLD H. KOLB, DO HEREBY CERTIFY THAT I HAVE SURVEYED THE PROPERTY HEREON DESCRIBED ACCORDING TO THE OFFICIAL RECORDS, AND THAT THE PLAT HEREON IS A CORRECT REPRESENTATION OF THE LOT LINES.

HAROLD H. KOLB WISCONSIN REGISTERED LAND SURVEYOR, S-187

KEVISED: March 21, 1975 Revised:

WOODLAND