
HAROLD H. KOLB

REGISTERED PROFESSIONAL LAND SURVEYOR LAKE GENEVA, WISCONSIN

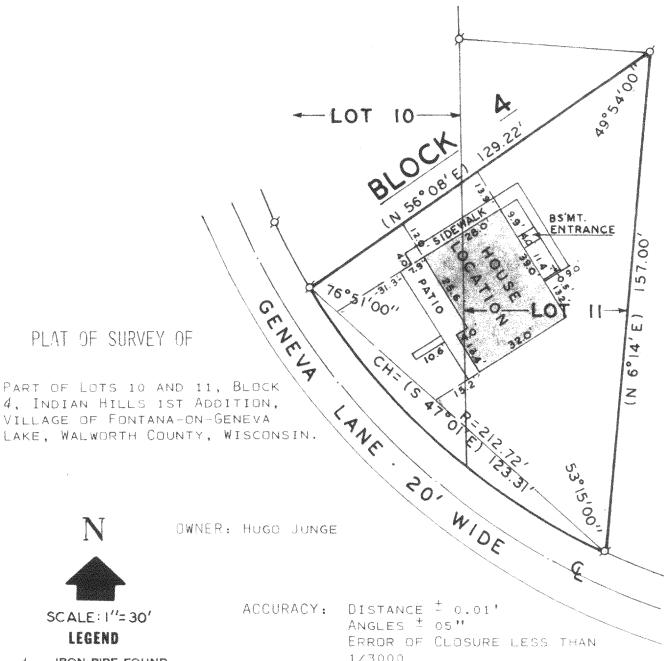

LEGEND

SCALE: 1"= 30"

- IRON PIPE FOUND

- IRON PIPE PLACED

• - CONCRETE MONUMENT

X - SPIKE

() - RECORDED AS



1/3000

I. HAROLD H. KOLB, DO HEREBY CERTIFY THAT I HAVE SURVEYED THE PROPERTY HEREON DESCRIBED ACCORDING TO THE OFFICIAL RECORDS, AND THAT THE PLAT HEREON IS A CORRECT REPRESENTATION OF THE LOT LINES.

HAROLD H. KOLB WISCONSIN REGISTERED LAND SURVEYOR, S-187

DATE SEPTEMBER 4, 1975