


HAROLD H. KOLB

REGISTERED PROFESSIONAL LAND SURVEYOR
LAKE GENEVA, WISCONSIN

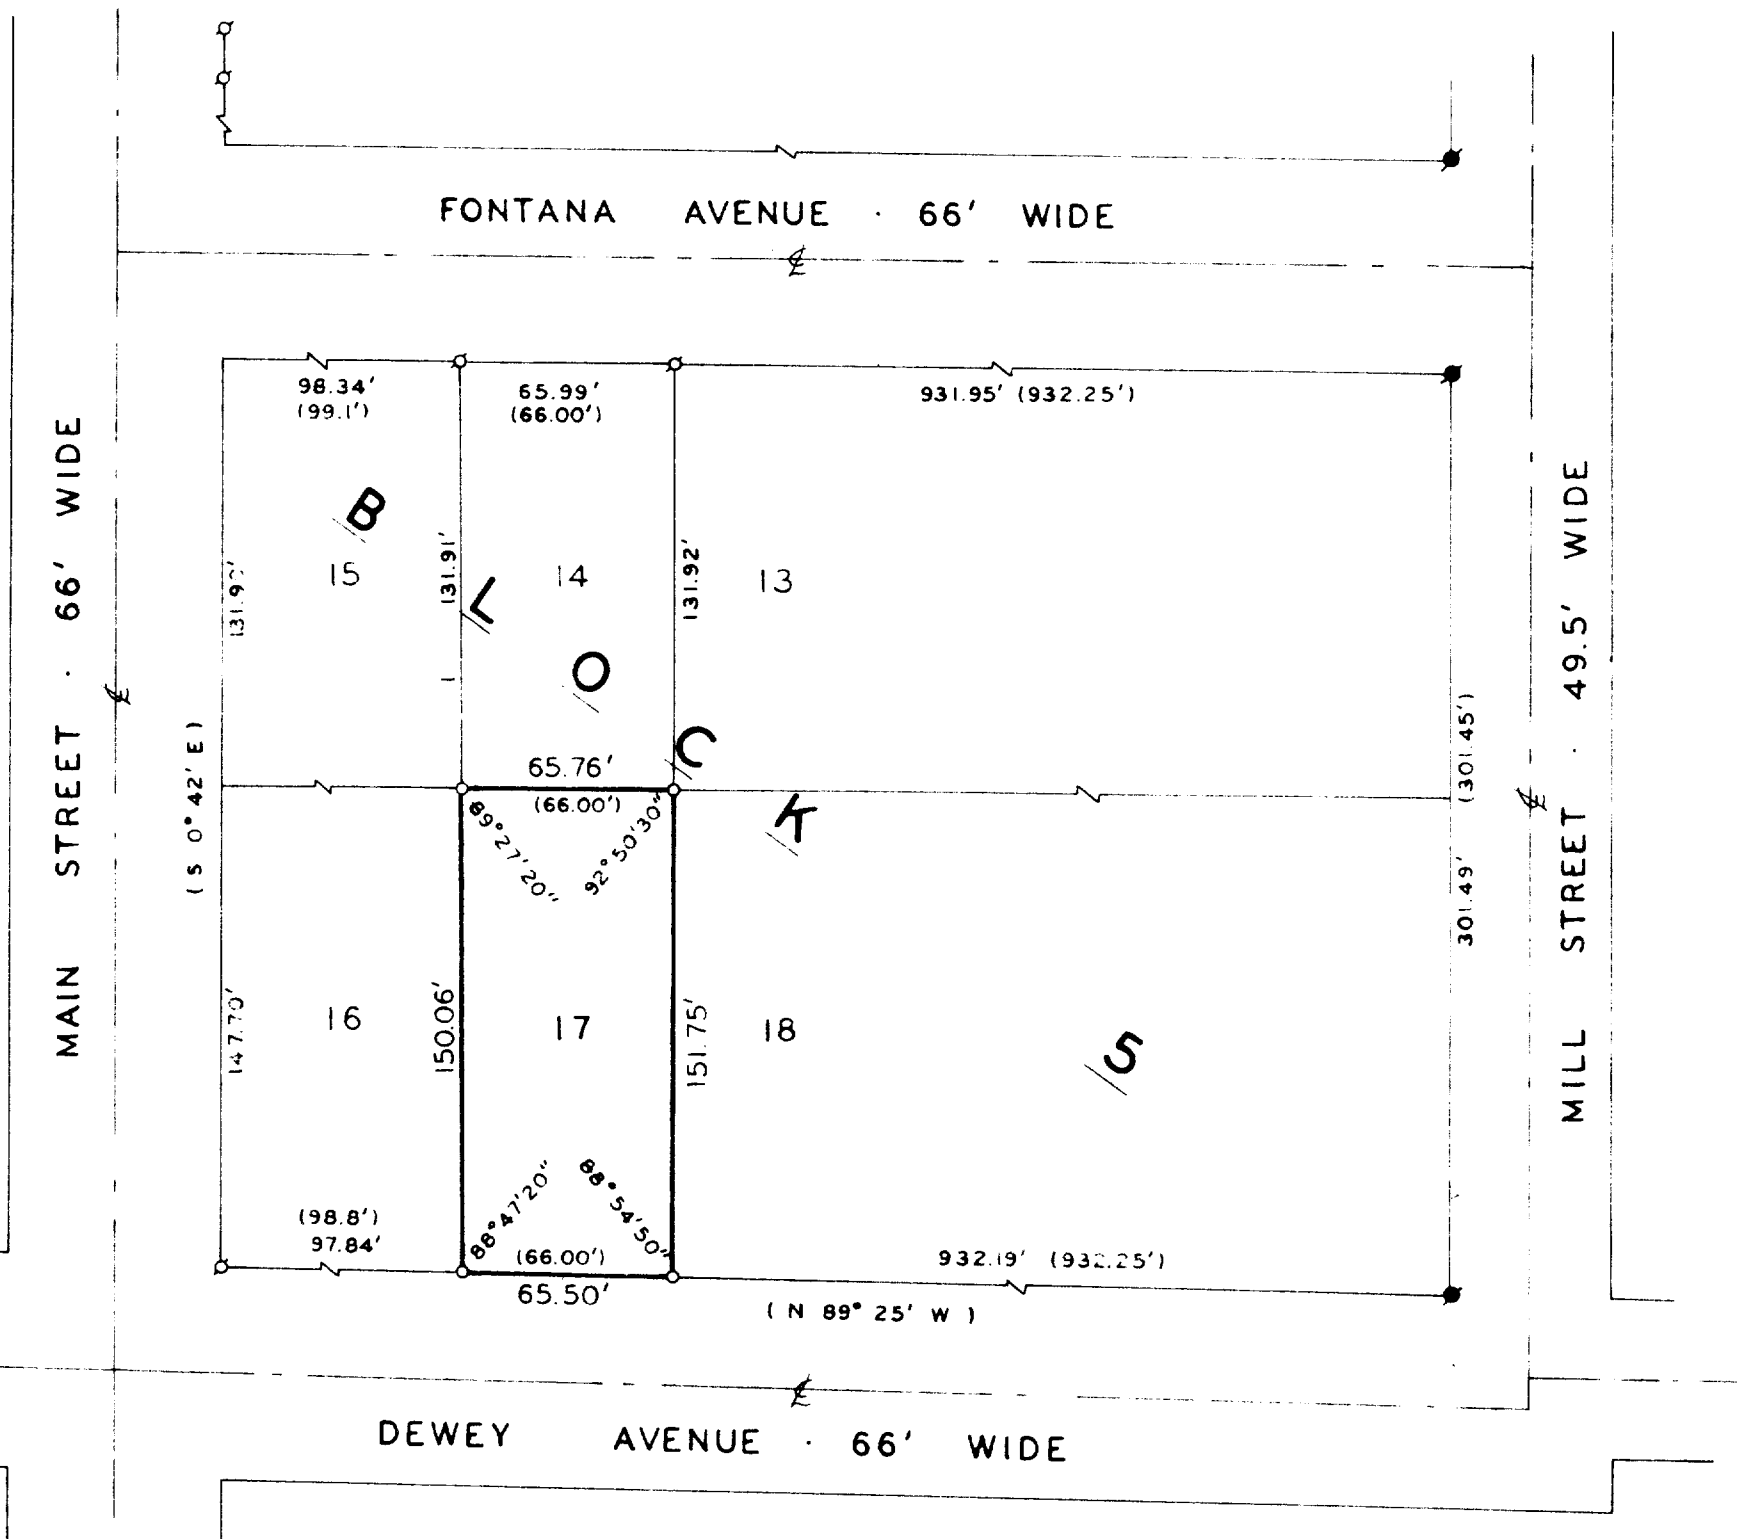

PLAT OF SURVEY OF

LOT 17, BLOCK 5, L. L. DOUGLAS ADDITION, VILLAGE OF FONTANA ON-
GENEVA LAKE, WALWORTH COUNTY, WISCONSIN.

ACCURACY: DISTANCE $\pm 0.01'$
ANGLES $\pm 25''$
ERROR OF CLOSURE LESS THAN $1/3000$

OWNER: ROBERT NELSON

N



SCALE: 1" = 60'

LEGEND

- φ - IRON PIPE FOUND
- O - IRON PIPE PLACED
- - CONCRETE MONUMENT FOUND
- x - SPIKE
- () - PLATTED AS



I, HAROLD H. KOLB, DO HEREBY CERTIFY THAT I HAVE
SURVEYED THE PROPERTY HEREON DESCRIBED ACCORDING
TO THE OFFICIAL RECORDS AND THAT THE PLAT HEREON
IS A CORRECT REPRESENTATION OF THE LOT LINES

HAROLD H. KOLB
WISCONSIN REGISTERED LAND SURVEYOR, S-197
DATE Nov. 12, 1975

STF V-242A

5-418