


PLAT OF SURVEY

OF

UNIT 8 OF ABBEY SPRINGS

A parcel of land located in the South $\frac{1}{2}$ of Section 13, T1N R16E, Village of Fontana-on-Geneva Lake, Walworth County, Wisconsin, described as follows to wit:

Beginning at the most Easterly corner of Unit 7 of Abbey Springs; thence S71°-40'E 18.00 feet; thence S19°-17'W 226.62 feet; thence N44°-53'E 285.54 feet to the place of beginning, containing 0.5066 acres of land more or less.

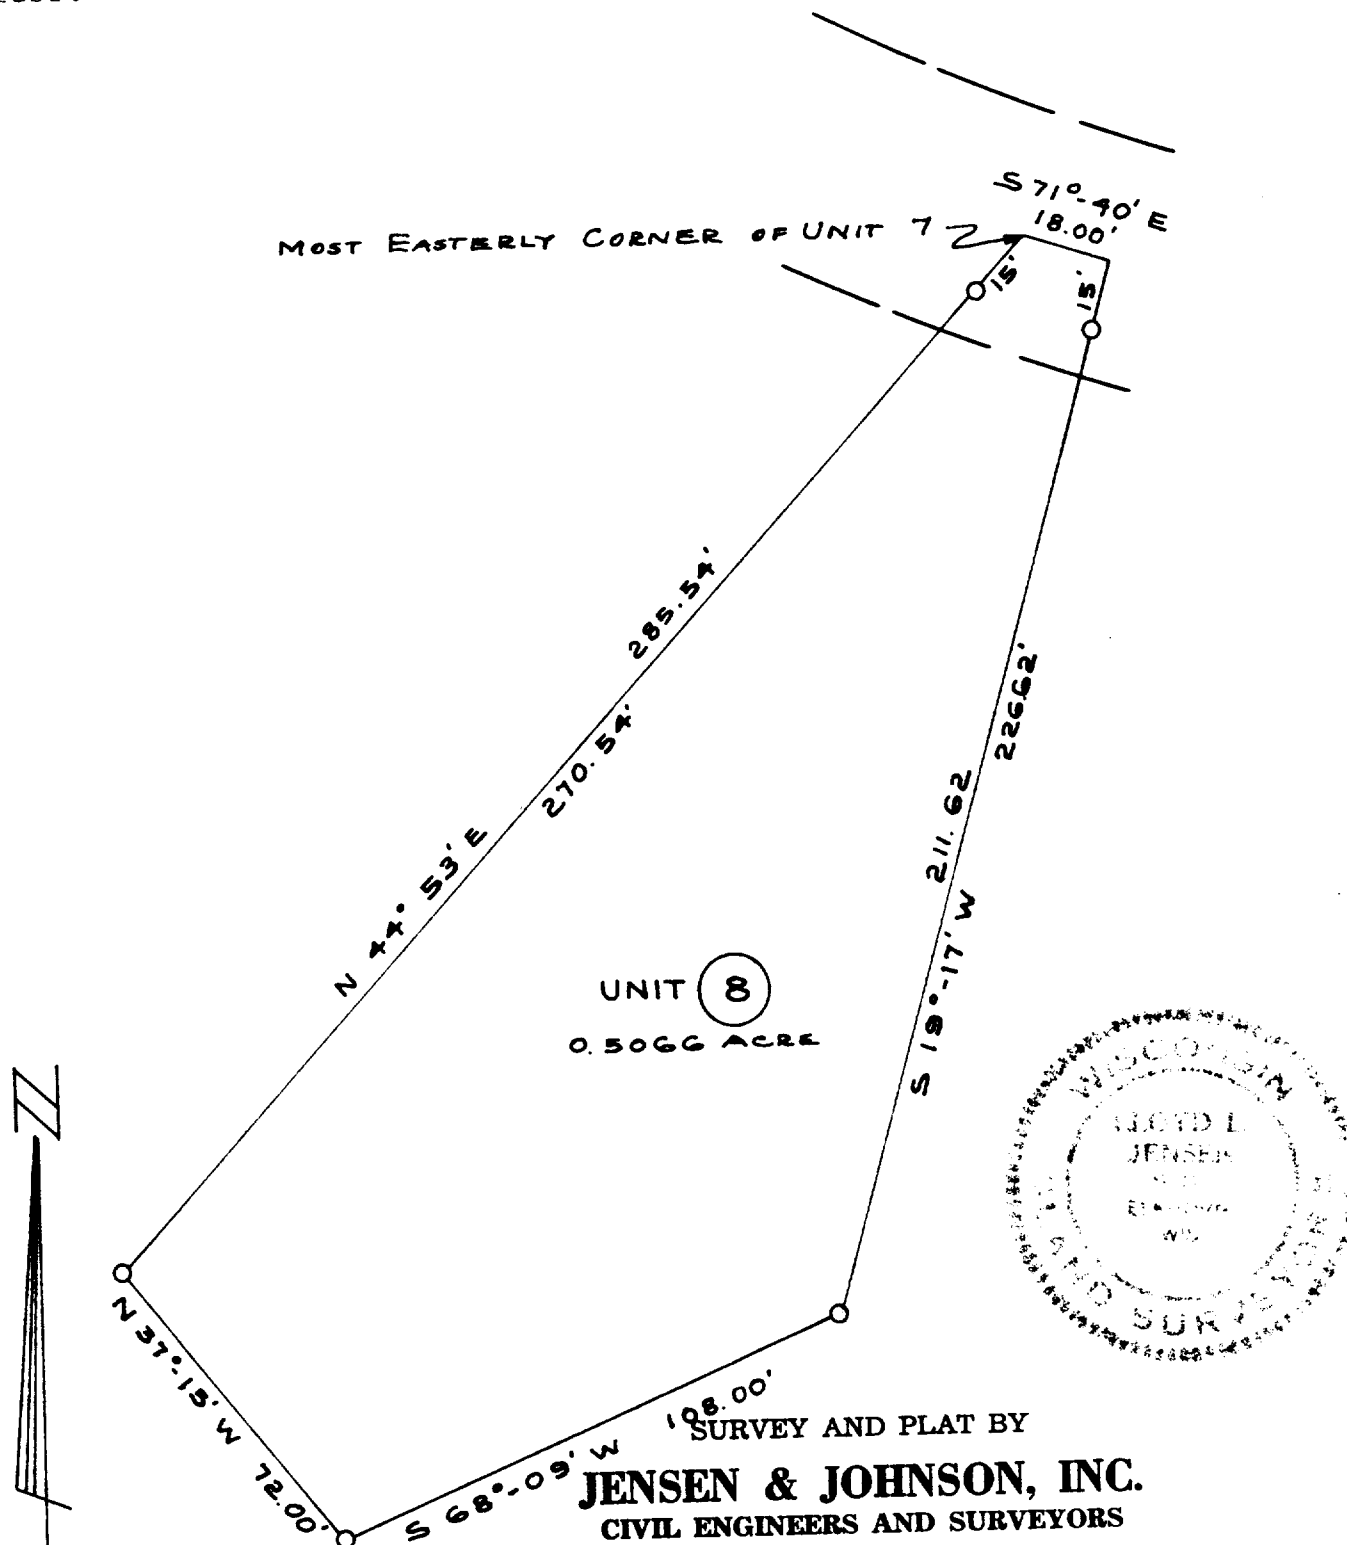

LEGEND

- — Iron Pipe SET
- — Concrete Monument
- Scale 1" = 40'

WE CERTIFY: That we have surveyed the above described property and that the plat shown hereon is an accurate survey and a true representation thereof and correctly shows the exterior boundary lines and all divisions of said property.

Date AUG 1971

Lloyd L. Jensen
 LLOYD L. JENSEN,
 Wisconsin Registered Land Surveyor, No. S-211

5-459.8