


MORTGAGE INSPECTION SURVEY

LOT 10 AND THE SOUTH 20 FEET OF LOT 9 OF BLOCK 5 OF INDIAN HILLS,
VILLAGE OF FONTANA - ON - GENEVA LAKE, WALWORTH COUNTY, WISCONSIN

NOTE: This is not a "Property Survey" as defined in
Chapter A-E 5.01 of the Wisconsin Admin-
istrative Code.

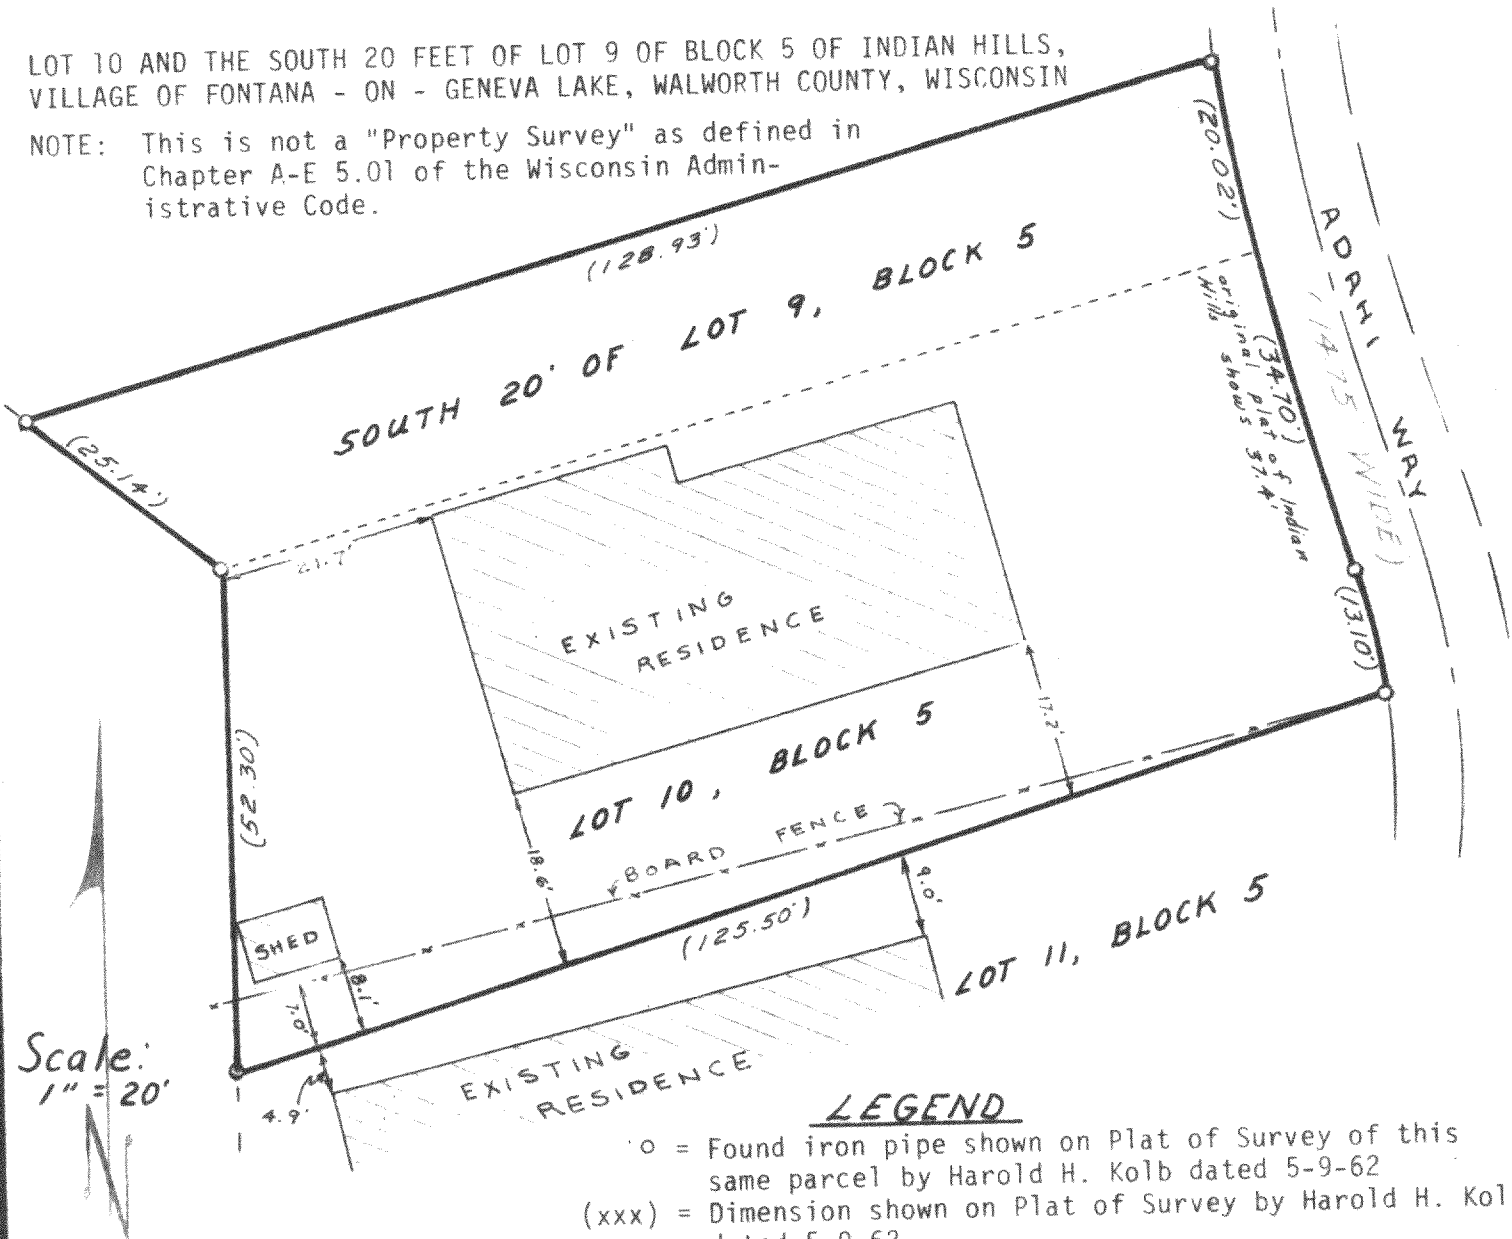


LEGEND

- o = Found iron pipe shown on Plat of Survey of this same parcel by Harold H. Kolb dated 5-9-62
- (xxx) = Dimension shown on Plat of Survey by Harold H. Kolb dated 5-9-62

BUYERS: David C. & Lynn G. Jensen
SELLERS: John B. & Angeline M. Gemmell
WORK ORDERED BY: Sandra J. Butler for
WAUKESHA SAVINGS & LOAN ASSOCIATION
East Troy Office

I HEREBY CERTIFY that this map is a true and accurate representation of the lot lines as found to be monumented, and of the buildings located thereon to the best of my knowledge and belief.

Robert A. Farris
ROBERT A. FARRIS RLS
DATED THIS 26 DAY OF June 1978

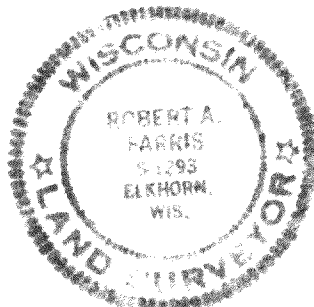

FARRIS, HANSEN & COOPER, INC.

715 W. WALWORTH AVE., P.O. BOX 467
ELKHORN, WIS. 53121
TELEPHONE: 412-2096

DRAWING NO. 1348

5-518

514-72