




SCALE 1" = 50'
○ = IRON PIPE
● = CONC. MONU.

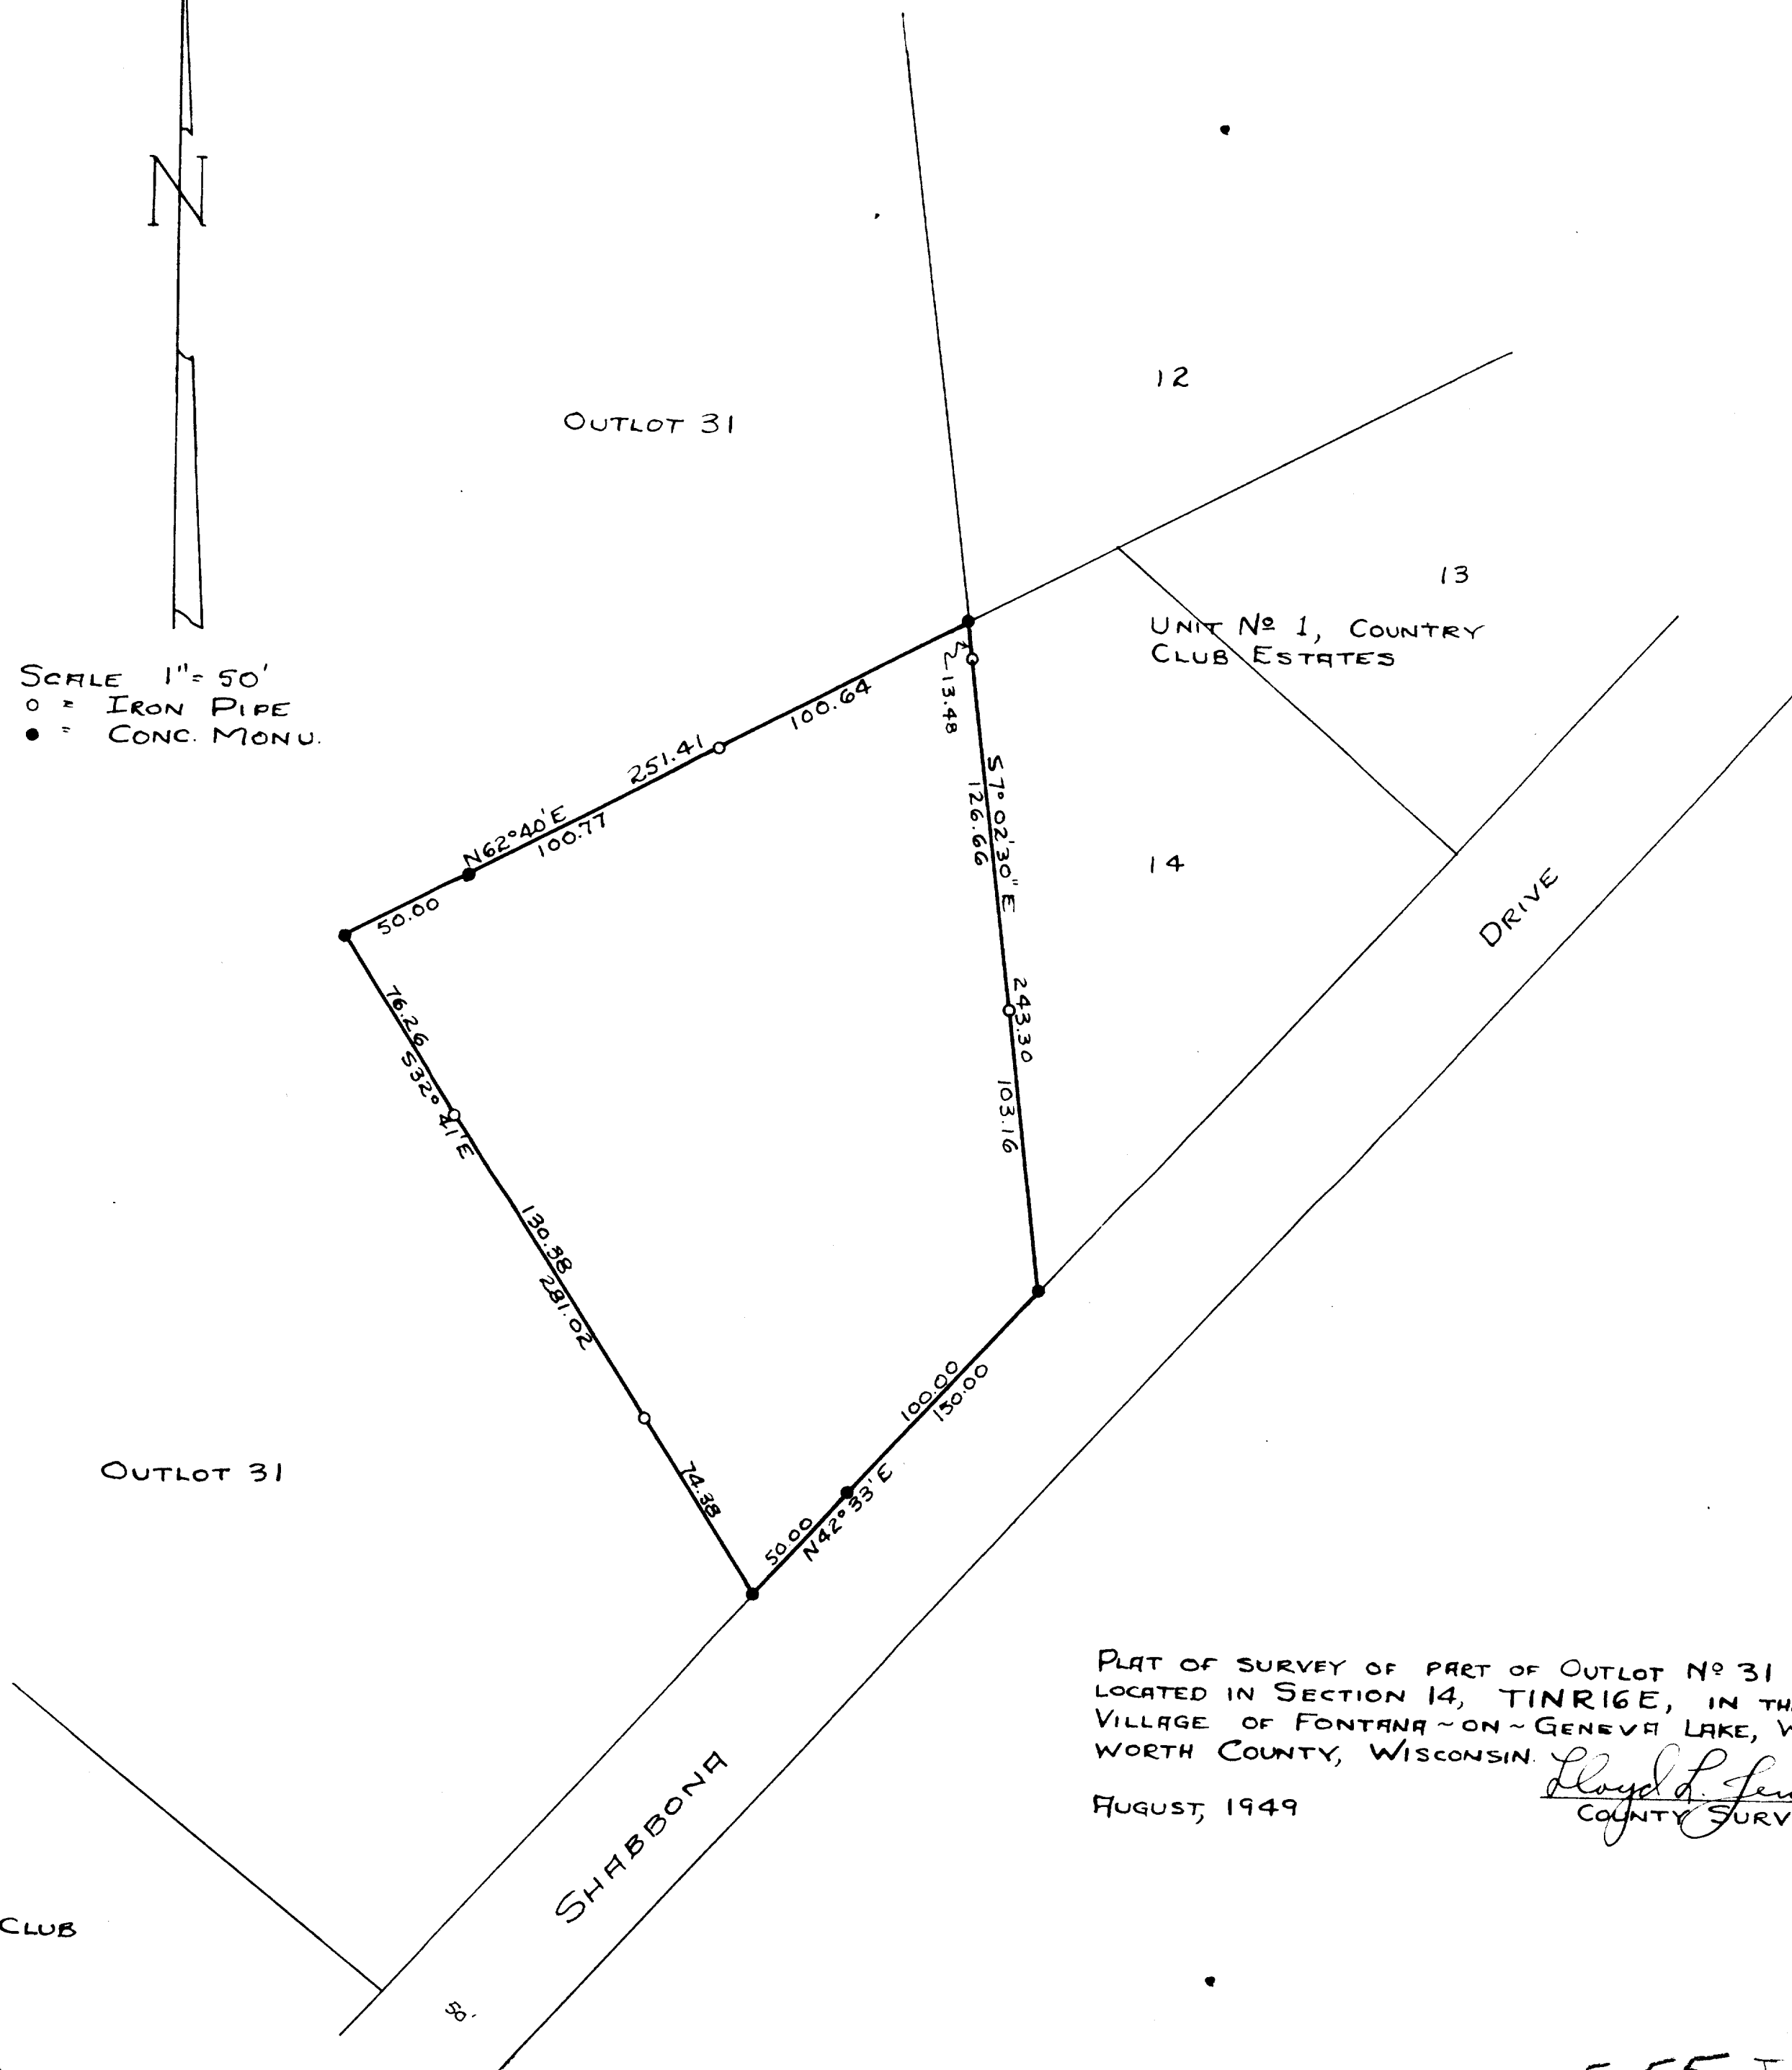

PLAT OF SURVEY OF PART OF OUTLOT No 31
LOCATED IN SECTION 14, T19R16E, IN THE
VILLAGE OF FONTANA - ON - GENEVA LAKE, WAL-
WORTH COUNTY, WISCONSIN.

AUGUST, 1949

Lloyd L. Jensen
COUNTY SURVEYOR

BIG FOOT
COUNTRY CLUB

STFR-50

5-55 J